

PROJECT TEAM

ARCHITECT
 [REDACTED]
 [REDACTED]
 [REDACTED]

OWNER
 [REDACTED]
 [REDACTED]
 [REDACTED]

CIVIL ENGINEER
 [REDACTED]
 [REDACTED]
 [REDACTED]

STRUCTURAL ENGINEER
 [REDACTED]
 [REDACTED]
 [REDACTED]

ENERGY CONSULTANT
 [REDACTED]
 [REDACTED]
 [REDACTED]

DRAWING INDEX

T.1	TITLE SHEET
SP.1	ARCHITECTURAL SPECIFICATIONS
SP.2	ARCHITECTURAL SPECIFICATIONS
CG.1	CALGREEN FORMS
CG.2	CALGREEN FORMS
EN1	TITLE 24-PLAN A
EN2	TITLE 24-PLAN A
EN3	TITLE 24-PLAN B
EN4	TITLE 24-PLAN B
A.C.	SITE PLAN

ARCHITECTURAL DRAWINGS

A1.01	GROUND AND FIRST FLOOR PLANS
A1.02	SECOND FLOOR & ROOF PLANS
A1.03	EXTERIOR ELEVATIONS - 'A'
A1.04	EXTERIOR ELEVATIONS - 'B'
A1.05	SECTIONS AND INTERIOR ELEVATIONS
A1.06	EMP FLOOR PLANS

ARCHITECTURAL DETAILS

AD.1	ARCHITECTURAL DETAILS
AD.2	ARCHITECTURAL DETAILS
AD.3	ARCHITECTURAL DETAILS
AD.4	ARCHITECTURAL DETAILS
AD.5	ARCHITECTURAL DETAILS
AD.6	ARCHITECTURAL DETAILS
AD.7	ARCHITECTURAL DETAILS
AD.8	ARCHITECTURAL DETAILS
AD.9	ARCHITECTURAL DETAILS

STRUCTURAL DETAILS

SN	STRUCTURAL NOTES AND NAILING SCHEDULE
S1	STRUCTURAL PLANS
S2	STRUCTURAL PLANS
S3	STRUCTURAL PLANS
S4	STRUCTURAL PLANS
SD1	TRANSFER DETAILS
SD2	STANDARD SHEARWALL AND MISC DETAILS
SD3	FRAMING DETAILS
SD3	ADDITION FND DETAILS

CAL GREEN NOTES

- A COMPREHENSIVE BUILDING MANUAL TO BE PLACED IN BUILDING. CAL GREEN 4.410.1
- INDOOR WATER USE PER CAL GREEN 4.303.1

FIXTURE TYPE: MAX. FLOW RATE:

SHOWERHEADS	2 gpm @ 80 psi
LAVATORY FAUCETS, RESIDENTIAL	1.5 gpm @ 80 psi
KITCHEN FAUCETS	1.8 gpm @ 80 psi
WATER CLOSETS, TYP.	1.28 gallons/flush

- INSTALLED AUTOMATIC IRRIGATION CONTROLLERS TO CONFORM TO CAL GREEN 4.304.1
- ANNULAR SPACES AROUND PIPES, ELECTRIC CABLES, CONDUITS OR OTHER OPENINGS IN SOLEBOLT OR PLATES AT EXTERIOR WALLS SHALL BE PROTECTED FROM THE PASSAGE OF RODENTS. CAL GREEN 4.406.1
- ALL DUCT OPENINGS AND MECHANICAL EQUIPMENT TO BE PROTECTED DURING CONSTRUCTION PER CAL GREEN 4.504.1
- ALL ADHESIVES, SEALANTS AND CAULKS TO COMPLY WITH CAL GREEN 4.504.2.1
- ALL PAINTS AND COATINGS TO COMPLY WITH CAL GREEN 4.504.2.2 & 4.504.2.3
- ALL FLOOR COVERINGS TO COMPLY WITH CAL GREEN 4.504.3, 4.504.4, & 4.504.5
- CONCRETE SLAB FOUNDATIONS REQUIRED TO HAVE A VAPOR RETARDER PER CBC SHALL ALSO COMPLY WITH CAL GREEN 4.505
- HOUSE SLAB TO BE DESIGNED BY PROFESSIONAL TO COMPLY WITH CAL GREEN 4.505.2.1 OR PROVIDE CAPILLARY BREAK PER 4.505.2.1
- WALL AND FLOOR FRAMING SHALL NOT BE ENCLOSED WHEN FRAMING MEMBERS EXCEED 19% MOISTURE CONTENT CAL GREEN 4.505.3
- BATHROOM EXHAUST FANS SHALL BE ENERGY STAR, DUCTED TO TERMINATE OUTSIDE THE BUILDING, & UNLESS FUNCTIONING AS A COMPONENT OF A WHOLE HOUSE VENTILATION SYSTEM, SHALL BE CONTROLLED BY A READILY ACCESSIBLE HUMIDISTAT COMPLYING WITH CAL GREEN 4.506.1
- DUCT SYSTEMS SHALL BE SIZED AND DESIGNED PER CAL GREEN 4.507.2
- MIN. OF 50% CONSTRUCTION WASTE SHALL BE DIVERTED TO RECYCLE OR SALVAGE, PER CAL GREEN 4.408.1
- ALL INSPECTIONS AND VERIFICATIONS TO BE PROVIDED PER CAL GREEN 102
- RECYCLE AND/OR SALVAGE FOR REUSE A MINIMUM OF 50% OF THE NON-HAZARDOUS CONSTRUCTION AND WASTE IN ACCORDANCE WITH EITHER SECTION 4.408.2, 4.408.3 OR 4.408.4, OR MEET A MORE STRINGENT LOCAL CONSTRUCTION AND DEMOLITION WASTE MANAGEMENT ORDINANCE.
- SUBMIT A CONSTRUCTION WASTE MANAGEMENT PLAN IN CONFORMANCE WITH ITEMS 1 THROUGH 5. THE CONSTRUCTION WASTE MANAGEMENT PLAN SHALL BE UPDATED AS NECESSARY AND SHALL BE AVAILABLE DURING CONSTRUCTION FOR EXAMINATION BY THE ENFORCING AGENCY.

NOTES

GENERAL NOTES

- ALL CONSTRUCTION SHALL EXCEED THE LATEST EDITION OF CODES ADOPTED BY THE LOCAL GOVERNING AGENCIES. THESE SHALL INCLUDE (BUT ARE NOT LIMITED TO): California Residential Code, California Energy Code, California Building Code, California Electric Code, California Plumbing Code, California Mechanical Code AND ALL OTHER HEALTH AND SAFETY CODES, ORDINANCES AND REQUIREMENTS ADOPTED BY THE GOVERNING AGENCIES.
- THESE PLANS ARE FOR GENERAL CONSTRUCTION PURPOSES ONLY. THEY ARE NOT EXHAUSTIVELY DETAILED NOR FULLY SPECIFIED. IT IS THE RESPONSIBILITY OF THE CONTRACTOR TO SELECT, VERIFY, RESOLVE, AND INSTALL ALL MATERIALS AND EQUIPMENT REQUIREMENTS ADOPTED BY THE GOVERNING AGENCIES.
- THE ARCHITECT WILL NOT BE OBSERVING THE CONSTRUCTION OF THIS PROJECT. THE CONTRACTOR IS SOLELY RESPONSIBLE FOR THE QUALITY CONTROL AND CONSTRUCTION STANDARDS FOR THIS PROJECT.
- THE SOILS REPORT FOR THIS PROJECT WAS PREPARED BY:
 GEOTECHNICAL CONSULTANTS
 Report No. PG-132, FEBRUARY 22, 2016
 THE CONTRACTOR SHALL BE SOLELY RESPONSIBLE FOR COMPLIANCE WITH ALL RECOMMENDATIONS OF THE SOILS REPORT FOR CONSTRUCTION, GRADING, AND FOUNDATION INSPECTION PRIOR TO THE COMMENCEMENT OF WORK. THE CONTRACTOR SHALL HAVE THE SOILS ENGINEER REVIEW AND APPROVE IN WRITING THAT THE FOUNDATION AND SITE DESIGN ARE IN CONFORMANCE WITH THE SOILS REPORT.
- THE WATER HEATER TEMPERATURE/PRESSURE RELIEF VALVE SHALL HAVE ATTACHED A PIPE WHICH WILL RUN OUTSIDE THE BUILDING WITH THE END OF THE PIPE BETWEEN 8 AND 24 INCHES ABOVE GRADE AND POINTED DOWN. (C.P.C. 608.5)
- CLEARANCES OF LISTED APPLIANCES FROM COMBUSTIBLE MATERIALS SHALL BE AS SPECIFIED IN THE LISTING. UNLISTED APPLIANCES CLEARANCES SHALL COMPLY WITH THE CALIFORNIA MECHANICAL CODE (CMC 2010).
- THE DOCUMENTS CONTAINED HEREIN HAVE BEEN PREPARED SPECIFICALLY FOR USE ON 377 ST. MARYS ST. ONLY. RE-USE OF THESE DOCUMENTS IN ANY WAY (MODIFIED OR UNMODIFIED, COMPLETE OR INCOMPLETE) TO CONSTRUCT IN A DIFFERENT LOCATION WITHOUT THE SIGNATURE OF ARCHITECT ON DOCUMENTS THAT ARCHITECT SPECIFICALLY PREPARES FOR AN ALTERNATE LOCATION SHALL BE AT FIRE/SIDE INVESTORS' SOLE RISK. ARCHITECT ASSUMES NO LIABILITY FOR THE UNAUTHORIZED RE-USE OF THESE DOCUMENTS.
- A SIX HEAD FIRE SPRINKLER SYSTEM AS APPROVED BY THE LIVERMORE/PLEASANTON FIRE DEPARTMENT IS REQUIRED TO BE INSTALLED IN THIS RESIDENCE. PLANS TO BE SUBMITTED TO THE BUILDING DEPT. FOR REVIEW. QUESTIONS REGARDING THE APPLICABILITY OF THIS INTERPRETATION SHOULD BE DIRECTED TO THE LIVERMORE/PLEASANTON FIRE DEPT. AT (925)454-2330.
- WATER METER, WATER LINE PIPE AND GAS LINE PIPE SIZING CALCULATIONS ALONG WITH ONE-LINE ISOMETRIC DRAWINGS MAY BE REQUIRED BY THE FIELD BUILDING INSPECTOR AND WILL BE PROVIDED BY THE CONTRACTOR. ALL PLAN REVIEW FEES WILL BE PAID AS REQUIRED BY THE PERMITTEE.
- PLUMBING DRAIN WASTE AND VENT AND/OR MECHANICAL DUCTING AND/OR ELECTRICAL PANEWIRE DIAGRAM OR DRAWINGS MAY BE REQUIRED BY THE FIELD BUILDING INSPECTOR AND WILL BE PROVIDED BY THE CONTRACTOR UPON REQUEST. ALL PLAN REVIEW FEES WILL BE PAID AS REQUIRED BY THE PERMITTEE.
- ELECTRICAL LOAD CALCULATIONS SHALL BE PROVIDED BY THE CONTRACTOR UPON THE REQUEST OF THE FIELD BUILDING INSPECTOR. ALL PLAN REVIEW FEES WILL BE PAID AS REQUIRED BY THE PERMITTEE.

SITE NOTES

- THE CONTRACTOR SHALL VERIFY ON SITE ALL GRADES, EXISTING IMPROVEMENTS, PROPERTY LINES, EASEMENTS, SETBACKS, UTILITIES, AND SUB-STRUCTURES. WHERE DISCREPANCIES OCCUR, CONTACT ARCHITECT.
- FINISH GRADE SHALL PROVIDE POSITIVE DRAINAGE AWAY FROM BUILDING. THE SLOPE OF GRADE AWAY FROM EXTERIOR FOUNDATIONS TO BE 6 INCHES MINIMUM WITHIN 10 FEET (5% MINIMUM, 2% IS PERMITTED AT IMPERVIOUS SURFACES). (C.R. GRAD. 3)
- ALL ROOF DRAINAGE SHALL BE PIPED TO APPROVED DRAINAGE FACILITY. ROOF DRAINS SHALL DAYLIGHT INTO THE LANDSCAPE OR LAWN AREAS.
- IRRIGATION SYSTEM SHALL BE DESIGNED TO PREVENT SATURATION OF SOIL ADJACENT TO BUILDING.

PUD-107 EXHIBIT A

CONDITIONS OF APPROVAL - 377 ST. MARY STREET

NOVEMBER 18, 2015 - PROJECT SPECIFIC CONDITIONS OF APPROVAL.

- THE NEW RESIDENCES SHALL BE CONSTRUCTED TO ALLOW FOR FUTURE INSTALLATION OF A PHOTOVOLTAIC (PV) SYSTEM AND SOLAR WATER HEATING SYSTEMS. THE PROJECT APPLICANT SHALL COMPLY WITH THE FOLLOWING REQUIREMENTS FOR MAKING THE DWELLING PHOTOVOLTAIC-READY AND SOLAR-WATER-HEATING-READY:
 - ELECTRICAL CONDUIT AND CABLE PULL STRINGS SHALL BE INSTALLED FROM THE ROOF/ATTIC AREA TO THE BUILDING'S MAIN ELECTRICAL PANELS.
 - AN AREA SHALL BE PROVIDED NEAR THE ELECTRICAL PANEL FOR THE INSTALLATION OF AN INVERTER REQUIRED TO CONVERT THE DIRECT CURRENT OUTPUT FROM PHOTOVOLTAIC PANELS TO ALTERNATING CURRENT.
 - ENGINEER THE ROOF TRUSSES TO HANDLE AN ADDITIONAL LOAD AS DETERMINED BY A STRUCTURAL ENGINEER TO ACCOMMODATE THE ADDITIONAL WEIGHT OF A PROTOTYPICAL PHOTOVOLTAIC SYSTEM BEYOND THAT ANTICIPATED FOR ROOFING.
 - PLUMBING SHALL BE INSTALLED FOR SOLAR-WATER HEATING, AND
 - SPACE SHALL BE PROVIDED FOR SOLAR-HEATING TANK.

CGBC § 4.106.4.1:

A. Install a listed raceway to accommodate a dedicated 208/240-volt branch circuit. The raceway shall not be less than nominal 1-inch inside diameter. The raceway shall originate at the main service or subpanel and shall terminate into a listed cabinet, box, or other enclosure in close proximity to the proposed location of an EV charger.

B. The raceway termination location shall be permanently and visibly marked as "EV CAPABLE".

C. The service panel and/or subpanel shall provide capacity to install a 40-ampere minimum dedicated branch circuit and space(s) reserved to permit installation of a branch circuit overcurrent protective device.

F. The service panel or subpanel circuit directory shall identify the reserved overcurrent protective device space(s) as "EV CAPABLE".

CODE ANALYSIS

CONSTRUCTION TYPE: VB (NFPA 13D SPRINKLERS)

OCCUPANCY: R3 - SINGLE-FAMILY DETACHED DWELLING & U - PRIVATE GARAGE

OCCUPANCY SEPARATION: PER 2013 CRC R 302.6

- RESIDENCE WALLS TO GARAGE: MIN. 1/2" GYP. BD.
- GARAGE TO ATTIC: MIN. 1/2" GYP. BD.
- PROJECTIONS AT HABITABLE ROOM ABOVE: MIN. 5/8" TYPE X GYP. BD.

REQUIRED ASSEMBLIES:

- INTERIOR WALLS: NON-RATED WITHIN EA. DWELLING
- EXTERIOR WALLS: NON-RATED TYP. - OR - 1-HR WHEN EXTERIOR FINISH IS LESS THAN 3'-0" FROM PROPERTY LINE (TABLE R302.1 (2))
- PROJECTIONS AT RATED WALLS (TABLE R302.1(2)):
 - 1-HR UNDERSIDE > 2' TO 3'
 - (NOT ALLOWED LESS THAN 2')

ALLOWABLE OPENINGS (TABLE R302.1 (2))

- UNLIMITED UNPROTECTED IN UNRATED WALLS
- NOT ALLOWED < 3' TO FIRE SEP. DIST.

ALLOWABLE HEIGHT: 40 FEET

CODE REFERENCES

BUILDING CODES:	IBC 2013 (CAL. RESIDENTIAL)
	IBC 2013 (CAL. BLDG. CODE)
	CMC 2013 (CAL. MECH. CODE)
	CPC 2013 (CAL. PLUMB. CODE)
	CEC 2013 (CAL. ELEC. CODE)
	CFR 2013 (CAL. FIRE CODE)
	CENC 2013 (CAL. ENERGY)
	CGBC 2013 (CAL. GREEN)
	2013 CITY OF PLEASANTON MUNICIPAL CODE

DEFERRED SUBMITTALS

DEFERRED SUBMITTAL ITEMS SHALL BE REVIEWED AND APPROVED BY THE ARCHITECT OR ENGINEER-OF-RECORD PRIOR TO FORWARDING THE ITEMS TO THE BUILDING DEPARTMENT FOR REVIEW.

THE DEFERRED SUBMITTAL ITEMS SHALL NOT BE INSTALLED UNTIL THE BUILDING DEPARTMENT HAS APPROVED THEIR DESIGN AND SUBMITTAL DOCUMENTS.

NFPA 13D SPRINKLERS
 MANUFACTURED TRUSSES
 MECHANICAL SYSTEMS

ABBREVIATIONS

1P/1S	1 POLE / 1 SHELF	OPT.	OPTIONAL
SS	5 SHELVES	RF. BLW	ROOF BELOW
B.O.	BOTTOM OF	S.S.D.	SEE STRUCTURAL DRAWINGS
CLG.	CEILING	SH	SINGLE HUNG
CONC.	CONCRETE	SL	SLIDER WINDOW
DET.	DETAIL	SP	SPRING POINT
DS	DOWNSPOUT	T&G	TONGUE AND GROOVE
DS BLW	DOWNSPOUT BELOW	TEMP.	TEMPERED GLASS
F.F. OR F.O.F.	FACE OF FRAMING	T.O.P.	TOP OF PLATE
FOUND.	FOUNDATION	T.O.C.	TOP OF CURB
FR	FIRE RATED	T.O.SLAB	TOP OF SLAB
FR. DR.	FRENCH DOOR	T.O.S.F.	TOP OF SUBFLOOR
FX.	FIXED WINDOW	T.O.BM.	TOP OF BEAM
HDR.	HEADER	TYP.	TYPICAL
HL. HT.	HEEL HEIGHT	U.O.N.	UNLESS OTHERWISE NOTED
HT.	HEIGHT	VERT.	VERTICAL
LAV.	LAVATORY	WD.	WOOD
LIN.	LINEN	WDW.	WINDOW
MR	MOISTURE RESISTANT	WP	WEATHER PROOF

PROJECT DESCRIPTION

PROJECT DESCRIPTION:

ZONING DISTRICT: C-C

LOTS: 3 TOTAL

BLDG COVERAGE:

LOT 1:	47%
LOT 2:	48%
LOT 3:	47%

TOTAL DENSITY: 20 DU / AC

TOTAL REQUIRED PARKING: 6 SPACES (2 PER UNIT)

TOTAL PROVIDED PARKING: 13 SPACES

UNIT DESCRIPTION:

PLAN 1A: 1 UNIT

UNIT INFO: 4 BED/3.5 BA/2-CAR

TOTAL LIVING AREA: 2268 SF

GARAGE AREA: 483 SF

EXTERIOR STAIRS: 108 SF

TOTAL BLDG AREA: 1061 SF

PLAN 1B: 2 UNITS

UNIT INFO: 4 BED/3.5 BA/2-CAR

TOTAL LIVING AREA: 2268 SF

GARAGE AREA: 483 SF

EXTERIOR STAIRS: 108 SF

TOTAL BLDG AREA: 1061 SF

PLAN AREAS

3 BED / 3.5 BATH + BONUS ROOM (OPT. BED 4)

FIRST FLOOR:	445 SF	2-CAR GARAGE:	483 SF
SECOND FLOOR:	856 SF	PORCH:	64 SF
THIRD FLOOR @ A:	967 SF	DECK:	56 SF
(THIRD FLOOR @ B:	908 SF)		

TOTAL LIVING @ A: 2268 SF

(TOTAL LIVING @ B: 2269 SF)

VICINITY MAP

[REDACTED MAP]

REVISIONS

1	1ST CITY PLAN CHECK	08-01-16
2	IN-HOUSE REVISIONS	08-01-16

BUILDING DEPARTMENT SUBMITTAL 1

TITLE SHEET


JOB NO. 1249.001 SHEET

DRAWN MWS / AMF / RG

CHECK

DATE 08-01-16


T.1

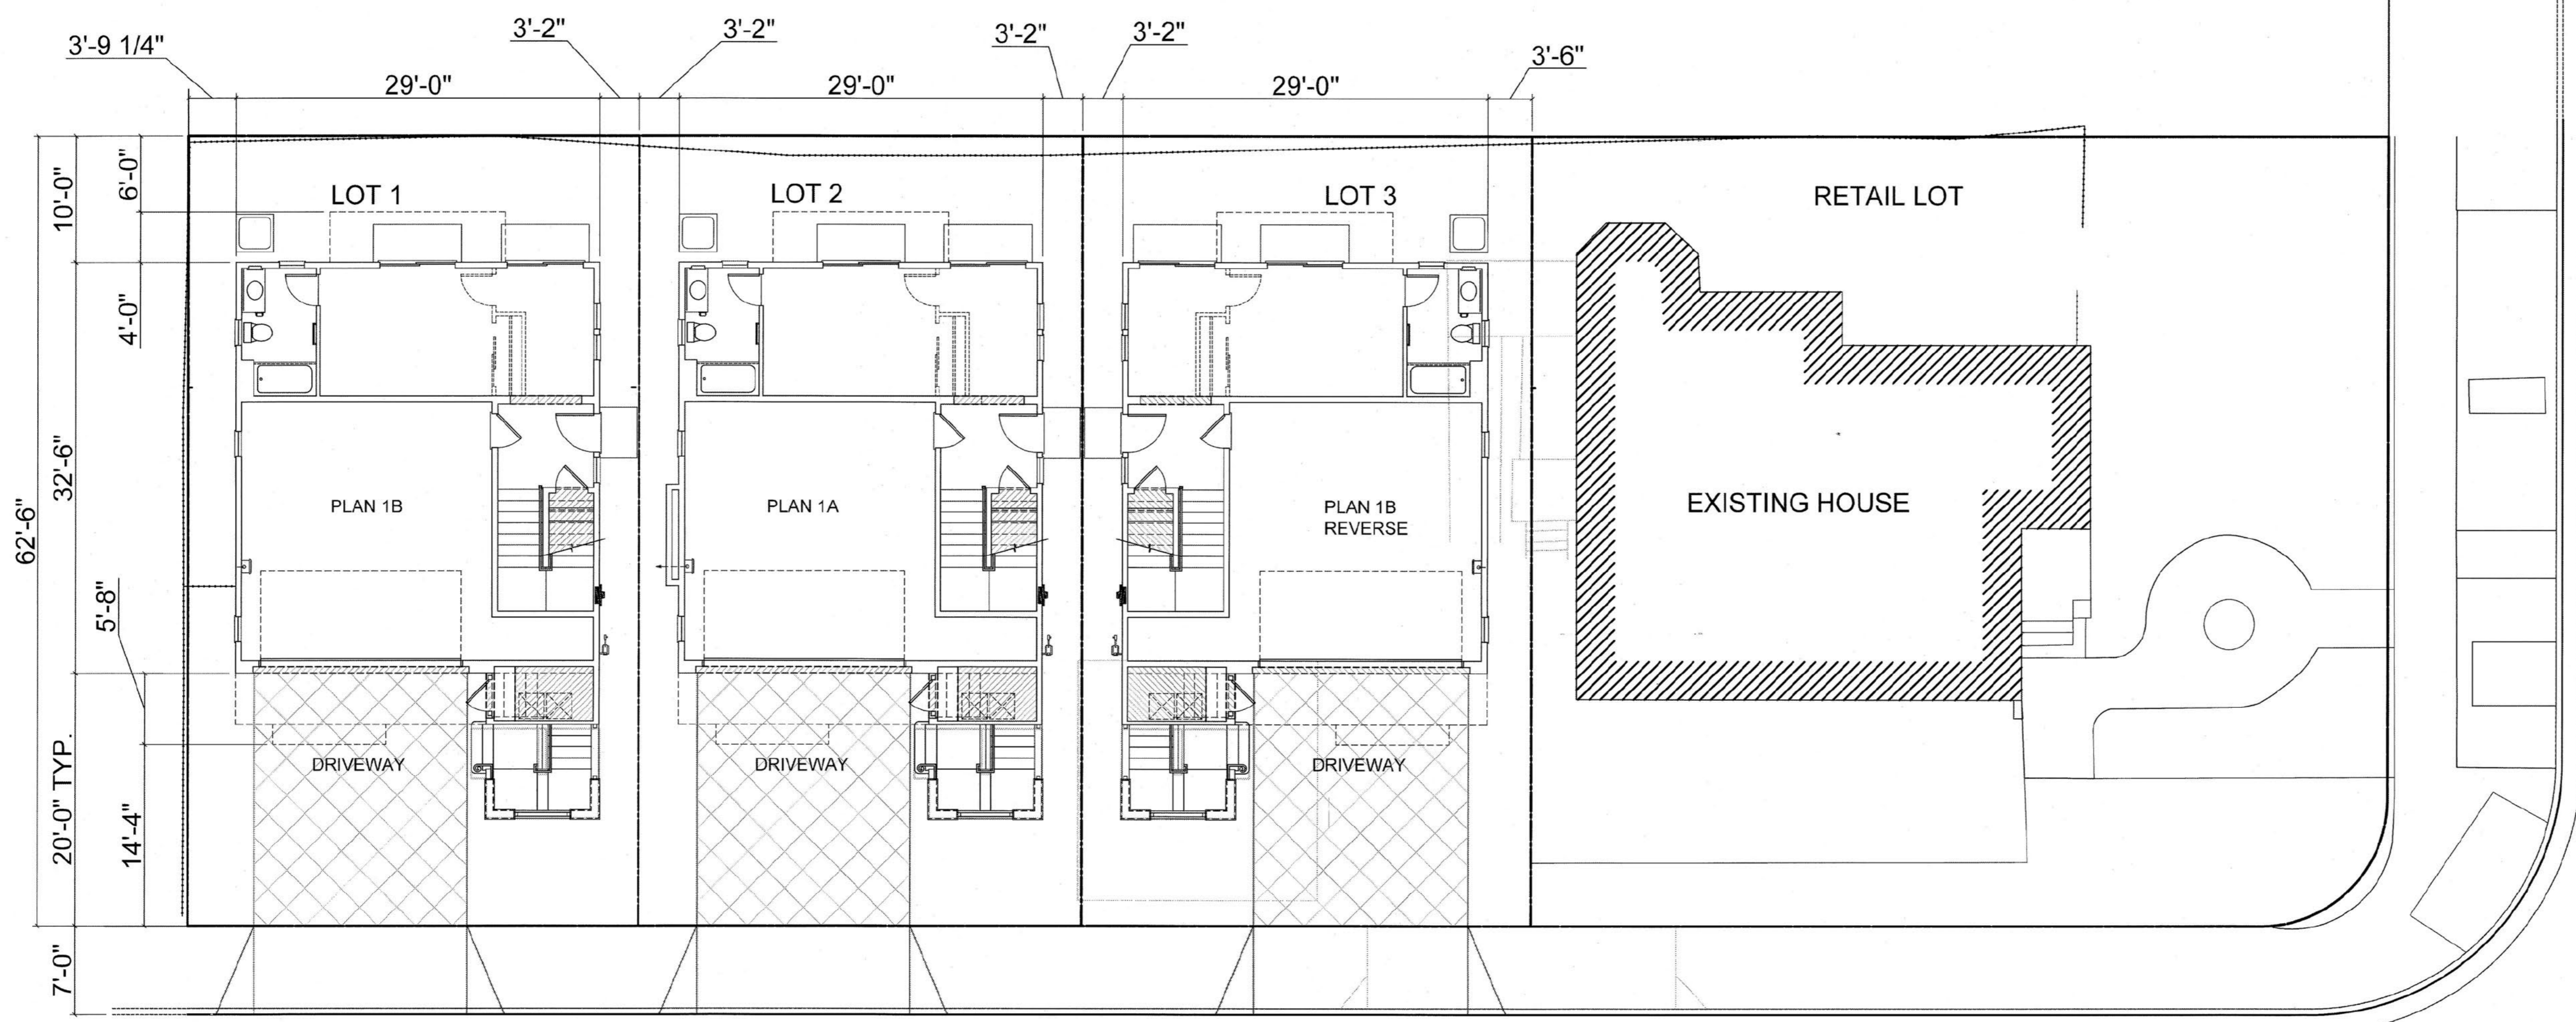

SITE PLAN
SCALE: 1/8"=1'-0"

REVISIONS	
△	1ST CITY PLAN CHECK 08-01-16
△	IN-HOUSE REVISIONS 08-01-16


BUILDING DEPARTMENT SUBMITTAL 1
SITE PLAN
SCALE 1/8"=1'-0"

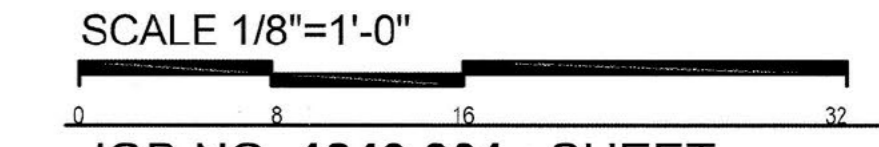


JOB NO. 1249.001 SHEET
DRAWN MWS / AMF / RG
CHECK
DATE 08-01-16 **A.0**

FLOOR PLAN NOTES


1. ALL EXTERIOR DIMENSIONS TO FACE OF STUD, FACE OF FOUNDATION, & FACE OF STOREFRONT (U.O.N.)
2. ALL INTERIOR DIMENSIONS TO FACE OF STUD (U.O.N.)
3. ALL DIMENSIONS AT WINDOWS & DOORS ARE TO THE CENTERLINE (U.O.N.)
4. ALL DOOR JAMBS ON HINGE SIDE SHALL BE 4" U.O.N.
5. ALL ANGLED WALLS (OTHER THAN 90°) SHALL BE 45° U.O.N.
6. ALL EXTERIOR WALLS SHALL BE CONSTRUCTED OF 2X6 STUDS, U.O.N., S.S.D.
7. ALL INTERIOR WALLS SHALL BE CONSTRUCTED OF 2X4 STUDS, U.O.N., S.S.D.
8. FOR TYP. CLOSET SHELVING, SEE DETAIL 20AD.2
9. ALL TEMPERED GLASS SHALL BE AFFIXED WITH A PERMANENT LABEL PER 2013 CRC R308.1
10. PROVIDE ACCOUTSULT PIPE WRAP AT ALL SECOND FLOOR WASTE LINES.
11. TILE INSTALLATION SHALL COMPLY W/ APPLICABLE SECTIONS OF THE TILE COUNCIL OF NORTH AMERICA'S "HANDBOOK FOR CERAMIC TILE INSTALLATION" AND ITS REFERENCED STANDARDS.
12. ALL COUNTERTOPS, TUB DECKS & WALLS AT TUBS & SHOWERS SHALL HAVE SMOOTH, HARD, NONABSORBENT SURFACE OF CEMENTITIOUS BACKER BOARD AND A MOISTURE RESISTANT UNDERLAYMENT TO A HEIGHT OF 1/2" ABOVE FLOOR PER 2013 CRC R307.2
13. PROVIDE BACKING FOR ALL WALL AND CEILING MOUNTED CABINETS, FIXTURES, CABINETS, BRACKET, GRAB BARS, ETC. AS REQUIRED. COORDINATE WITH SUPPLIERS FOR REQUIREMENTS.
14. CALCULATIONS AND DETAILS FOR MOUNTING HANDRAILS & CONNECTION OF GUARDRAILS SHALL BE PROVIDED FOR REVIEW AND APPROVAL BY RAILING FABRICATOR PRIOR TO INSTALLATION FOR COMPLIANCE WITH 2013 CRC TABLE R301.5
15. VERIFY APPLIANCE DIMENSIONS PRIOR TO CABINET FABRICATION
16. 1 LAYER 1/2" GYP. BD. ON ALL WALLS OF GARAGE. 2013 CRC TABLE R302.6

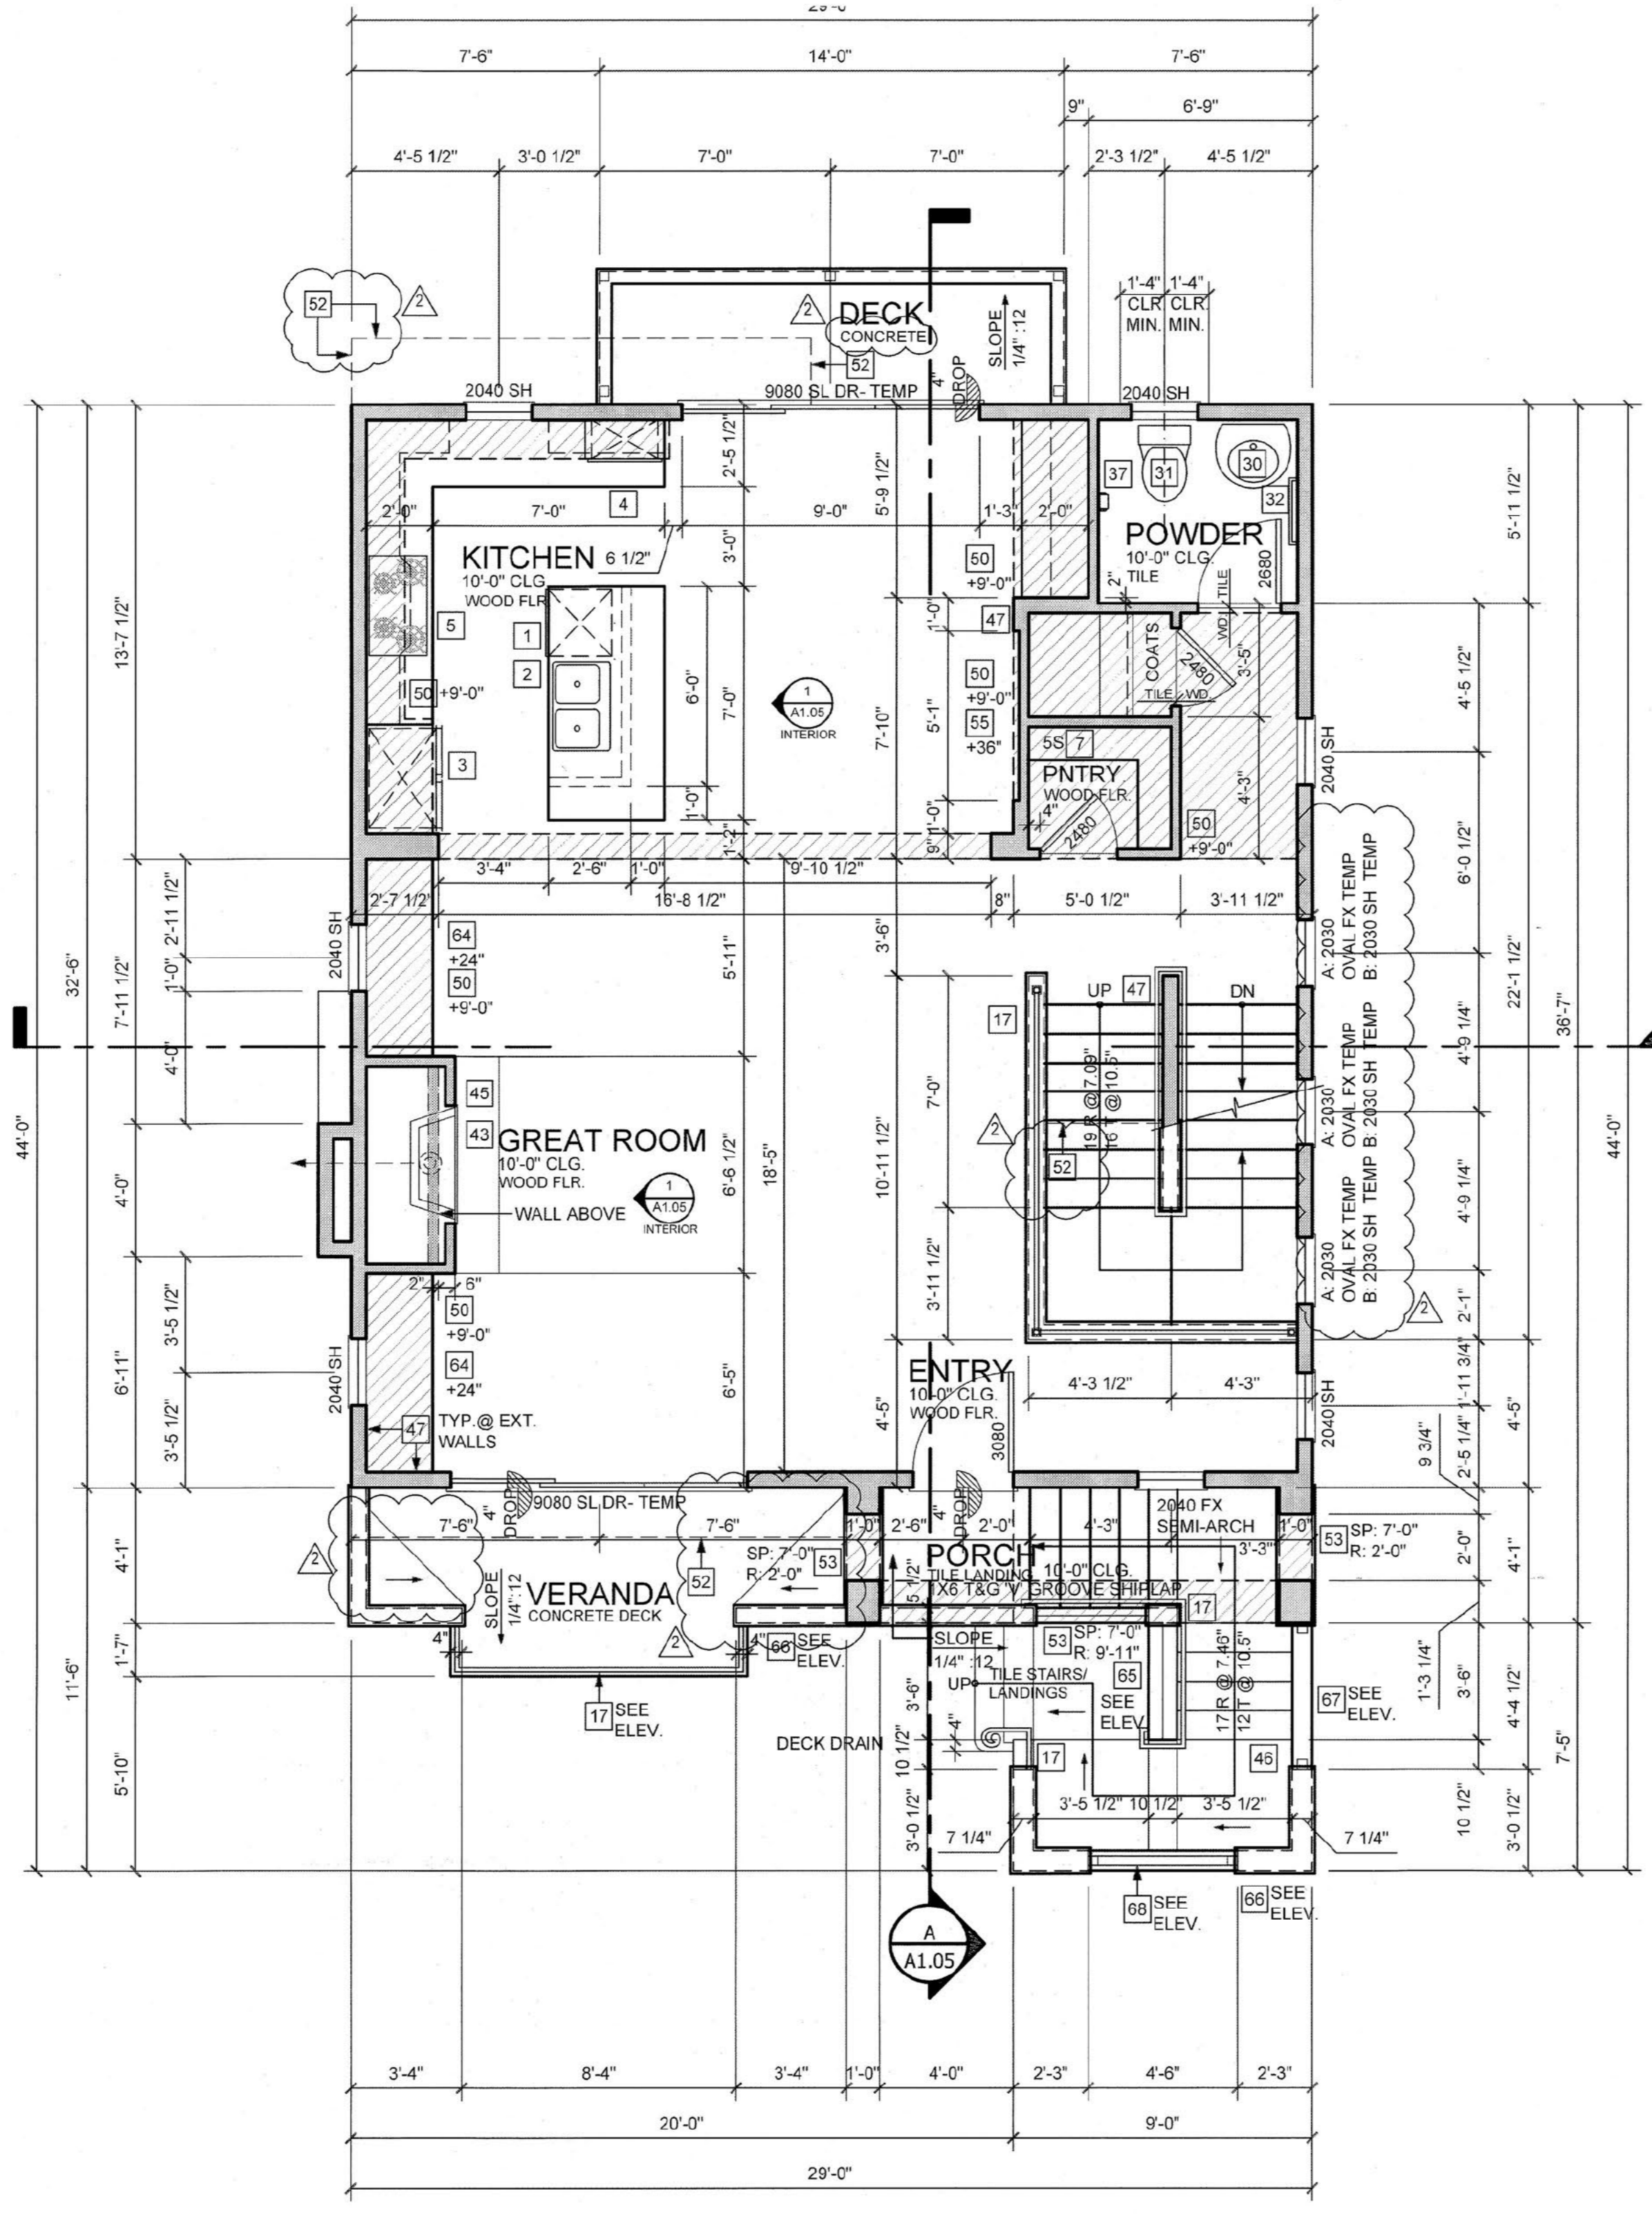


FIRST FLOOR PLAN A
SCALE 1/4" = 1'-0"

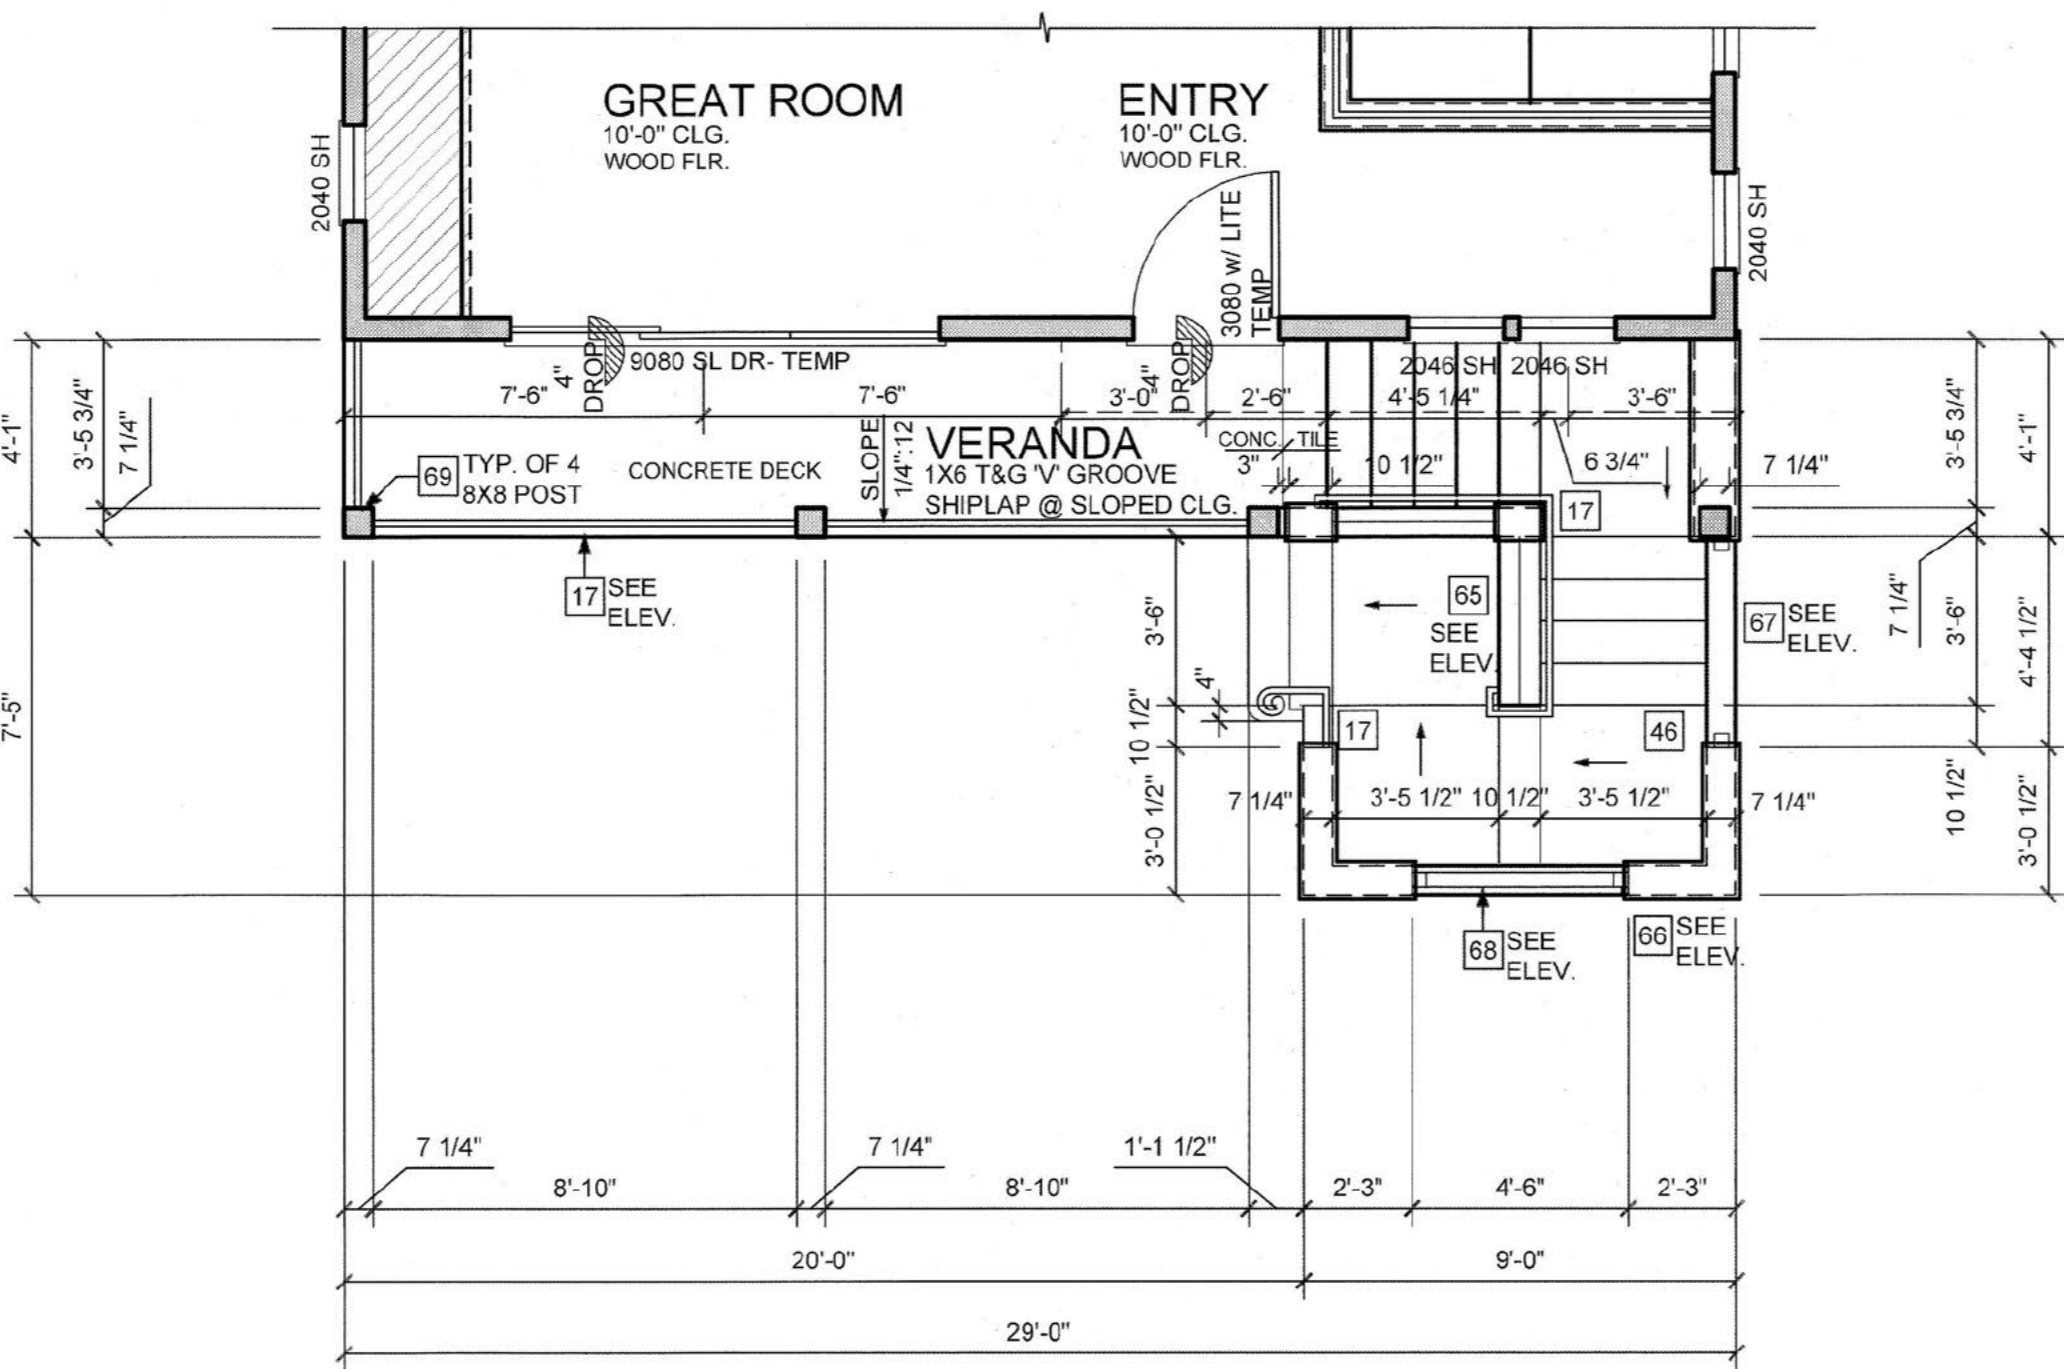


FIRST FLOOR PARTIAL @ PLAN B
SCALE 1/4" = 1'-0"

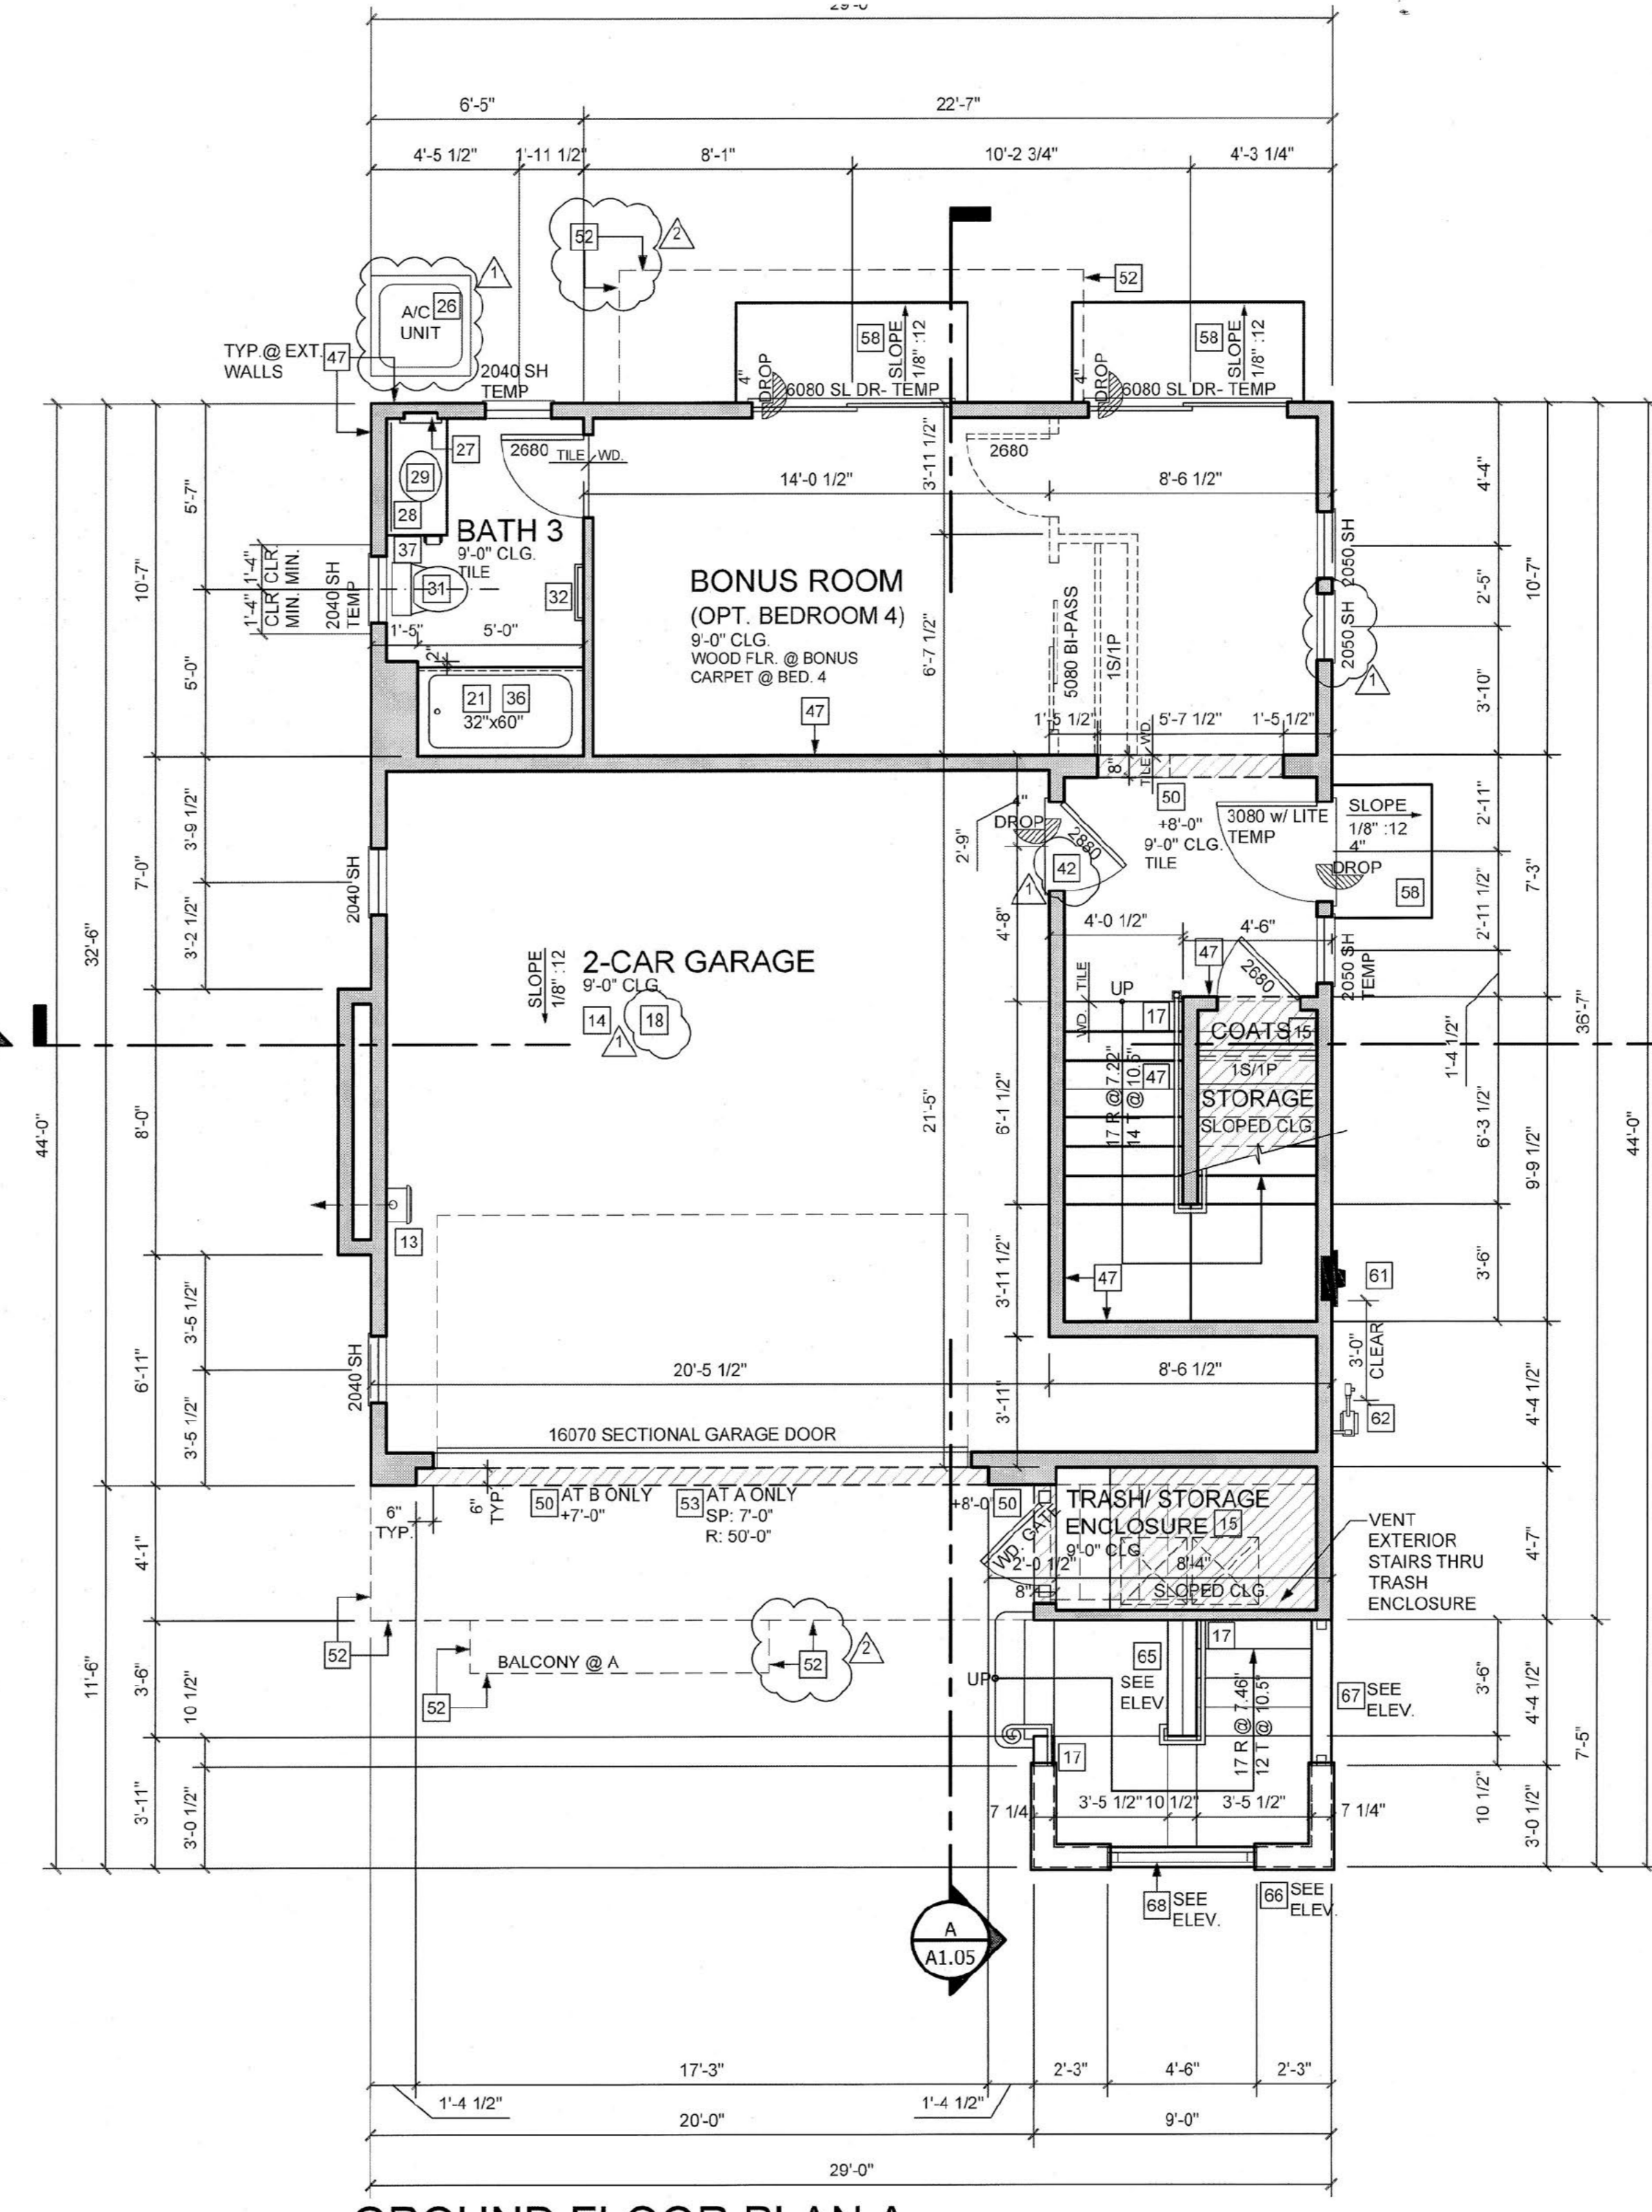

GROUND FLOOR PLAN A
SCALE 1/4" = 1'-0"

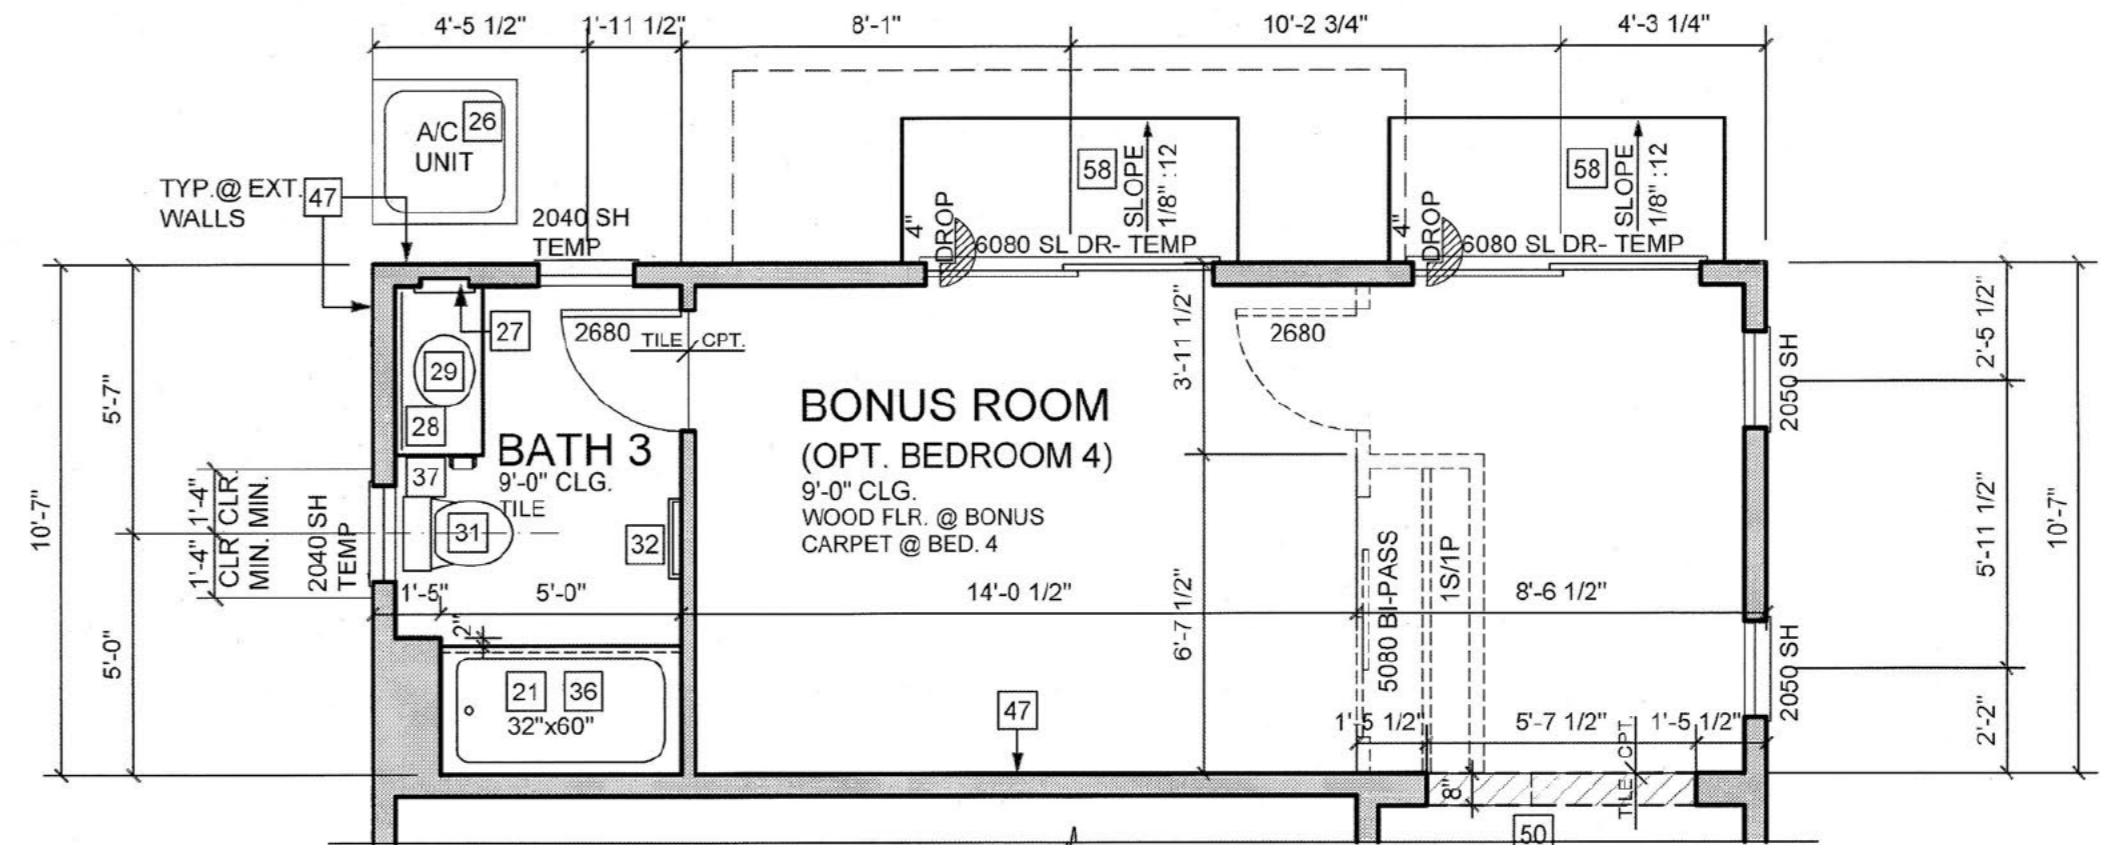

GROUND FLOOR PARTIAL @ PLAN B
SCALE 1/4" = 1'-0"

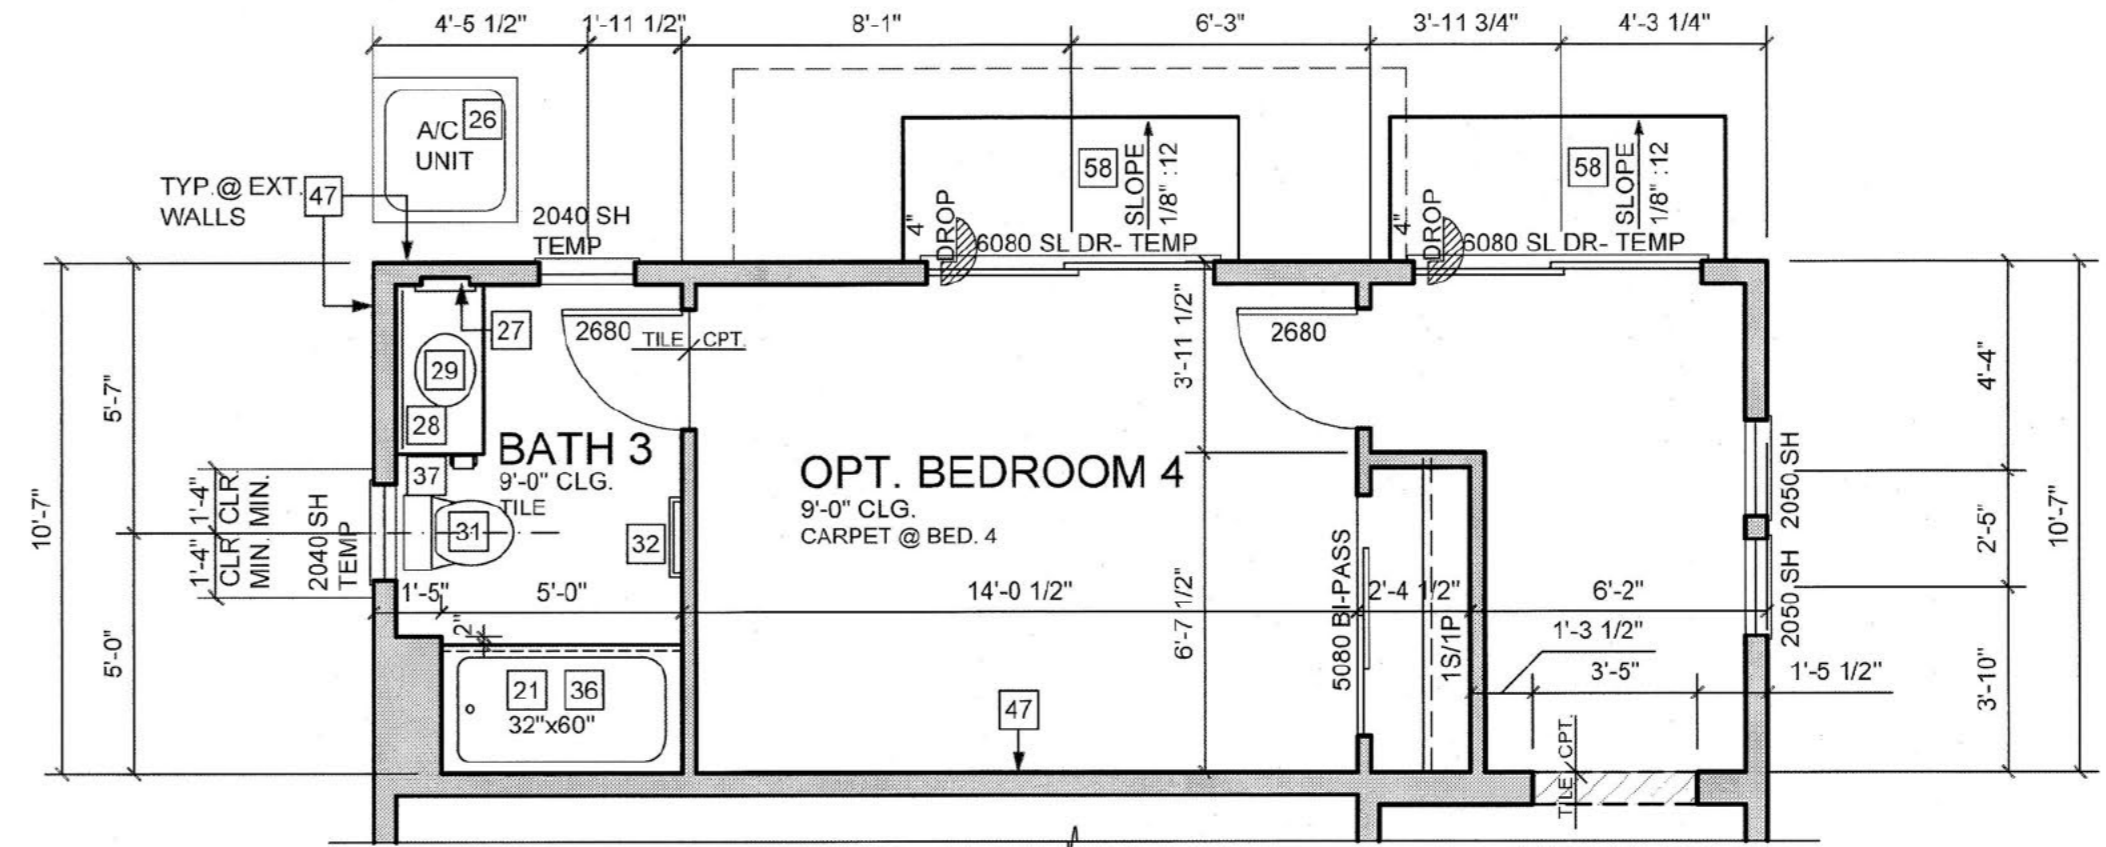

GROUND FLOOR PARTIAL @ PLAN A - OPT. BEDROOM 4
SCALE 1/4" = 1'-0"

KEYNOTE LEGEND

1. DRAINAGE TO GARAGE DISPOSAL (VERIFY DIMS. W/ MFR.)
2. W/CHEN SHW IN GARAGE DISPOSAL. INSTANT HOT WATER SUPPLIER (AT ISLAND SEE SET 750.1) MAX FLOW 1.8 GPM @ 80 PSI CODE 4.033.1.4
3. REFRIGERATION SPACE TO COLD WATER STUB-OUT FOR COOKER (VERIFY SIZE W/ MANUFACTURER)
4. SINK IN KITCHEN/OPEN CUPBND CABINET BAY. VERIFY DIMS. W/ MFR.
5. SINK IN PANTRY/OPEN CUPBND W/ FLOOR. LIGHT AND FAN ABOVE. VENT TO EXT. & PROVIDE BACKDRAFT CHIMNEY
6. NA
7. PANTRY W/ FIXED SHELVES (VERIFY NUMBER)
8. NA
9. STACKED WASHER AND DRYER. PROVIDE HOT & COLD WATER SUPPLY & WASTE LINE FOR WASHER. PROVIDE EXTERIOR VENT TO EXTERIOR. FOR DRYER, PROVIDE GSPM P/W DRAIN TO OUTSIDE AT ALL UPPER FLOOR LOCATIONS
10. NA
11. NA
12. NA
13. JAMBLESS WATER HEATER
14. ATTIC F.A.U. PROVIDE COMBUSTION AIR VENT TO OUTSIDE & SETBACK THERMOSTAT (FOR ATTIC F.A.U. SEE DET. 8AD.1)
15. JAMBLESS WATER HEATER
16. LAYER 1/2" GYP. BD. ON CEILING OF GARAGE IF HABITABLE ROOM ABOVE (CIRC. R302.7)
17. LAYER 1/2" GYP. BD. UNDER STAIRS AT WALLS & CLOS. (CIRC. R302.7)
18. 2"X4" W/ 1/2" W/ 1/2" WOOD JOIST. SEE PLAN FOR TYP. FRAMING.
19. 4"X4" W/ 1/2" W/ 1/2" WOOD JOIST. SEE PLAN FOR TYP. FRAMING.
20. SEPARATION OF THE GARAGE AND MAIN FLOOR SHALL BE 1 LAYER 1/2" GYP. BD. MIN. APPLIED TO THE GARAGE SIDE OF CEILING & WALLS SHOWN WITH THE REFERENCE CIRC. R302.7
21. 1 1/2" W/ 1/2" WOOD JOIST. SEE PLAN FOR TYP. FRAMING.
22. 3/8" ONE-WAY REBAR. SEE TIEBARS (U.O.N.) IN SHOWER CURTAIN ROD SHOWER HEAD AT 1/8" ABV. FLOOR (VERIFY DIMS. W/ MFR.)
23. NA
24. NA
25. NA
26. AIR CONDITIONING CONDENSER ON CONCRETE PAD OR APPROVED BASE EXTENDING NOT LESS THAN 3 INCHES ABOVE ADJACENT GROUND LEVEL (CIRC. 118.2). LOCATE MIN. 1 FT. FROM OUTLET OF ANY DRYER UNIT. (CIRC. 302.3.1.4)
27. 2"X4" W/ 1/2" W/ 1/2" WOOD JOIST. SEE PLAN FOR TYP. FRAMING.
28. NA
29. LAVATORY (MAX FLOW 1.5 GPM @ 80 PSI PER CAL. GREEN 4.033.1.4)
30. PRESS. LAVATORY (MAX FLOW 1.5 GPM @ 80 PSI PER CAL. GREEN 4.033.1.4)
31. LOW FLOW WATER CLOSET (1.33 GALLON PER FLUSH MAX. CAL. GREEN 4.033.1.1)
32. TONEL W/ VENT. SEE PLAN FOR TYP. FRAMING.
33. CERAMIC TILE SHELF. SEE PLANS FOR HT. ABOVE FLOOR. WATERPROOF @ TUB OR SHOWER AND SLOPE TOWARD THE DRAIN.
34. NA
35. NA
36. SHOWER CURTAIN ROD
37. TOILET PAPER ROLL
38. BATHROOM LIGHT. SOFFIT ABOVE
39. BREAK FRONT LINEN CABINET
40. INTERIOR SHELF (1"X 6"X 12" PLYWOOD) SEE PLANS FOR HEIGHT ABOVE FLOOR
41. W/CHEN SHW IN GARAGE DISPOSAL. INSTANT HOT WATER SUPPLIER (AT ISLAND SEE SET 750.1) MAX FLOW 1.8 GPM @ 80 PSI CODE 4.033.1.4
42. 1 3/8" S.O.D. CORE WOOD DOOR. 20 MINUTE FIRE RATED DOOR W/ SELF CLOSING & SEALS AT TOP & BOTTOM. SEE PLAN FOR TYP. FRAMING.
43. W/CHEN SHW IN GARAGE DISPOSAL. INSTANT HOT WATER SUPPLIER (AT ISLAND SEE SET 750.1) MAX FLOW 1.8 GPM @ 80 PSI CODE 4.033.1.4
44. LENOX ELETE SERIES MODEL RELV. DIRECT VENT FIREPLACE W/ GLASS DOORS & OUTSIDE COMBUSTION AIR
45. DECORATIVE TILES ON TREADS AND RISERS OF EXTERIOR STAIRS
46. 2x6 PLUMBING OR MASTIC WALL
47. DRYER VENT (VENT RUN SHALL COMPLY W/ MFR'S SPECS. AND THE 2013 CMC SECTION 9.3.8.9)
48. LINE OF FIRST FLOOR BELOW OR SECOND FLOOR ABOVE
49. LINE OF BROCKED SOFFIT ABOVE. SEE PLAN FOR FINISH AND HEIGHT ABV. FLOOR TO CENTER OF ARCH.
50. LINE OF BROCKED BEAM ABOVE. SEE STRUCT. FRAMING PLANS FOR SIZES
51. ART NICHE W/ DRYWALL GILL. (SEE PLAN FOR HT. ABOVE FLOOR)
52. LINE OF CONCRETE CURB
53. LINE OF WANDCOT BELOW (SEE EXTERIOR ELEVATIONS FOR HT.)
54. CONCRETE STOP-LANDING (DROPPED FROM ROUSE 18" X 12" MIN.) LANDING AT DOORS SHALL HAVE A LENGTH MEASURED IN THE DIRECTION OF TRAVEL NOT LESS THAN 3". (CIRC. R311.3)
55. ADJUSTABLE OPEN SHELVES
56. 2x4 F.A.U. STUD WALL
57. ELECTRICAL METER
58. GAS METER
59. SUB-PANEL
60. WOOD BRANCH SEAT BEHIND WINDOW. (SEE PLANS FOR HT. ABOVE FLOOR)
61. 2x4 HALF WALL (SEE PLANS FOR HT. ABOVE FLOOR)
62. 2x4 HALF WALL W/ BRICK CAP (SEE PLANS FOR HT. ABOVE FLOOR)
63. 1/2" WOOD GUARD RAIL ABOVE 1.05 FT. OR 34" IS 35" HT. AT HANDRAIL ABOVE TOP OF 3" TYP. NOBING BELOW.
64. 4"X4" SHANK TIE BEE ABOVE LANDING
65. 8X8 WOOD POST

- HATCH PATTERNS**
- SHELF ABOVE - ALSO SEE KEYNOTE #40.
 - DROPPED CEILING OR SOFFIT
 - R-11 SOUND INSULATION AT INTERIOR WALL

PLAN AREAS


3 BED / 3.5 BATH + BONUS ROOM (OPT. BED 4)		
FIRST FLOOR:	445 SF	2-CAR GARAGE: 483 SF
SECOND FLOOR:	856 SF	PORCH: 84 SF
THIRD FLOOR @ A:	967 SF	DECK: 56 SF
THIRD FLOOR @ B:	908 SF	
TOTAL LIVING @ A:	2268 SF	
(TOTAL LIVING @ B:	2269 SF)	

REVISIONS

- 1ST CITY PLAN CHECK 08-01-16
- IN-HOUSE REVISIONS 08-01-16


BUILDING DEPARTMENT SUBMITTAL 1
GROUND & FIRST FLOOR PLANS
SCALE 1/4" = 1'-0"

JOB NO. 1249.001 SHEET
DRAWN MWS / AMF / RG
CHECK
DATE 08-01-16 **A1.01**

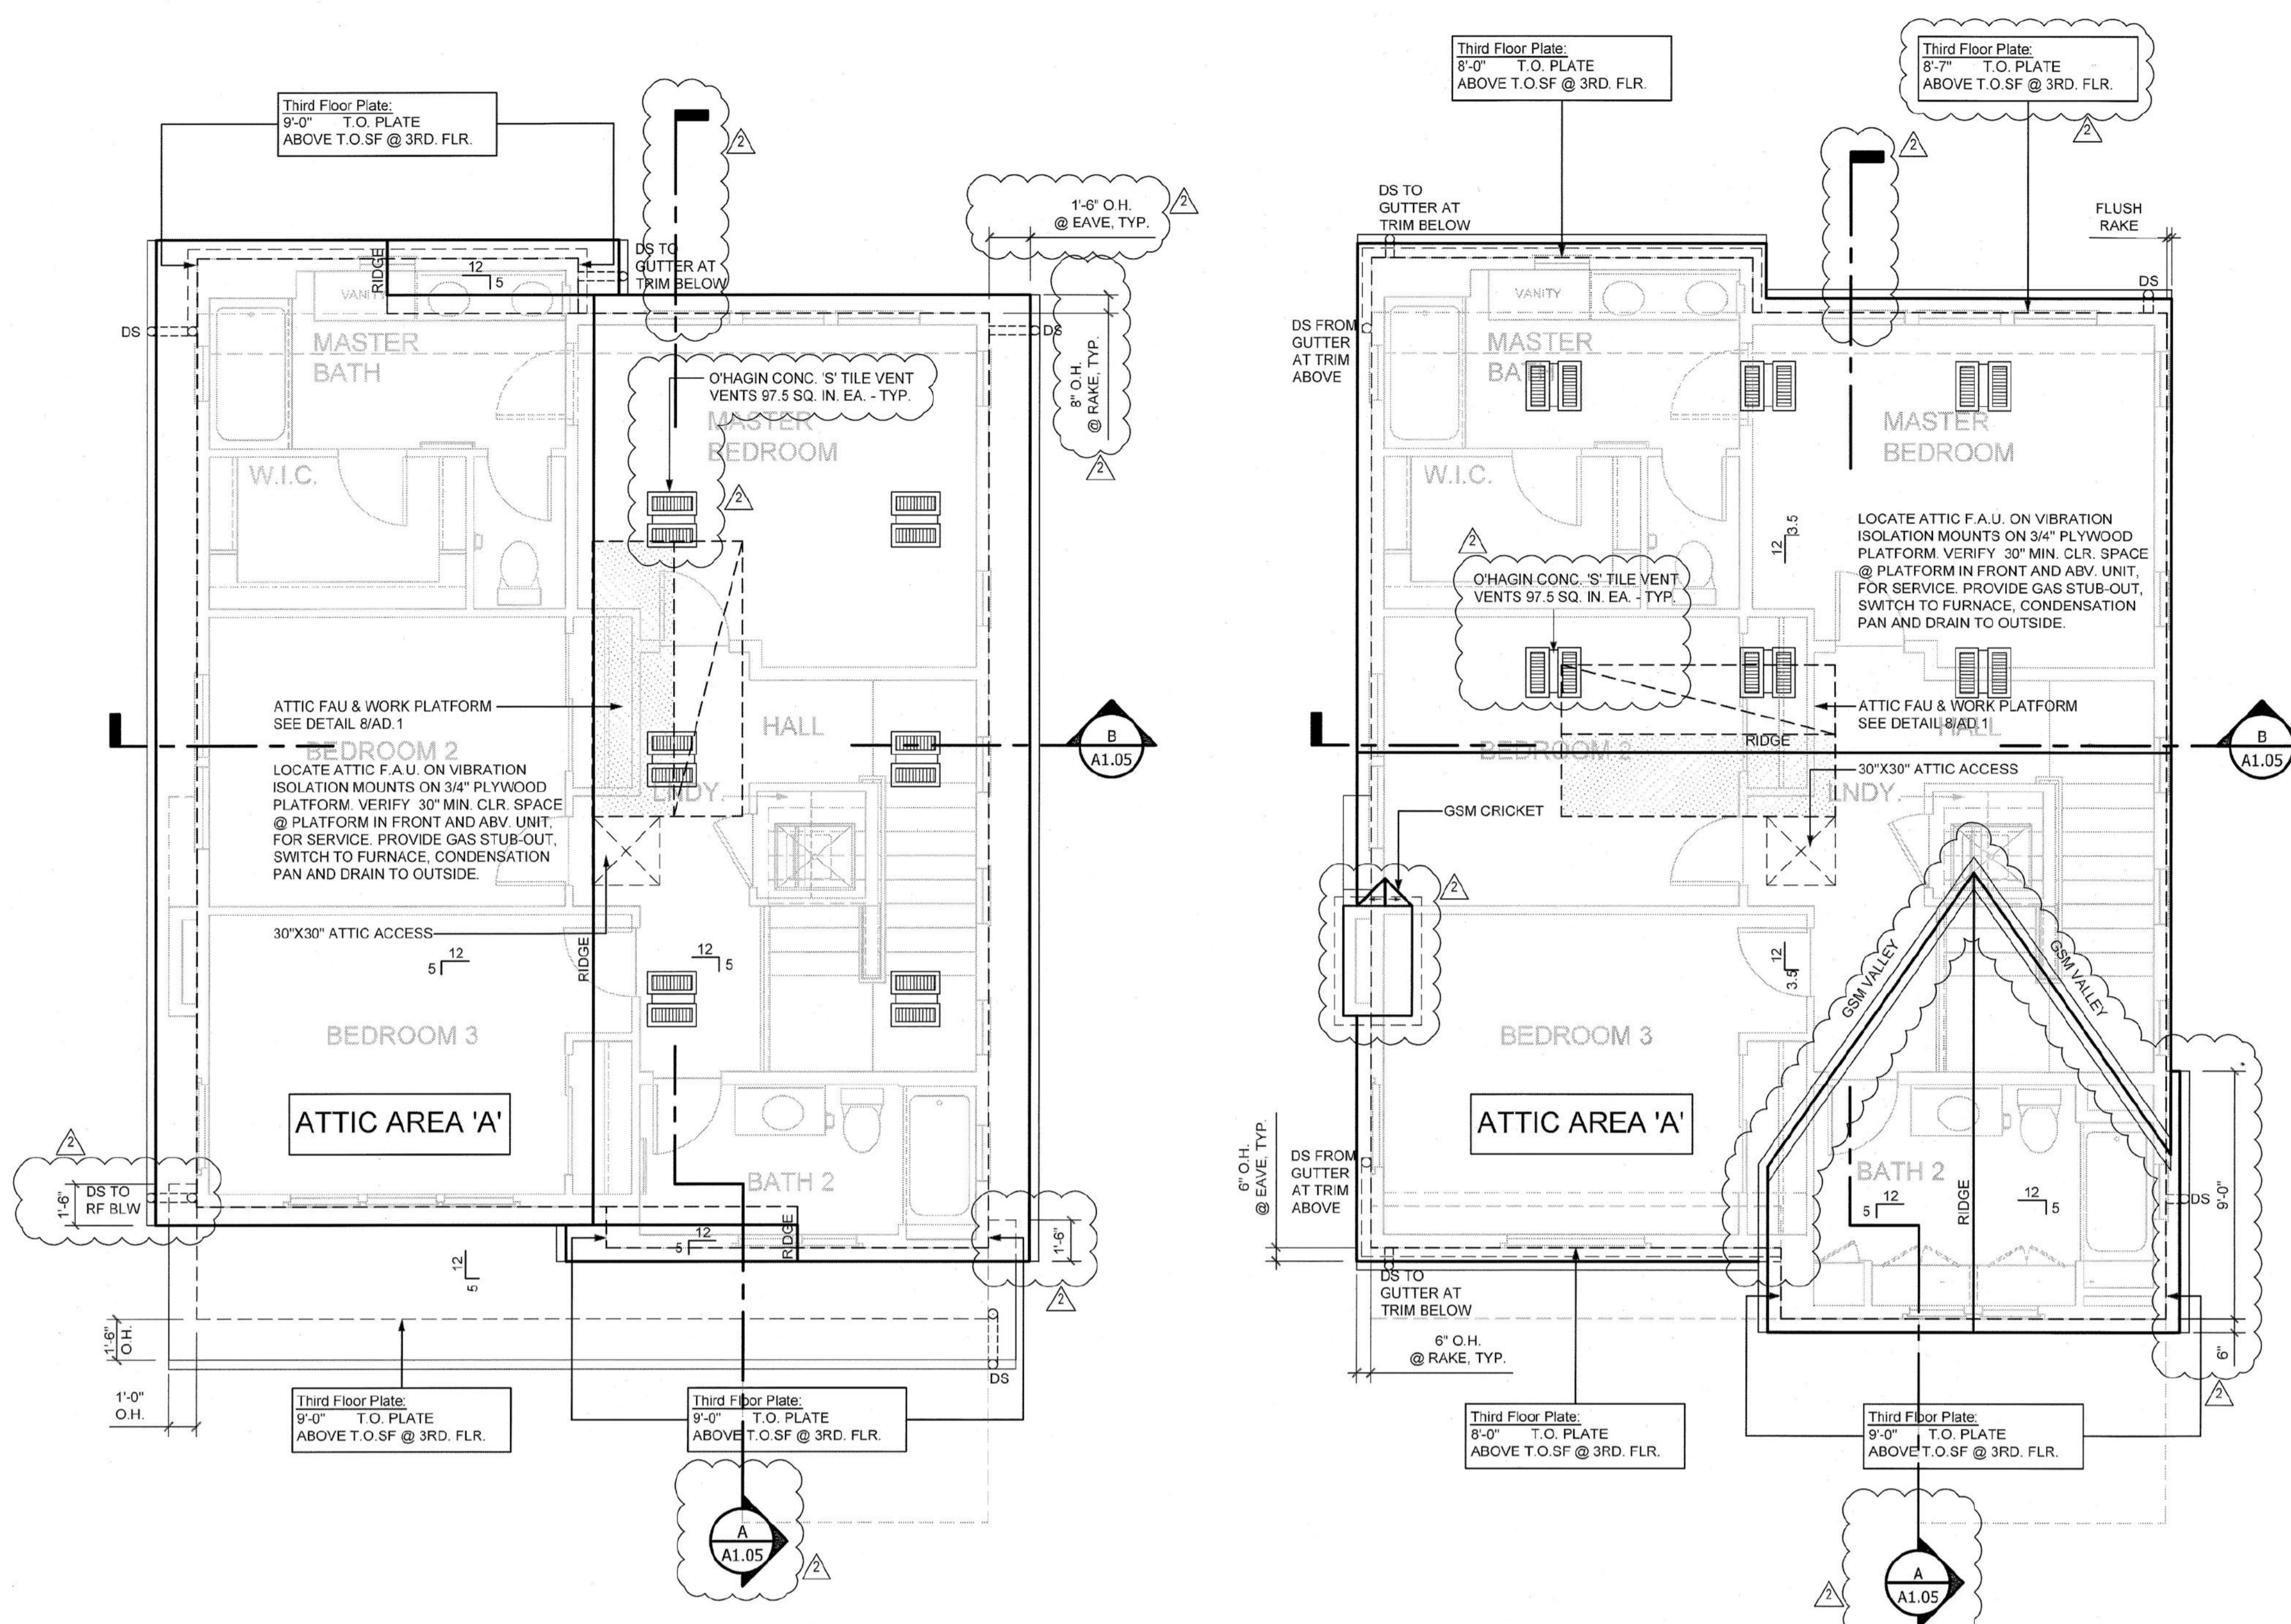


ROOF PLAN B
SCALE 1/4" = 1'-0"

ROOF PLAN A
SCALE 1/4" = 1'-0"

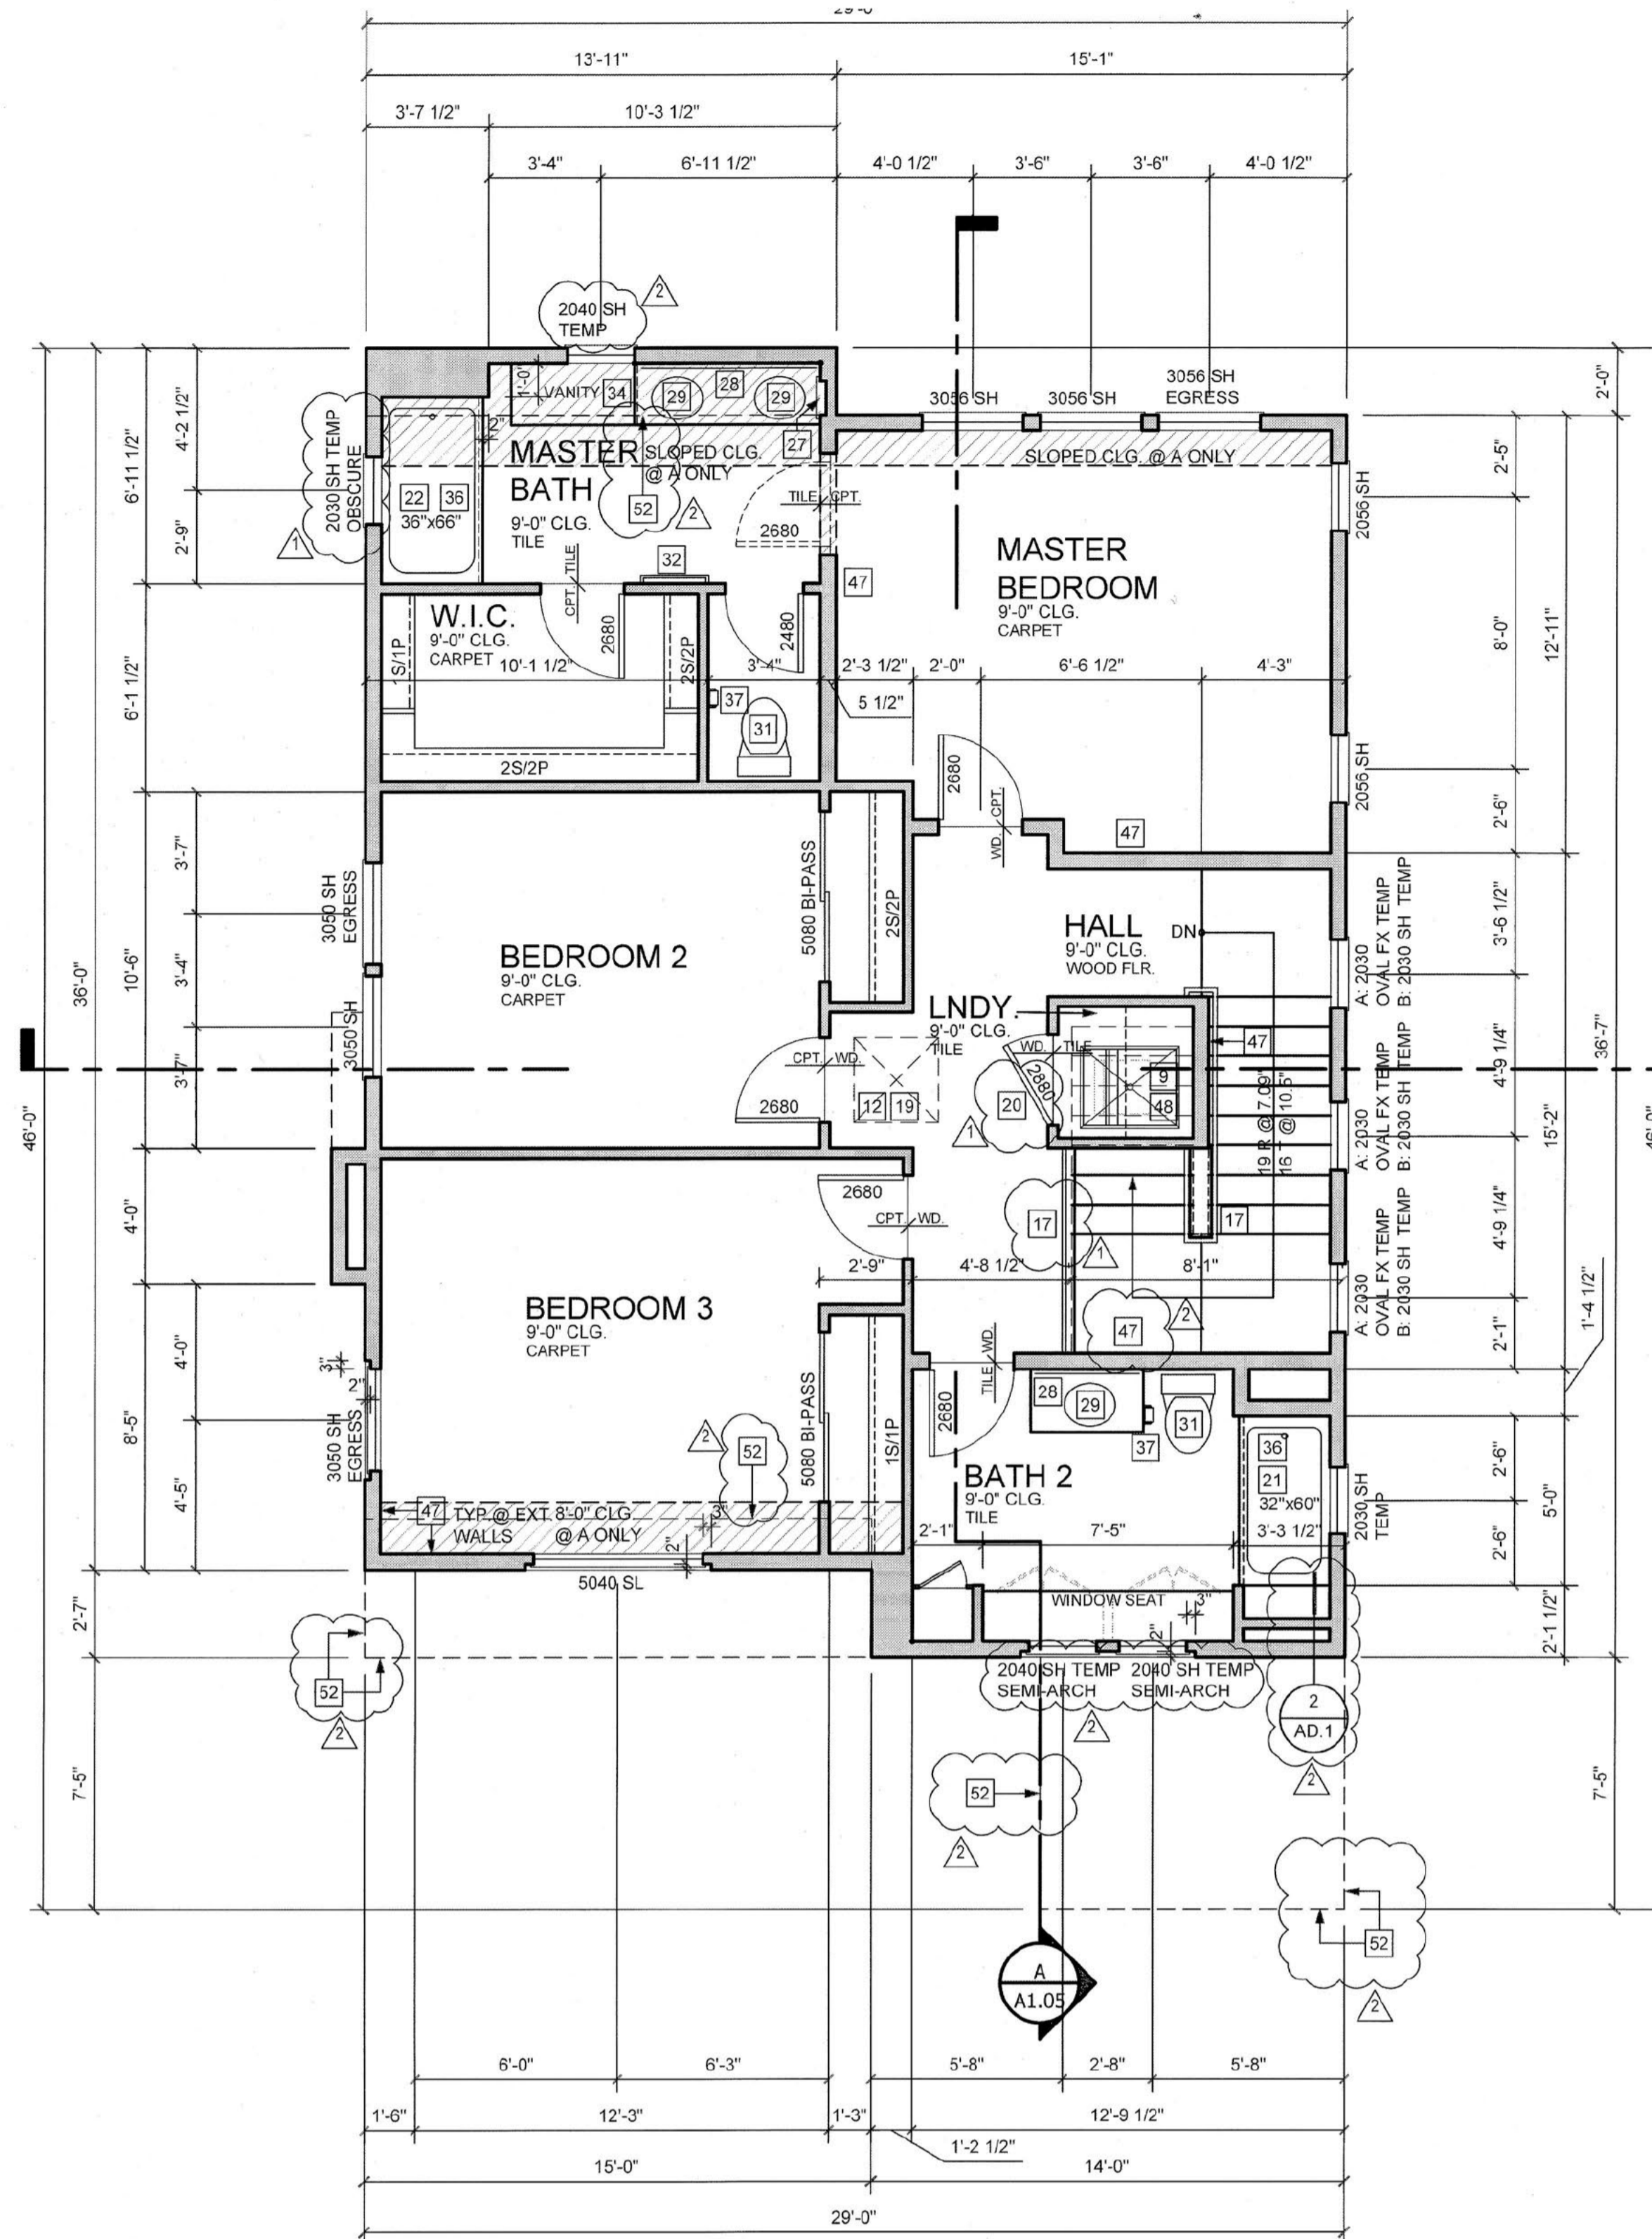

SECOND FLOOR PLAN A
SCALE 1/4" = 1'-0"

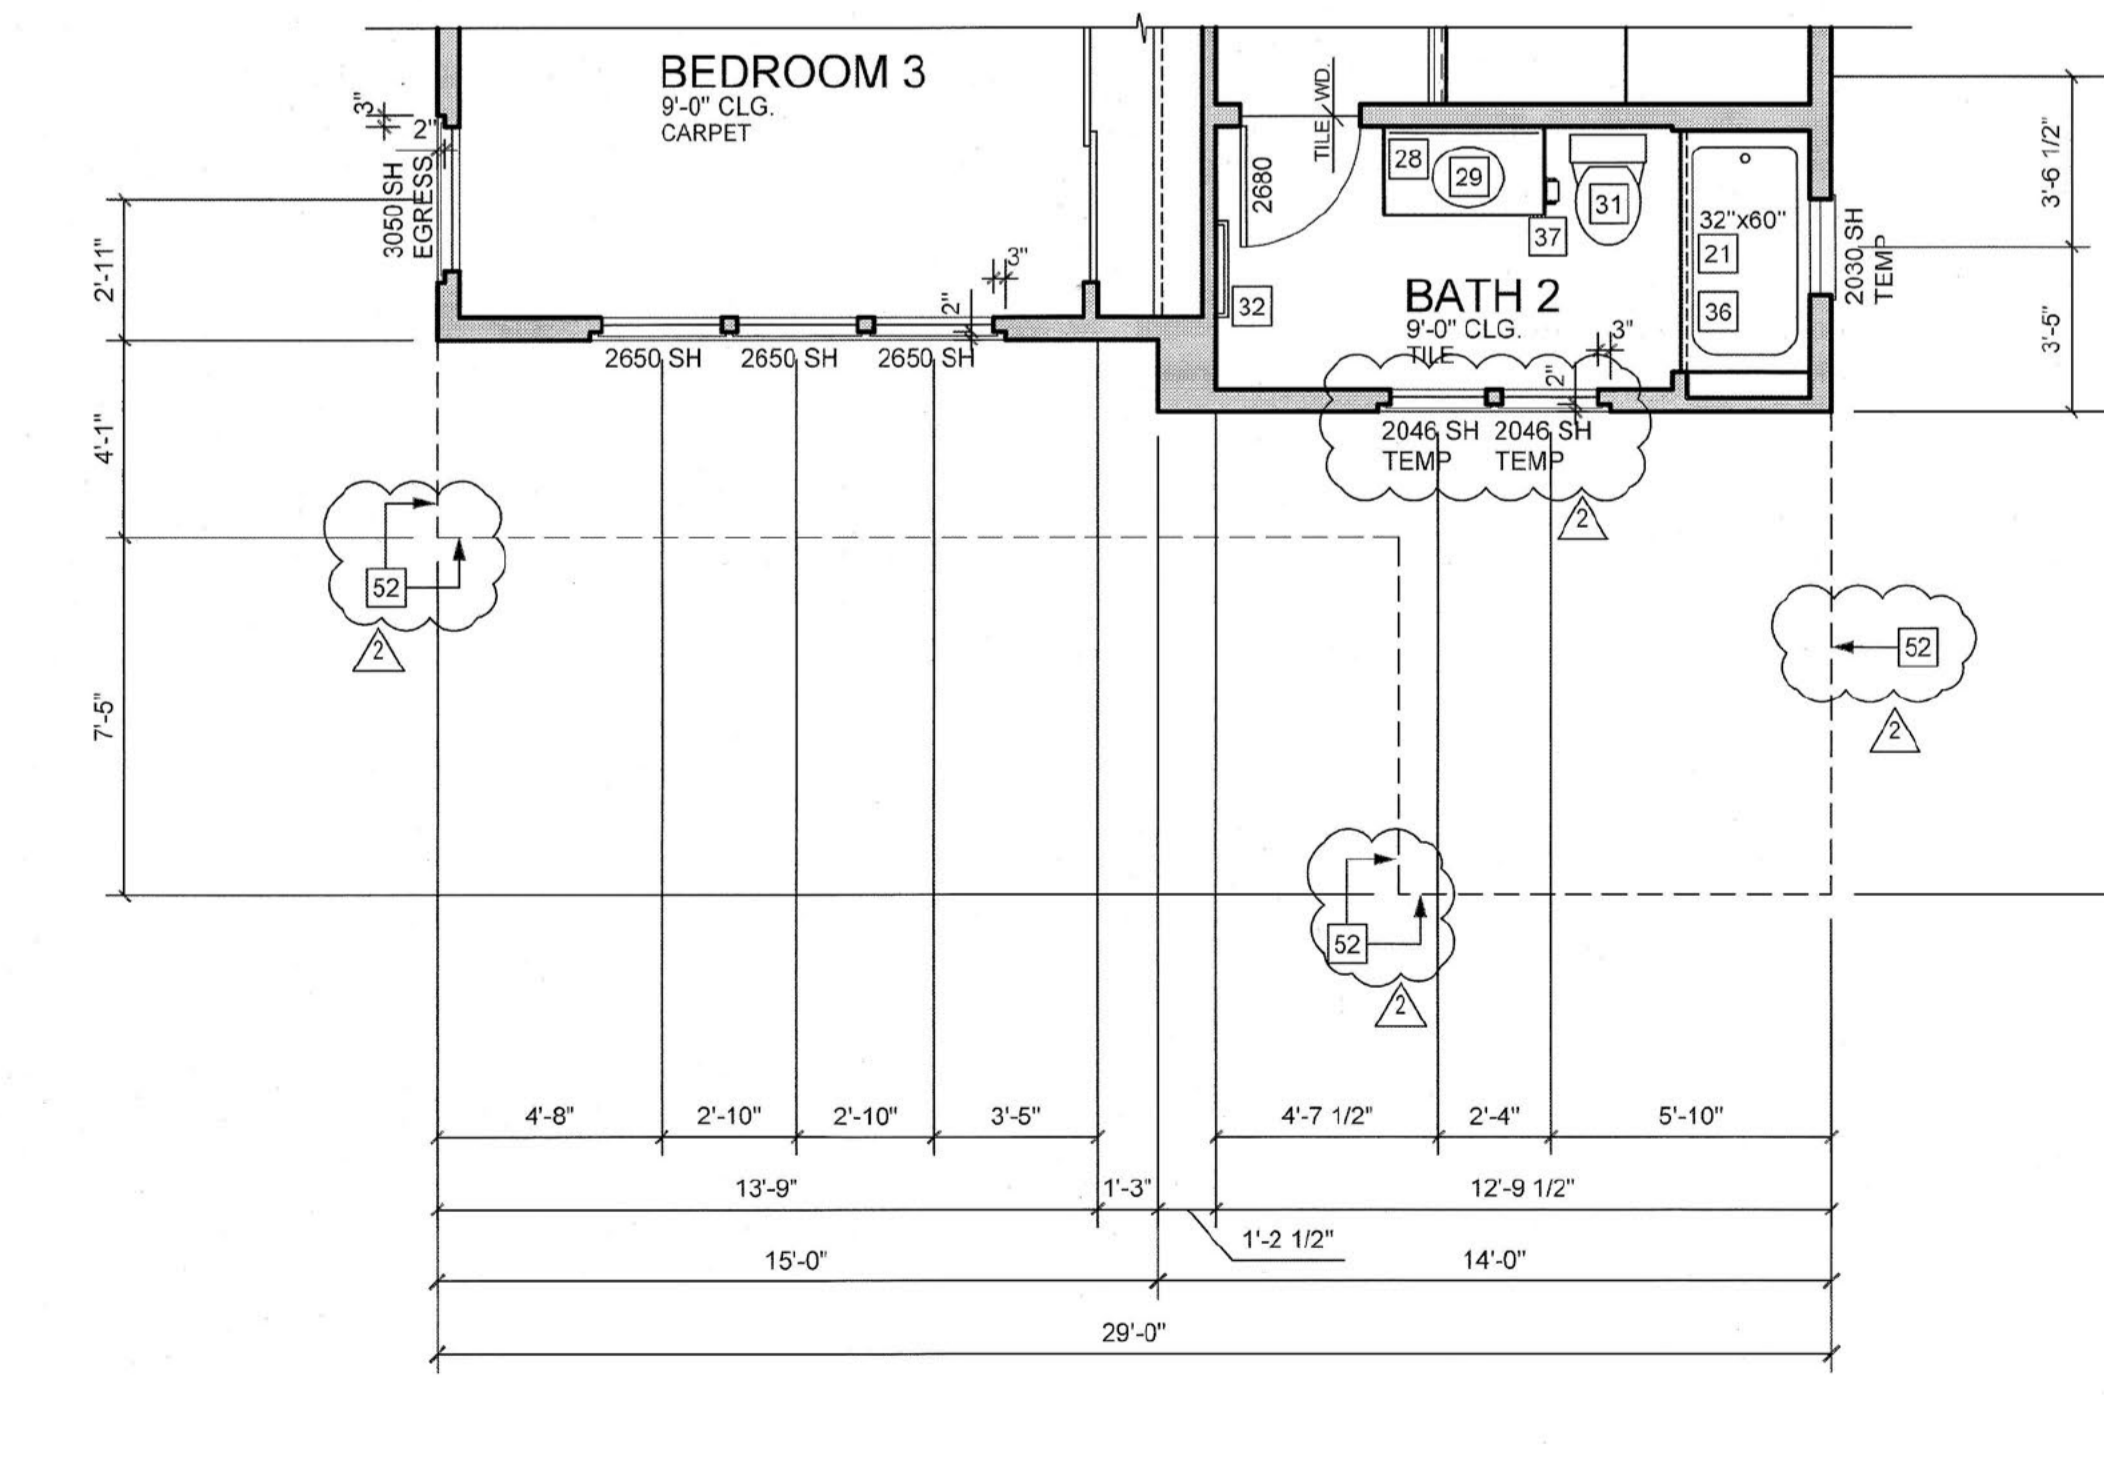

SECOND FLOOR PARTIAL @ PLAN B
SCALE 1/4" = 1'-0"

KEYNOTE LEGEND

1. DISHWASHER W/ DRAIN TO GARAGE DISPOSAL. (VERIFY DIMS W/ MFR)
2. BENCH SEAT W/ GARAGE DISPOSAL & METAL HOT WATER DISPENSER AT ISLAND. SEE DET. 71AD. 1" MAX FLOW 1 GPM @ 90 PSI CGC 4.303.1.4.1
3. REFRIGERATOR OR FREEZER. COLD WATER STUB-OUT FOR ICE MAKER. VERIFY SIZE W/ MANUFACTURER'S
4. BUILT-IN MICROWAVE OVEN IN CABINET. VERIFY DIMS W/ MFR
5. SINK IN KITCHEN/ENCL. COMBINATION W/ WOOD. UPPER AND LOWER. VENT TO EXT. & PROVIDE BACKDRAFT DAMPER.
6. PANTRY W/ FIXED SHELVES. (VERIFY NUMBER)
7. NA
8. STACKED WASHER AND DRYER. PROVIDE HOT & COLD WATER SUPPLY & WASTE LINE FOR WASHER. PROVIDE SMOOTH METAL VENT TO EXTERIOR. FOR DRYER, PROVIDE GSM PAN W/ DRAIN TO OUTSIDE AT ALL UPPER FLOOR LOCATIONS.
9. NA
10. ATTIC F.A.U. PROVIDE COMBUSTION AIR VENT TO OUTSIDE & SETBACK THERMISTAT. (FOR ATTIC F.A.U. SEE DET. 81AD.1)
11. NA
12. UNLESS WATER HEADER IS 1/2" MIN. DIA. W/ 1/2" MIN. THICKNESS, PROVIDE 1/2" MIN. DIA. W/ 1/2" MIN. THICKNESS. (FOR ATTIC F.A.U. SEE DET. 81AD.1)
13. 1/2" MIN. DIA. W/ 1/2" MIN. THICKNESS. (FOR ATTIC F.A.U. SEE DET. 81AD.1)
14. 1/2" MIN. DIA. W/ 1/2" MIN. THICKNESS. (FOR ATTIC F.A.U. SEE DET. 81AD.1)
ROOF PLAN NOTES

1. ROOF PITCH SHALL BE AS FOLLOWS:
EXTERIOR SLOPE:
PLAN A: 3/8" (U.O.N.)
PLAN B: 5/12" (U.O.N.)
2. OVERHANG DIMENSIONS ARE AS FOLLOWS:
PLAN A: EAVE: 6" (U.O.N.) RAKE: 6" (U.O.N.)
PLAN B: EAVE: 18" (U.O.N.) RAKE: 6" (U.O.N.)
3. DASHED LINES INDICATE WALL BELOW.
4. LOCATE GUTTERS AND DOWNSPOUTS AS SHOWN.
5. ALL ROOF DRAINAGE SHALL BE PIPED TO STREET OR AN APPROVED DRAINAGE FACILITY.
6. ALL PLUMBING VENTS SHALL BE COMBINED INTO A MINIMUM AMOUNT OF ROOF PENETRATIONS. ALL ROOF PENETRATIONS SHALL OCCUR TO THE REAR OF THE MAIN RIDGE. (SEE DETAILS 8 & 81AD.2)
7. TRUSS MANUFACTURER SHALL SUBMIT STRUCTURAL CALC'S & SHOP DRAWINGS TO THE ARCHITECT AND BUILDING DEPARTMENT PRIOR TO FABRICATION.
8. ATTIC VENTILATION SHALL BE PROVIDED PER 2013 CRC R309. (ALSO SEE CALCULATIONS ON THIS SHEET)
9. RADIAN BARRIER REQUIRED CLIMATE ZONES 2-15. INSTALL PER APPENDIX D 2013 ENERGY EFFICIENCY MANUAL. ATTIC VENTILATION IS TO BE CALCULATED AS 1/150 METHOD W/ 30% UPPER VENTILATION. PER CENC 150 (C) 2.
10. LOCATE ALL ROOF VENTS AS SHOWN.
11. WHEN 1/300 CALC. USED, AT LEAST 40% AND NOT MORE THAN 50% OF THE REQUIRED VENTILATING AREA SHALL BE PROVIDED IN THE UPPER PORTION OF THE ATTIC OR RAFTER SPACE. UPPER VENTILATORS SHALL BE LOCATED NO MORE THAN 3 FEET BELOW THE RIDGE OR HIGHEST POINT OF THE SPACE UNLESS FRAMING MEMBERS CONFLICT.

ATTIC VENTILATING CALCULATIONS

PLAN A					
AREA 'A' REQUIRED					
AREA VENTILATED	RATE	REQ'D UPPER	REQ'D LOWER	TOTAL REQUIRED	
1050 SQ. FT.	300 TH	252 SQ. IN.	252 SQ. IN.	504 SQ. IN.	
AREA 'A' PROVIDED					
TYPE	QUANTITY	AREA PER UNIT	TOTAL AREA PROVIDED	TOTAL UPPER VENTILATION	
U O'Hagin Concrete 'S' Tile Vent Locate in upper portion of roof	3	97.50 SQ. IN.	292.50 SQ. IN.	292.50 SQ. IN.	
TOTAL LOWER VENTILATION					
L O'Hagin Concrete 'S' Tile Vent Locate in lower portion of roof	3	97.50 SQ. IN.	292.50 SQ. IN.	292.50 SQ. IN.	
L Vented Frieze Blocking Locate in eave	10	7 SQ. IN.	70 SQ. IN.	70 SQ. IN.	
				TOTAL VENTING PROVIDED	
				655 SQ. IN.	
PLAN B					
AREA 'A' REQUIRED					
AREA VENTILATED	RATE	REQ'D UPPER	REQ'D LOWER	TOTAL REQUIRED	
292 SQ. FT.	300 TH	238 SQ. IN.	238 SQ. IN.	476 SQ. IN.	
AREA 'A' PROVIDED					
TYPE	QUANTITY	AREA PER UNIT	TOTAL AREA PROVIDED	TOTAL UPPER VENTILATION	
U O'Hagin Concrete 'S' Tile Vent Locate in upper portion of roof	3	97.50 SQ. IN.	292.50 SQ. IN.	292.50 SQ. IN.	
TOTAL LOWER VENTILATION					
L O'Hagin Concrete 'S' Tile Vent Locate in lower portion of roof	3	97.50 SQ. IN.	292.50 SQ. IN.	292.50 SQ. IN.	
L Vented Frieze Blocking Locate in eave	18	7 SQ. IN.	126 SQ. IN.	126 SQ. IN.	
				TOTAL VENTING PROVIDED	
				711 SQ. IN.	

- NOTES:
- PROVIDE A VAPOR RETARDER HAVING A ONE PERM MAX.
 - TRANSMISSION RATE ON THE WARM SIDE OF THE ATTIC INSULATION AT ALL ATTICS W/ A 1/300 VENTILATION RATE.
 - VENTED FRIEZE BLOCKS = 7 SQ. IN. IN FREE VENTING PER BLOCK W/ (3) - 2 IN. DIA. HOLES
 - VENT FRIEZE BLOCKS WHERE POSSIBLE

FLOOR PLAN NOTES

1. ALL EXTERIOR DIMENSIONS TO FACE OF STUD, FACE OF FOUNDATION, & FACE OF STOREFRONT (U.O.N.)
2. ALL INTERIOR DIMENSIONS TO FACE OF STUD (U.O.N.)
3. ALL DIMENSIONS AT WINDOWS & DOORS ARE TO THE CENTERLINE (U.O.N.)
4. ALL DOOR JAMBS ON HINGE SIDE SHALL BE 4" U.O.N.
5. ALL ANGLED WALLS (OTHER THAN 90°) SHALL BE 45° U.O.N.
6. ALL EXTERIOR WALLS SHALL BE CONSTRUCTED OF 2X8 STUDS U.O.N. S.S.D.
7. ALL INTERIOR WALLS SHALL BE CONSTRUCTED OF 2X4 STUDS, U.O.N. S.S.D.
8. FOR TYP. CLOSET SHELVING, SEE DETAIL 20/AD.2
9. ALL TEMPERED GLASS SHALL BE AFFIXED WITH A PERMANENT LABEL PER 2013 CRC R308.1.
10. PROVIDE ACCUSTICAL PIPE WRAP AT ALL SECOND FLOOR WASTE LINES.
11. TILE INSTALLATION SHALL COMPLY W/ APPLICABLE SECTIONS OF THE TILE COUNCIL OF NORTH AMERICA'S "HANDBOOK FOR CERAMIC TILE INSTALLATION" AND ITS REFERENCED STANDARDS.
12. ALL COUNTERTOPS, TUB DECKS & WALLS AT TUBS & SHOWERS SHALL HAVE SMOOTH, HARD, NONABSORBENT SURFACE OF CEMENTITIOUS BACKER BOARD AND A MOISTURE RESISTANT UNDERLAYMENT TO A HEIGHT OF 1/2" ABOVE FLOOR PER 2013 CRC R307.2
13. PROVIDE BACKINGS FOR ALL WALL AND CEILING MOUNTED CABINETS, FIXTURES, CABINETS, BRACKET, GRAB BARS, ETC. AS REQUIRED. COORDINATE WITH SUPPLIERS FOR REQUIREMENTS.
14. CALCULATIONS AND DETAILS FOR MOUNTING HANDRAILS & CONNECTION OF GUARDRAILS SHALL BE PROVIDED FOR REVIEW AND APPROVAL BY RAILING FABRICATOR PRIOR TO INSTALLATION FOR COMPLIANCE WITH 2013 CRC TABLE R301.5
15. VERIFY APPLIANCE DIMENSIONS PRIOR TO CABINET FABRICATION.
16. 1 LAYER 1/2" GYP. BD. ON ALL WALLS OF GARAGE. 2013 CRC TABLE R302.6


REVISIONS

- 1. 1ST CITY PLAN CHECK 08-01-16
- 2. IN-HOUSE REVISIONS 08-01-16


BUILDING DEPARTMENT SUBMITTAL 1

SECOND FLOOR & ROOF PLANS
SCALE 1/4" = 1'-0"

JOB NO. 1249.001 SHEET
DRAWN MWS / AMF / RG
CHECK
DATE 08-01-16 **A1.02**

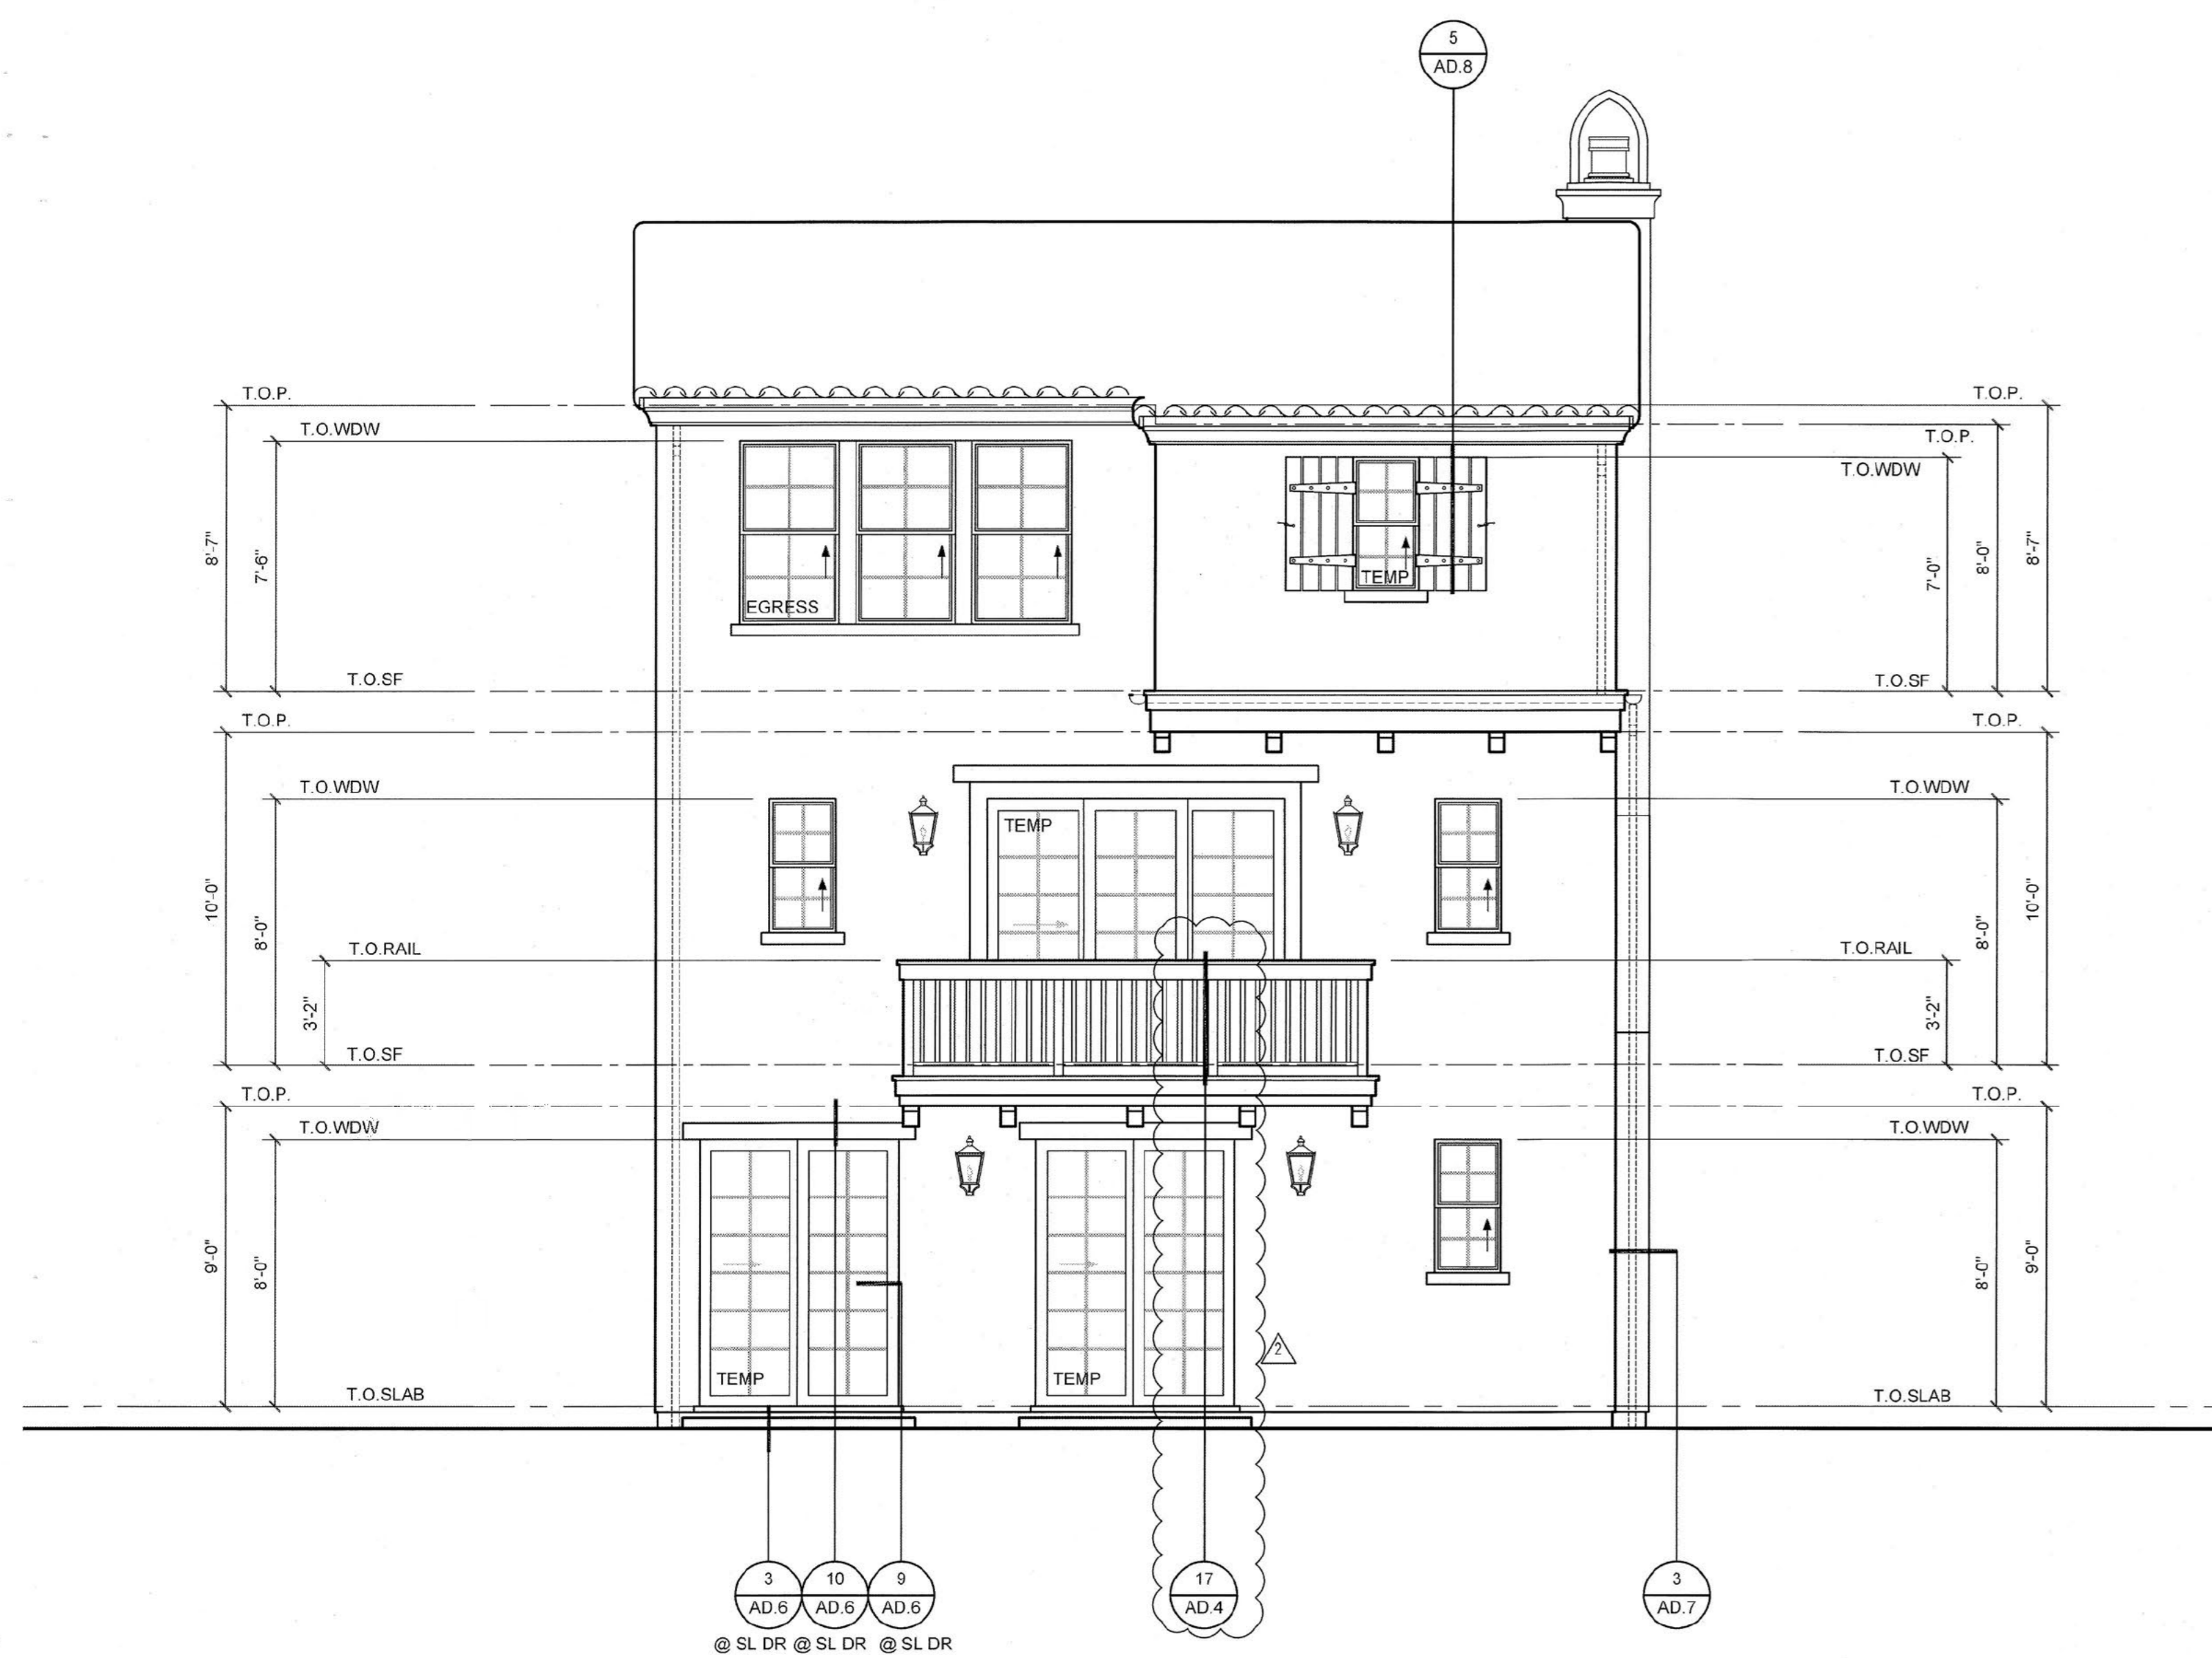


3 REAR ELEVATION 'A'
SCALE: 1/4" = 1'-0"

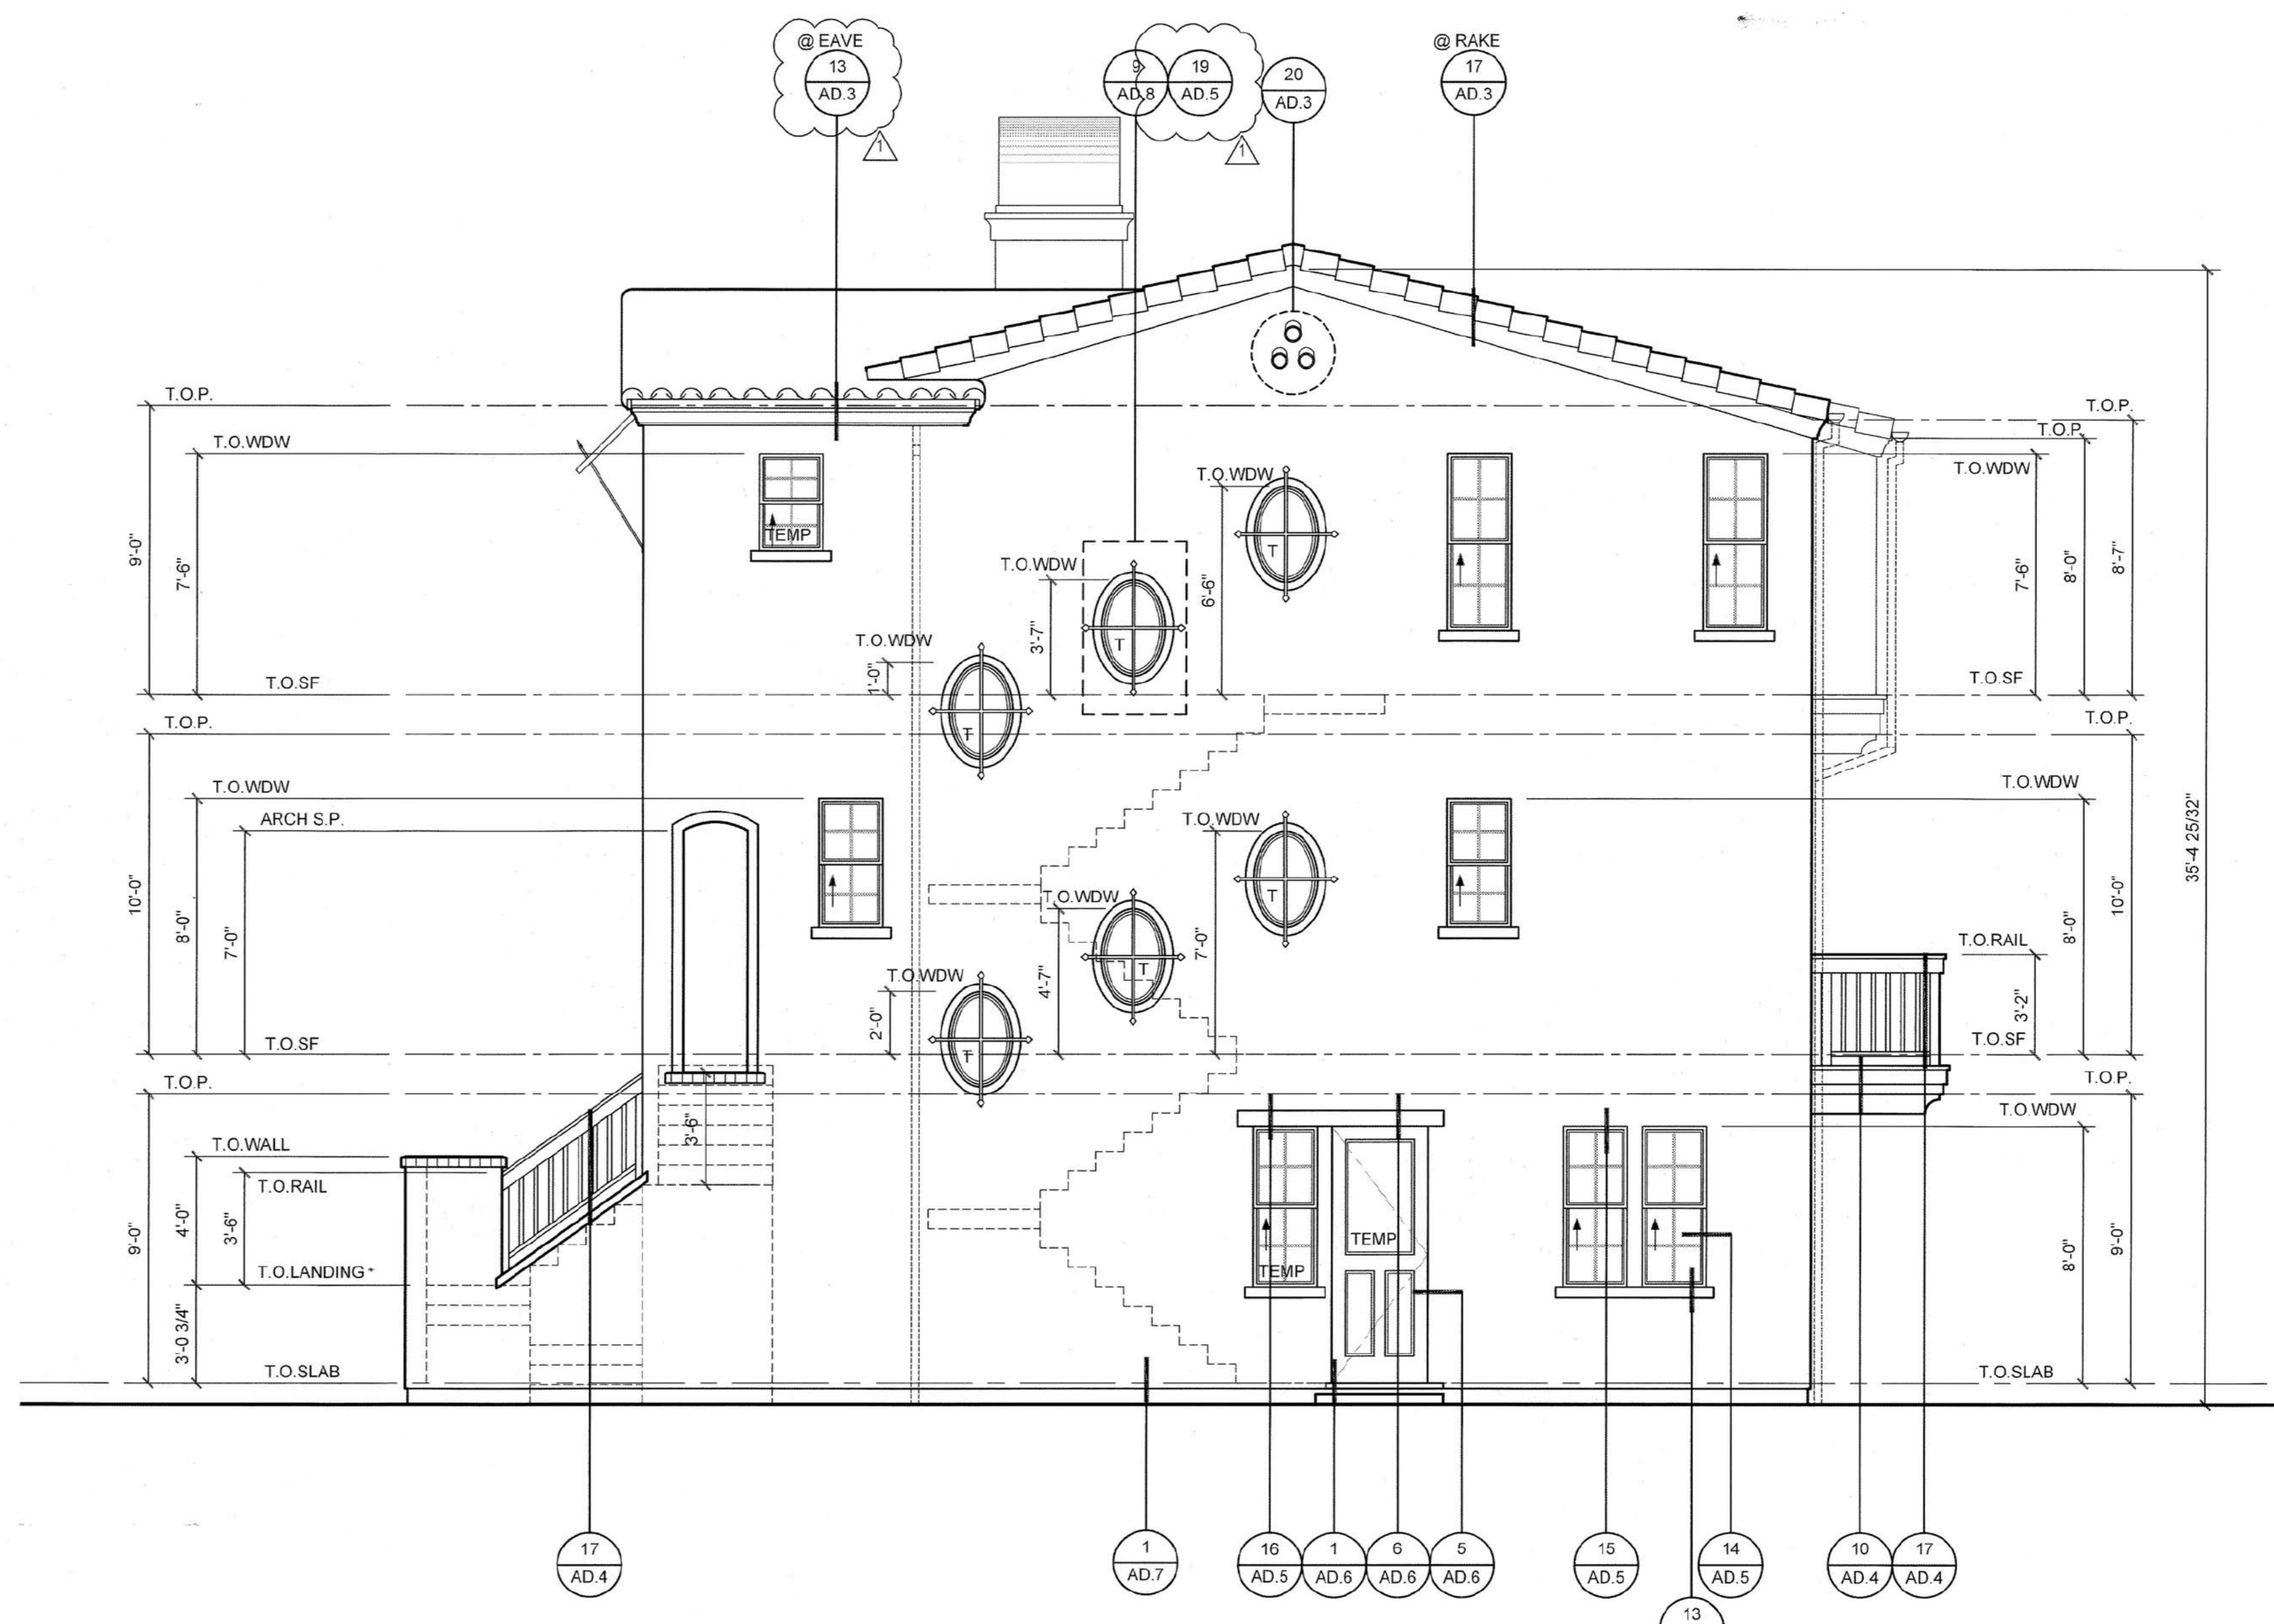

2 RIGHT ELEVATION 'A'
SCALE: 1/4" = 1'-0"



4 LEFT ELEVATION 'A'
SCALE: 1/4" = 1'-0"

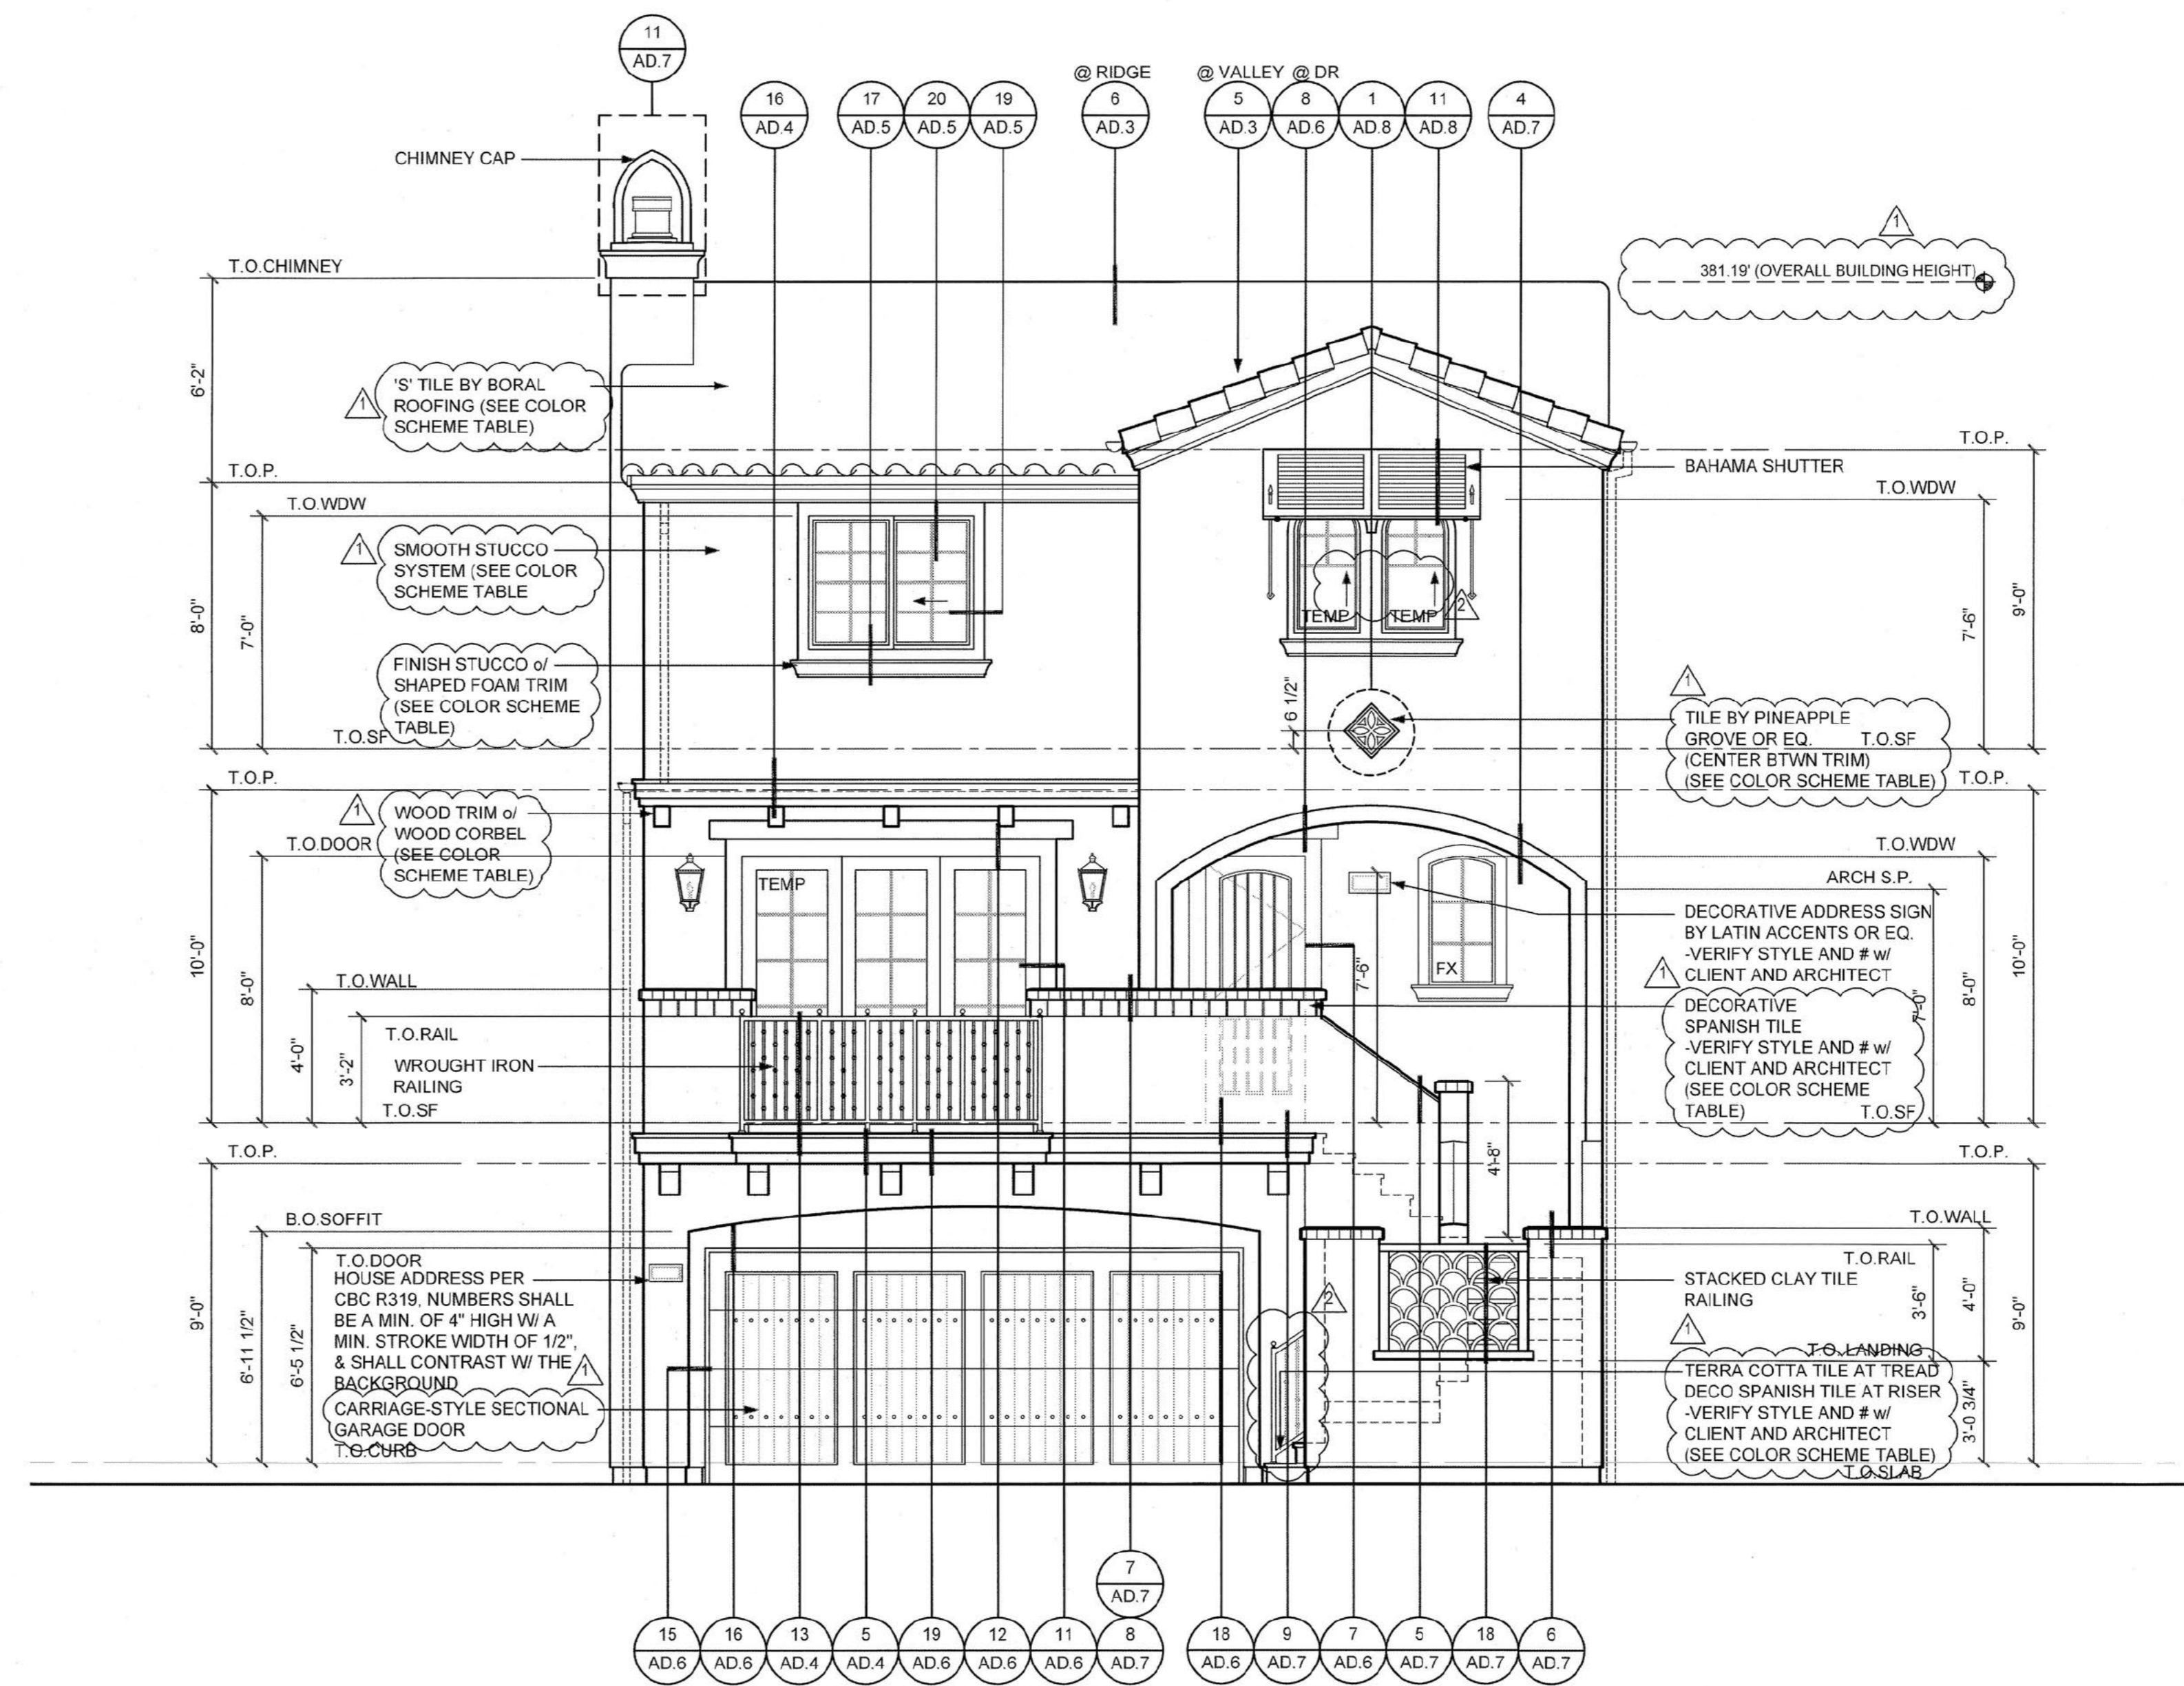

1 FRONT ELEVATION 'A'
SCALE: 1/4" = 1'-0"

EXTERIOR ELEVATION NOTES

- FOR TYPICAL FLASHING AT WALL OPENINGS, SEE DET. 1/AD.5
- FOR TYPICAL WALL PENETRATIONS, SEE DET. 10/AD.1 & 11/AD.5
- FOR TYPICAL PLASTER JOINT APPLICATION, SEE DET. 11/AD.5
- FOR TYPICAL FOAM APPLICATION SEE DET. 12/AD.5
- FOR TYPICAL MASONRY APPLICATION SEE MFR'S SPECIFICATIONS
- SEE FLOOR PLANS FOR GLAZING INFORMATION
- EXTERIOR FINISH SHALL BE:
 - 7/8" SMOOTH TROWEL 3-COAT STUCCO W/ WIRE MESH OVER 2 LAYERS OF 90 MIN. GRADE 15 PAPER OR SHEATHING (WHERE OCCURS, S.S.D.) SHEATHING SHALL HAVE 1/8" GAP BETWEEN PANELS
- SPANISH TILE SHALL BE BY LATIN ACCENTS OR EQ. VERIFY STYLE AND NUMBER WITH CLIENT. INSTALL PER MFR'S SPECIFICATIONS.
- BRICK SHALL BE BY ELBORADO STONE. VERIFY WITH CLIENT. INSTALL PER MFR'S SPECIFICATIONS.
- ROOF SHALL BE COVERED WITH A MINIMUM CLASS B ROOFING MATERIAL AS SET FORTH IN CRC SECTIONS R04 AND R05. ROOFING SHALL BE LISTED AND SHALL BE TESTED IN ACCORDANCE WITH UL 790 OR ASTM E109 (PLEASANTON MUNICIPAL CODE CH. 20.10.100) OR 30# FELT w/ SOLID SHTG. AND SHALL BE:
 - CONCRETE 'S' TILE ROOFING
- WINDOW HEAD HEIGHTS ARE AS FOLLOWS:
TYPICAL: 8'-0" (U.O.N.)
- SEAL ALL JOINTS AND PENETRATIONS IN THE BUILDING ENVELOPE PER SECTION 117 OF THE CALIFORNIA ENERGY CODE.
- TRIM - PAINT COLOR SHOULD BE APPLIED TO ALL EXPOSED SIDES OF TRIM NOT JUST THE FRONT FACE. DOWNSPOUTS TO MATCH BODY COLOR OR TRIM IF THEY ARE APPLIED OVER.
- HOUSE ADDRESS PER CRC R319, NUMBERS SHALL BE A MIN. OF 4" HIGH WITH A MIN. STROKE WIDTH OF 1/2", AND SHALL CONTRAST WITH THEIR BACKGROUND.
- ANY CARPENTER BEING INSTALLED ON THE FIREPLACE CHIMNEY SHALL COMPLY WITH THE I.C.C.-ES RESEARCH REPORT OR EQUIVALENT AND MANUFACTURER'S LISTING.

COLOR SCHEME

- COLOR SCHEME 1**
- ROOF MATERIAL: TUSCANY BLEND CONCRETE 'S' TILE BY BORAL ROOFING
 - TRIM COLOR: FRENCH ROAST SW 6069 BY SHERWIN WILLIAMS
 - BODY COLOR: EXTRA WHITE SW 7006 BY SHERWIN WILLIAMS
 - WOOD STAIN COLOR: CHESTNUT SW 3524 BY SHERWIN WILLIAMS
 - ACCENT COLOR: COPPER MOUNTAIN SW 6566 BY SHERWIN WILLIAMS
 - DECORATIVE SPANISH TILE: VILLAFRANCA 5 TERRA NOVA MEDITERRANEO CERAMIC TILE BY TIERRA Y FUEGO (OR EQUAL)
 - DECORATIVE MEDALLION: MOUCHETTE MEDALLION 866 TERRA CLAY SCULPTSTONE FINISH BY PINEAPPLE GROVE DESIGNS (OR EQUAL)
- COLOR SCHEME 2**
- ROOF MATERIAL: PALERMO BLEND CONCRETE 'S' TILE BY BORAL ROOFING
 - TRIM COLOR: VAN DYKE BROWN SW 7041 BY SHERWIN WILLIAMS
 - BODY COLOR: EXTRA WHITE SW 7006 BY SHERWIN WILLIAMS
 - WOOD STAIN COLOR: CHARWOOD SW 3542 BY SHERWIN WILLIAMS
 - ACCENT COLOR: CHARWOOD SW 3542 BY SHERWIN WILLIAMS
 - DECORATIVE SPANISH TILE: PIACENZA TERRA NOVA MEDITERRANEO CERAMIC TILE BY TIERRA Y FUEGO (OR EQUAL)
 - DECORATIVE MEDALLION: ORB & LATTICE MEDALLION 062 TERRA CLAY SCULPTSTONE FINISH BY PINEAPPLE GROVE DESIGNS (OR EQUAL)

REVISIONS

- 1ST CITY PLAN CHECK 08-01-16
- IN-HOUSE REVISIONS 08-01-16

BUILDING DEPARTMENT SUBMITTAL 1
EXTERIOR ELEVATIONS 'A'
SCALE 1/4" = 1'-0"


JOB NO. 1249.001 SHEET

DRAWN MWS / AMF / RG


CHECK

DATE 08-01-16


A1.03

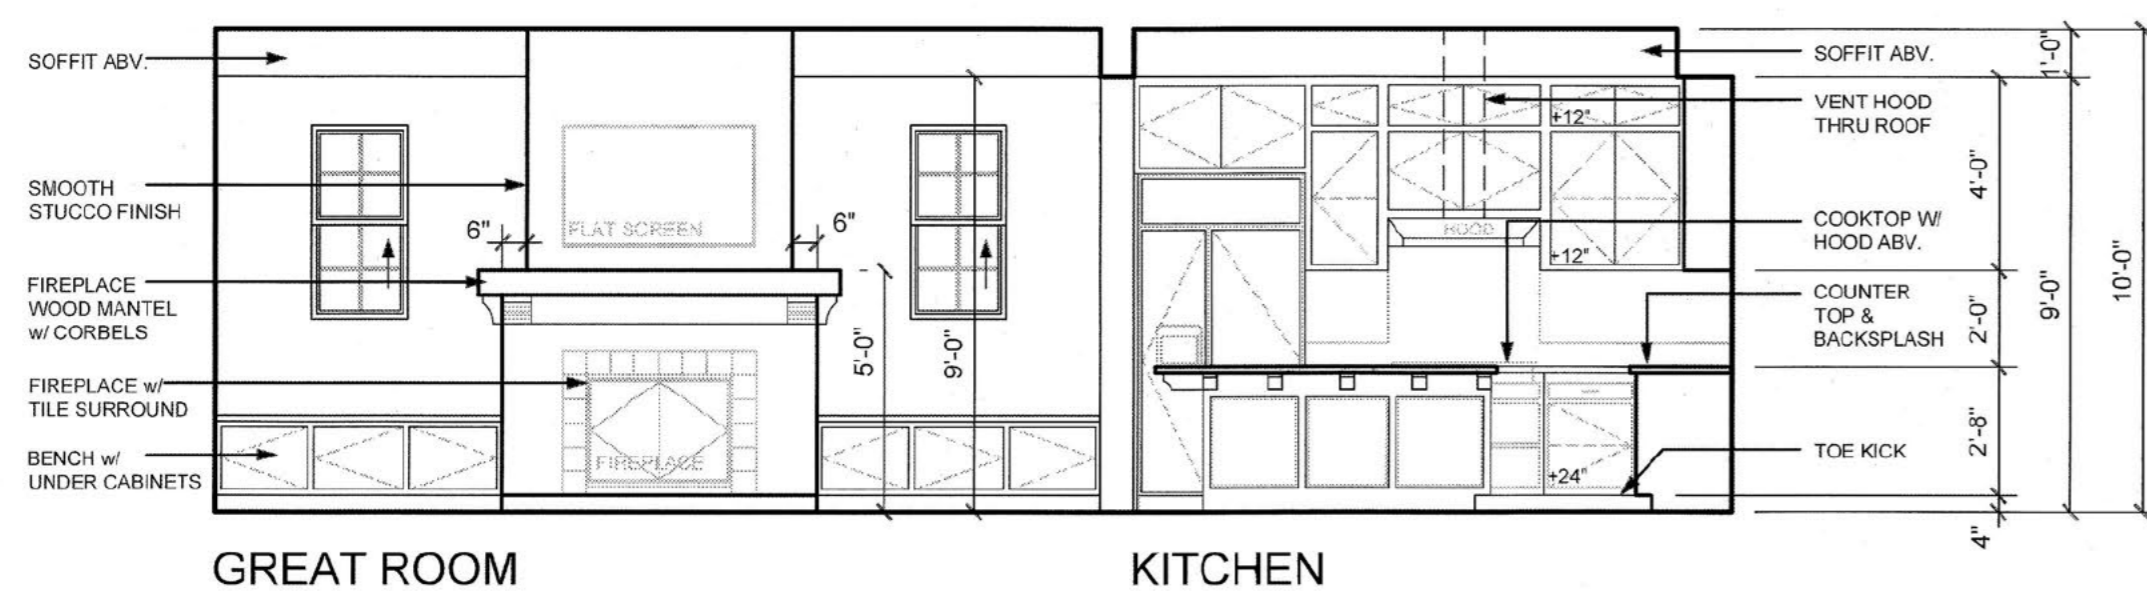


1 INTERIOR ELEVATION @ A
SCALE: 1/4"= 1'-0"

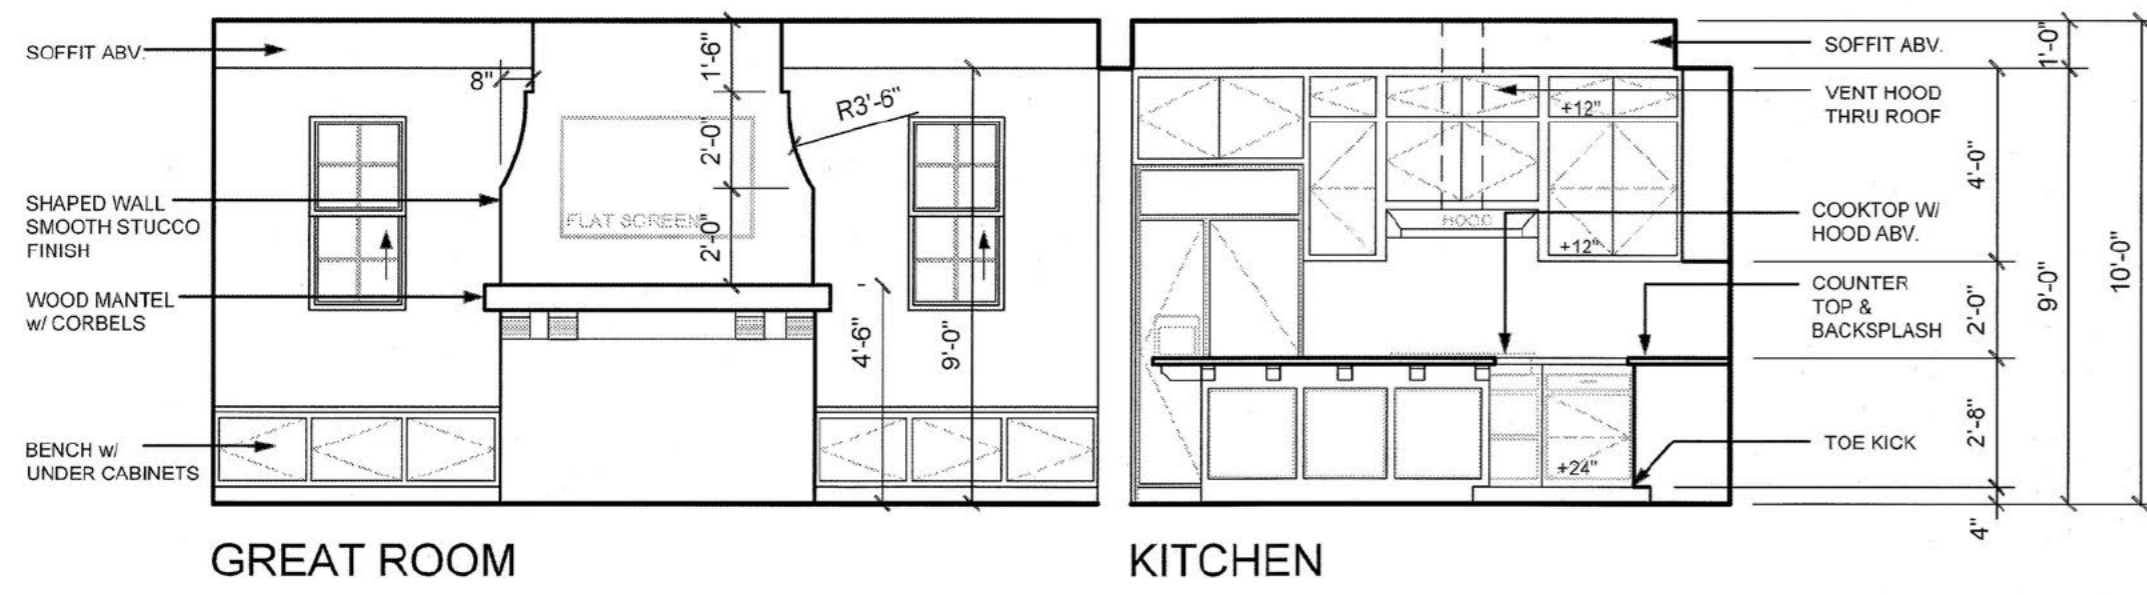

1 INTERIOR ELEVATION @ B
SCALE: 1/4"= 1'-0"

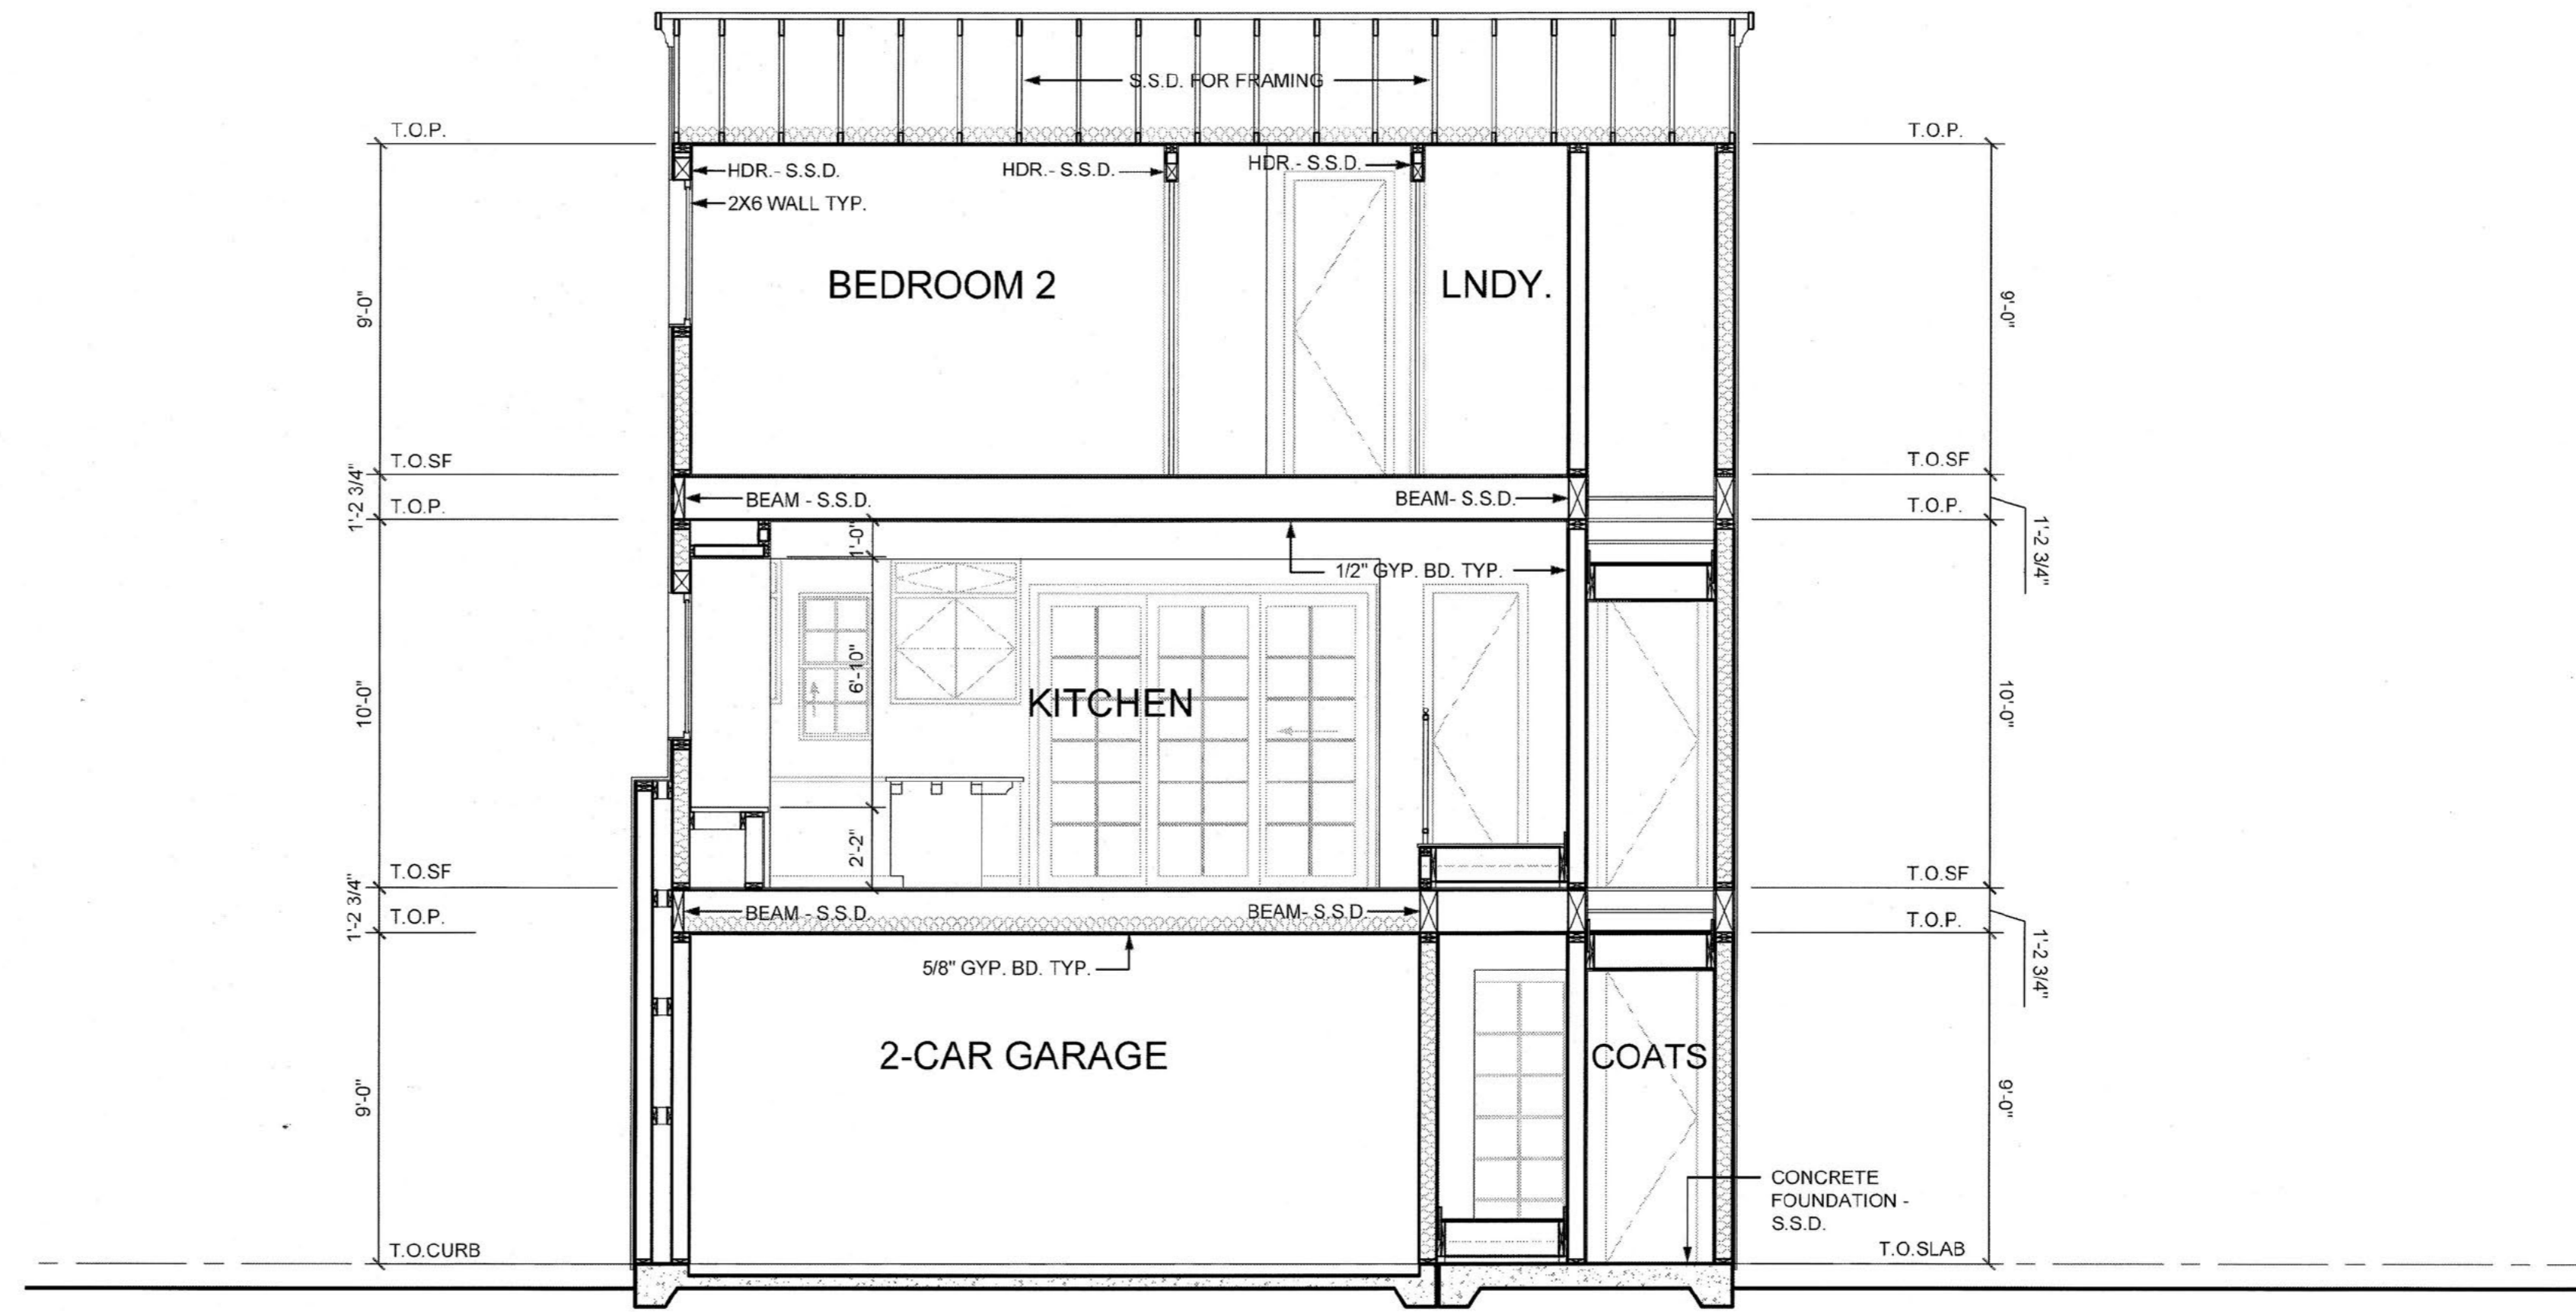

SECTION B
SCALE: 1/4"= 1'-0"

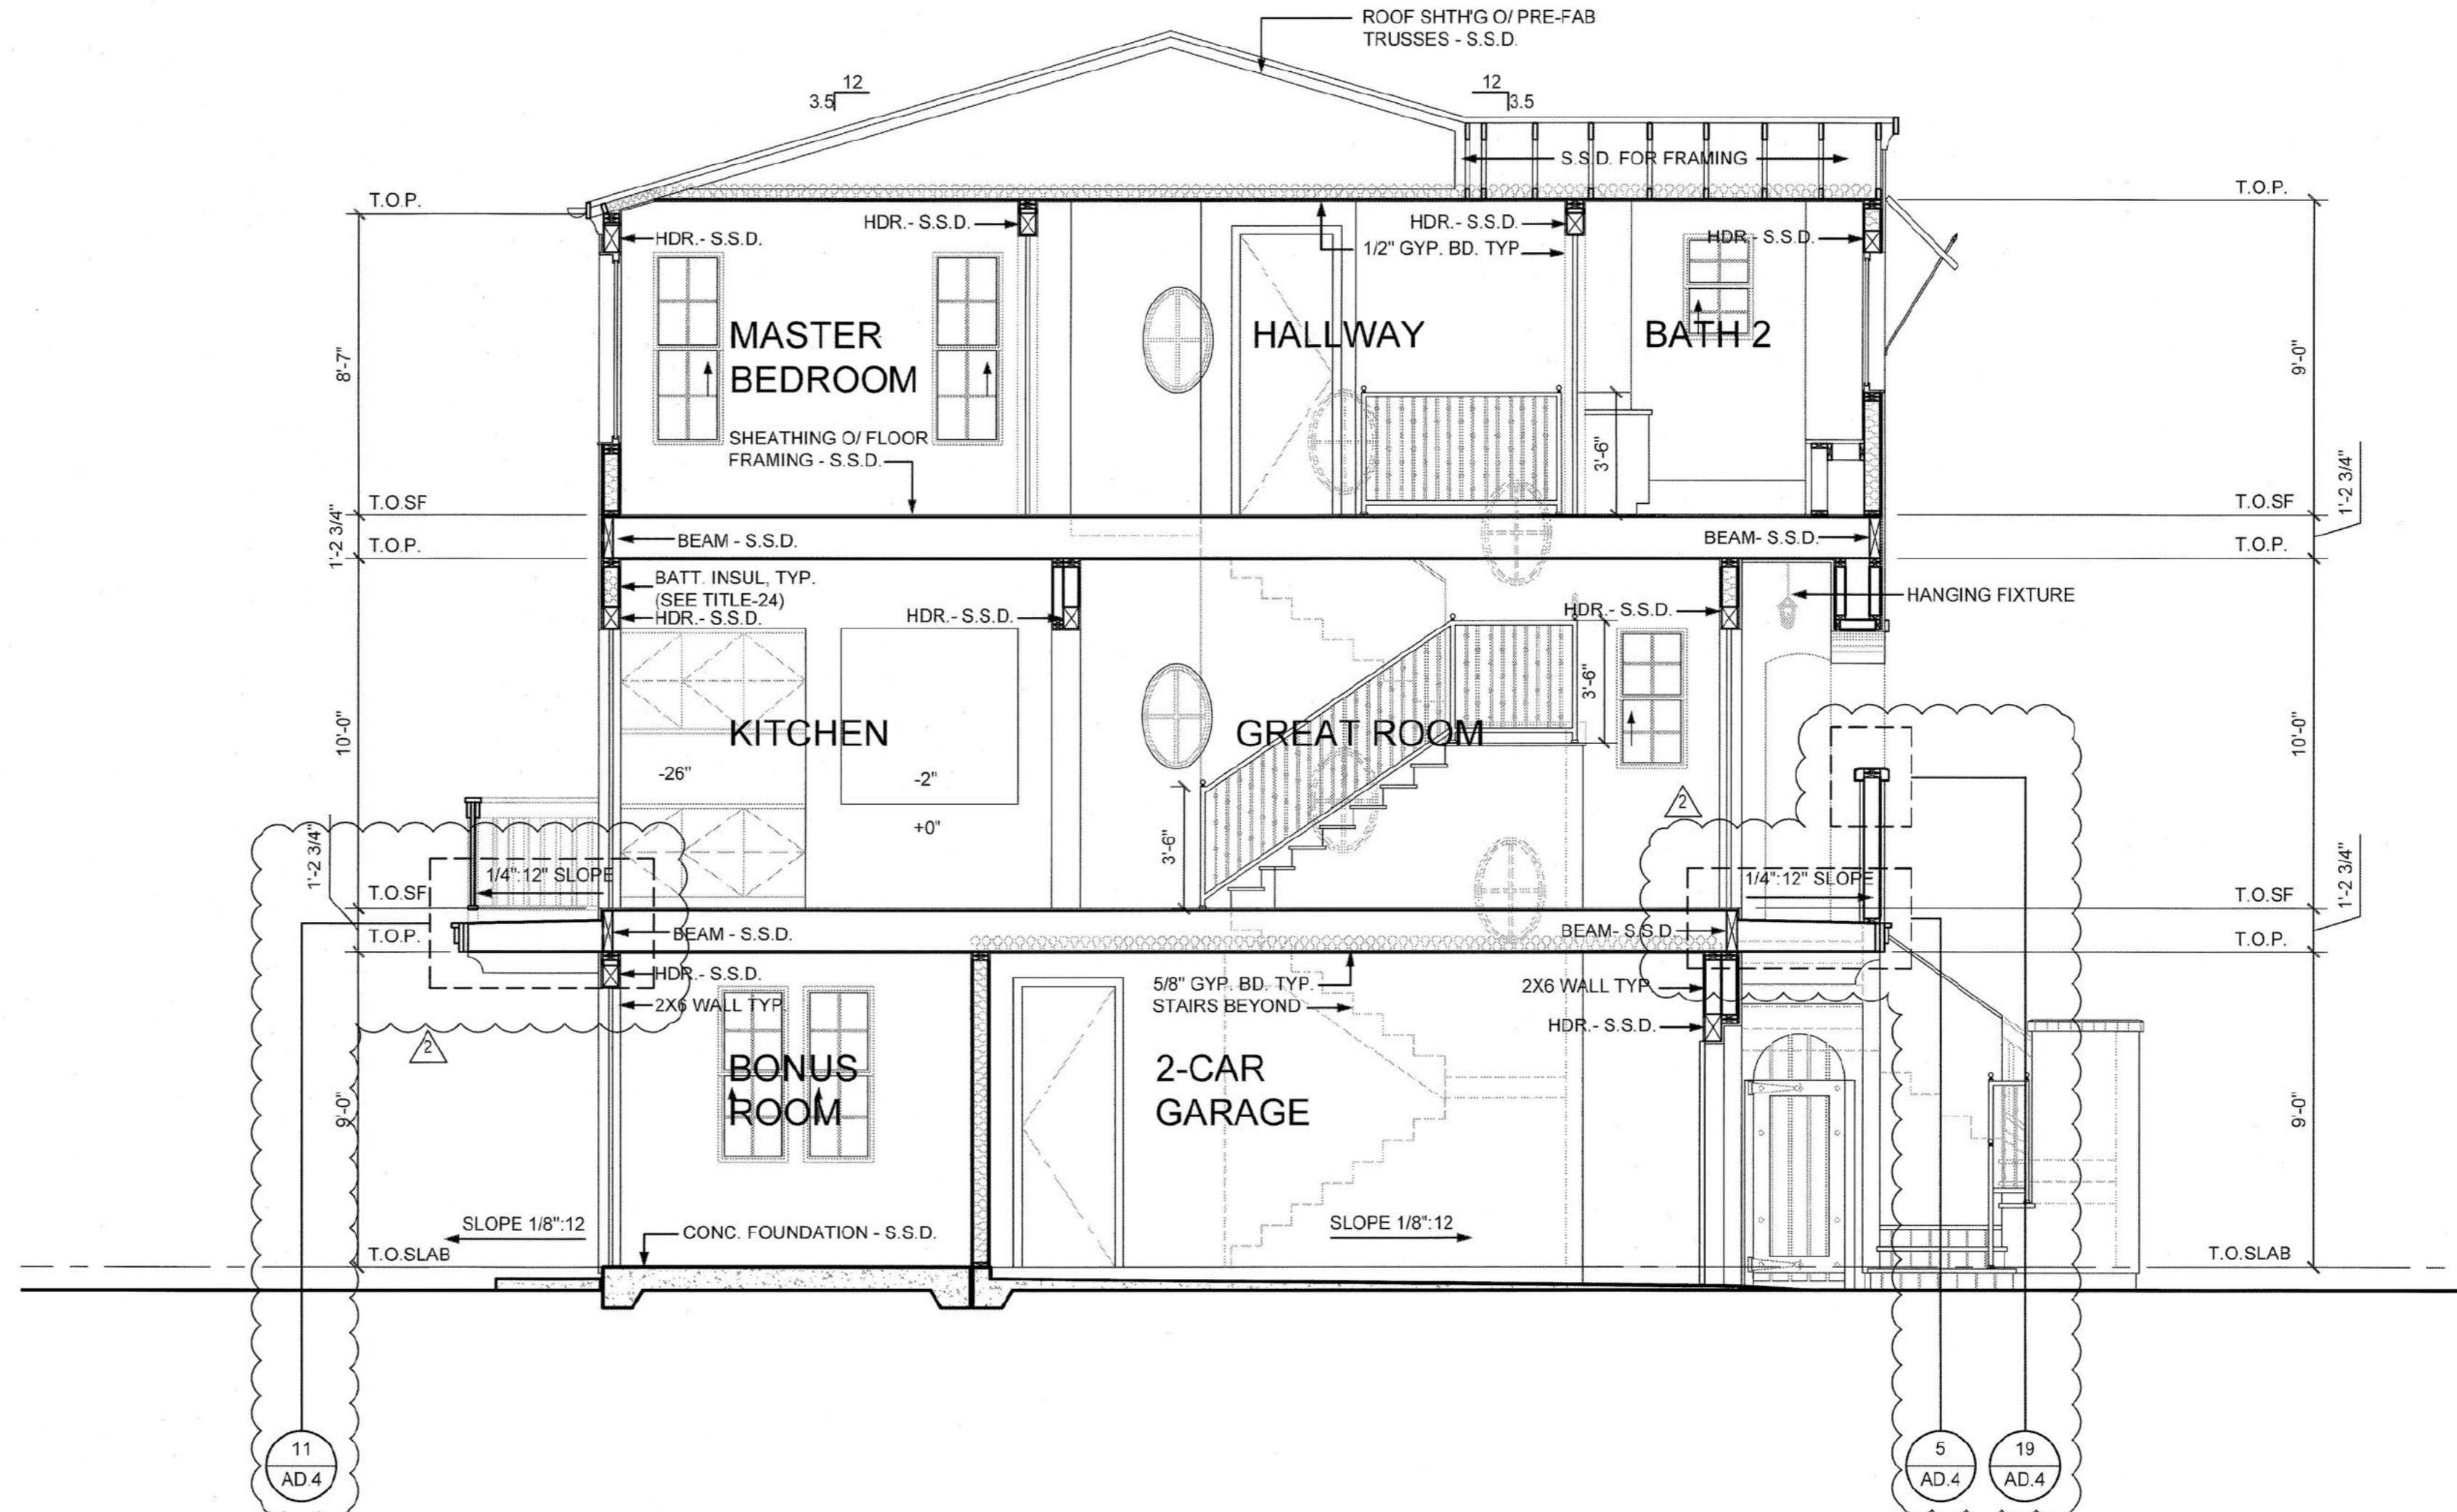

SECTION A
SCALE: 1/4"= 1'-0"

SECTION NOTES

1. FOR INSULATION REQUIREMENTS SEE TITLE 24 SHEET
2. TAPER INSULATION AT EAVE BLOCKS TO ALLOW AIR PASSAGE.
3. REFER TO STRUCTURAL DRAWINGS FOR LOCATION AND SIZES OF ALL BEAMS, HEADERS, JOISTS, RAFTERS, SHEAR WALLS, TRUSSES, CONCRETE SLABS, ETC.
4. LOCATE FIRE BLOCKING PER CRC R302.11
 1. IN CONCEALED SPACES OF STUD WALLS AND PARTITIONS, INCLUDING FURRED SPACES AND PARALLEL ROWS OF STUDS OR STAGGERED STUDS, AS FOLLOWS:
 - 1.1 VERTICALLY AT THE CEILING AND FLOOR LEVELS.
 - 1.2 HORIZONTALLY AT INTERVALS NOT EXCEEDING 10 FEET.
 2. AT ALL INTERCONNECTIONS BETWEEN CONCEALED VERTICAL AND HORIZONTAL SPACES SUCH AS OCCURS AT SOFFITS, DROP CEILING AND COVE CEILING.
 3. IN CONCEALED SPACES BETWEEN STAIR STRINGERS AT THE TOP AND BOTTOM OF THE RUN, ENCLOSED SPACES UNDER STAIRS COMPLY WITH SECTION R302.7.
 4. AT OPENINGS AROUND VENTS, PIPES, DUCTS, CABLES AND WIRES AT CEILING AND FLOOR LEVEL, WITH AN APPROVED MATERIAL TO RESIST THE FREE PASSAGE OF FLAME AND PRODUCTS OF COMBUSTION. THE MATERIAL FILLING THIS ANNULAR SPACE SHALL NOT BE REQUIRED TO MEET THE ASTM E 138 REQUIREMENTS. 1
 5. FOR FIREBLOCKING OF CHIMNEYS AND FIREPLACES, SEE SECTION R1003.19.
 6. FIREBLOCKING OF CORNICES OF A TWO-FAMILY DWELLING IS REQUIRED AT THE LINE OF DWELLING UNIT SEPARATION.
5. REFER TO MECHANICAL, ELECTRICAL AND PLUMBING DRAWINGS FOR LOCATION OF ALL EQUIPMENT, DUCTS, PIPING, CONDUIT, ETC. PROVIDE PROPER CLEARANCES AND BLOCKING FOR EACH AS REQUIRED.
6. PROVIDE BACKING FOR ALL MASONRY VENEER, STONE & CONCRETE MOLDINGS, WALL AND CEILING MOUNTED CABINETS, FIXTURES, & CABINETS, ETC. AS REQUIRED. COORDINATE WITH SUPPLIERS FOR REQUIREMENTS.
7. SEE ROOF PLAN FOR OVERHANG DIMENSIONS, VENT AND ACCESS LOCATIONS, AND ROOF DRAINAGE.

INTERIOR ELEVATION NOTES


1. ALL CABINETS ARE SHOWN DIAGMATIC FOR DESIGN INTENT ONLY. VERIFY ACTUAL CABINET CONSTRUCTION AND DIMENSIONS WITH DEVELOPER AND INTERIOR DESIGNER. VERIFY ALL HEIGHTS AND DIMENSIONS IN THE FIELD BEFORE FABRICATION AND INSTALLATION OF CABINETRY.
2. LIGHT FIXTURES TO BE SELECTED BY BUILDER
3. FOR INTERIOR GYP. BD. CORNER SEE DET. 19'AD.2

REVISIONS


- 1ST CITY PLAN CHECK 08-01-16
- IN-HOUSE REVISIONS 08-01-16

BUILDING DEPARTMENT SUBMITTAL 1
SECTIONS & INTERIOR ELEVATIONS.
SCALE 1/4"=1'-0"


JOB NO. 1249.001 SHEET
DRAWN MWS / AMF / RG
CHECK
DATE 08-01-16 **A1.05**

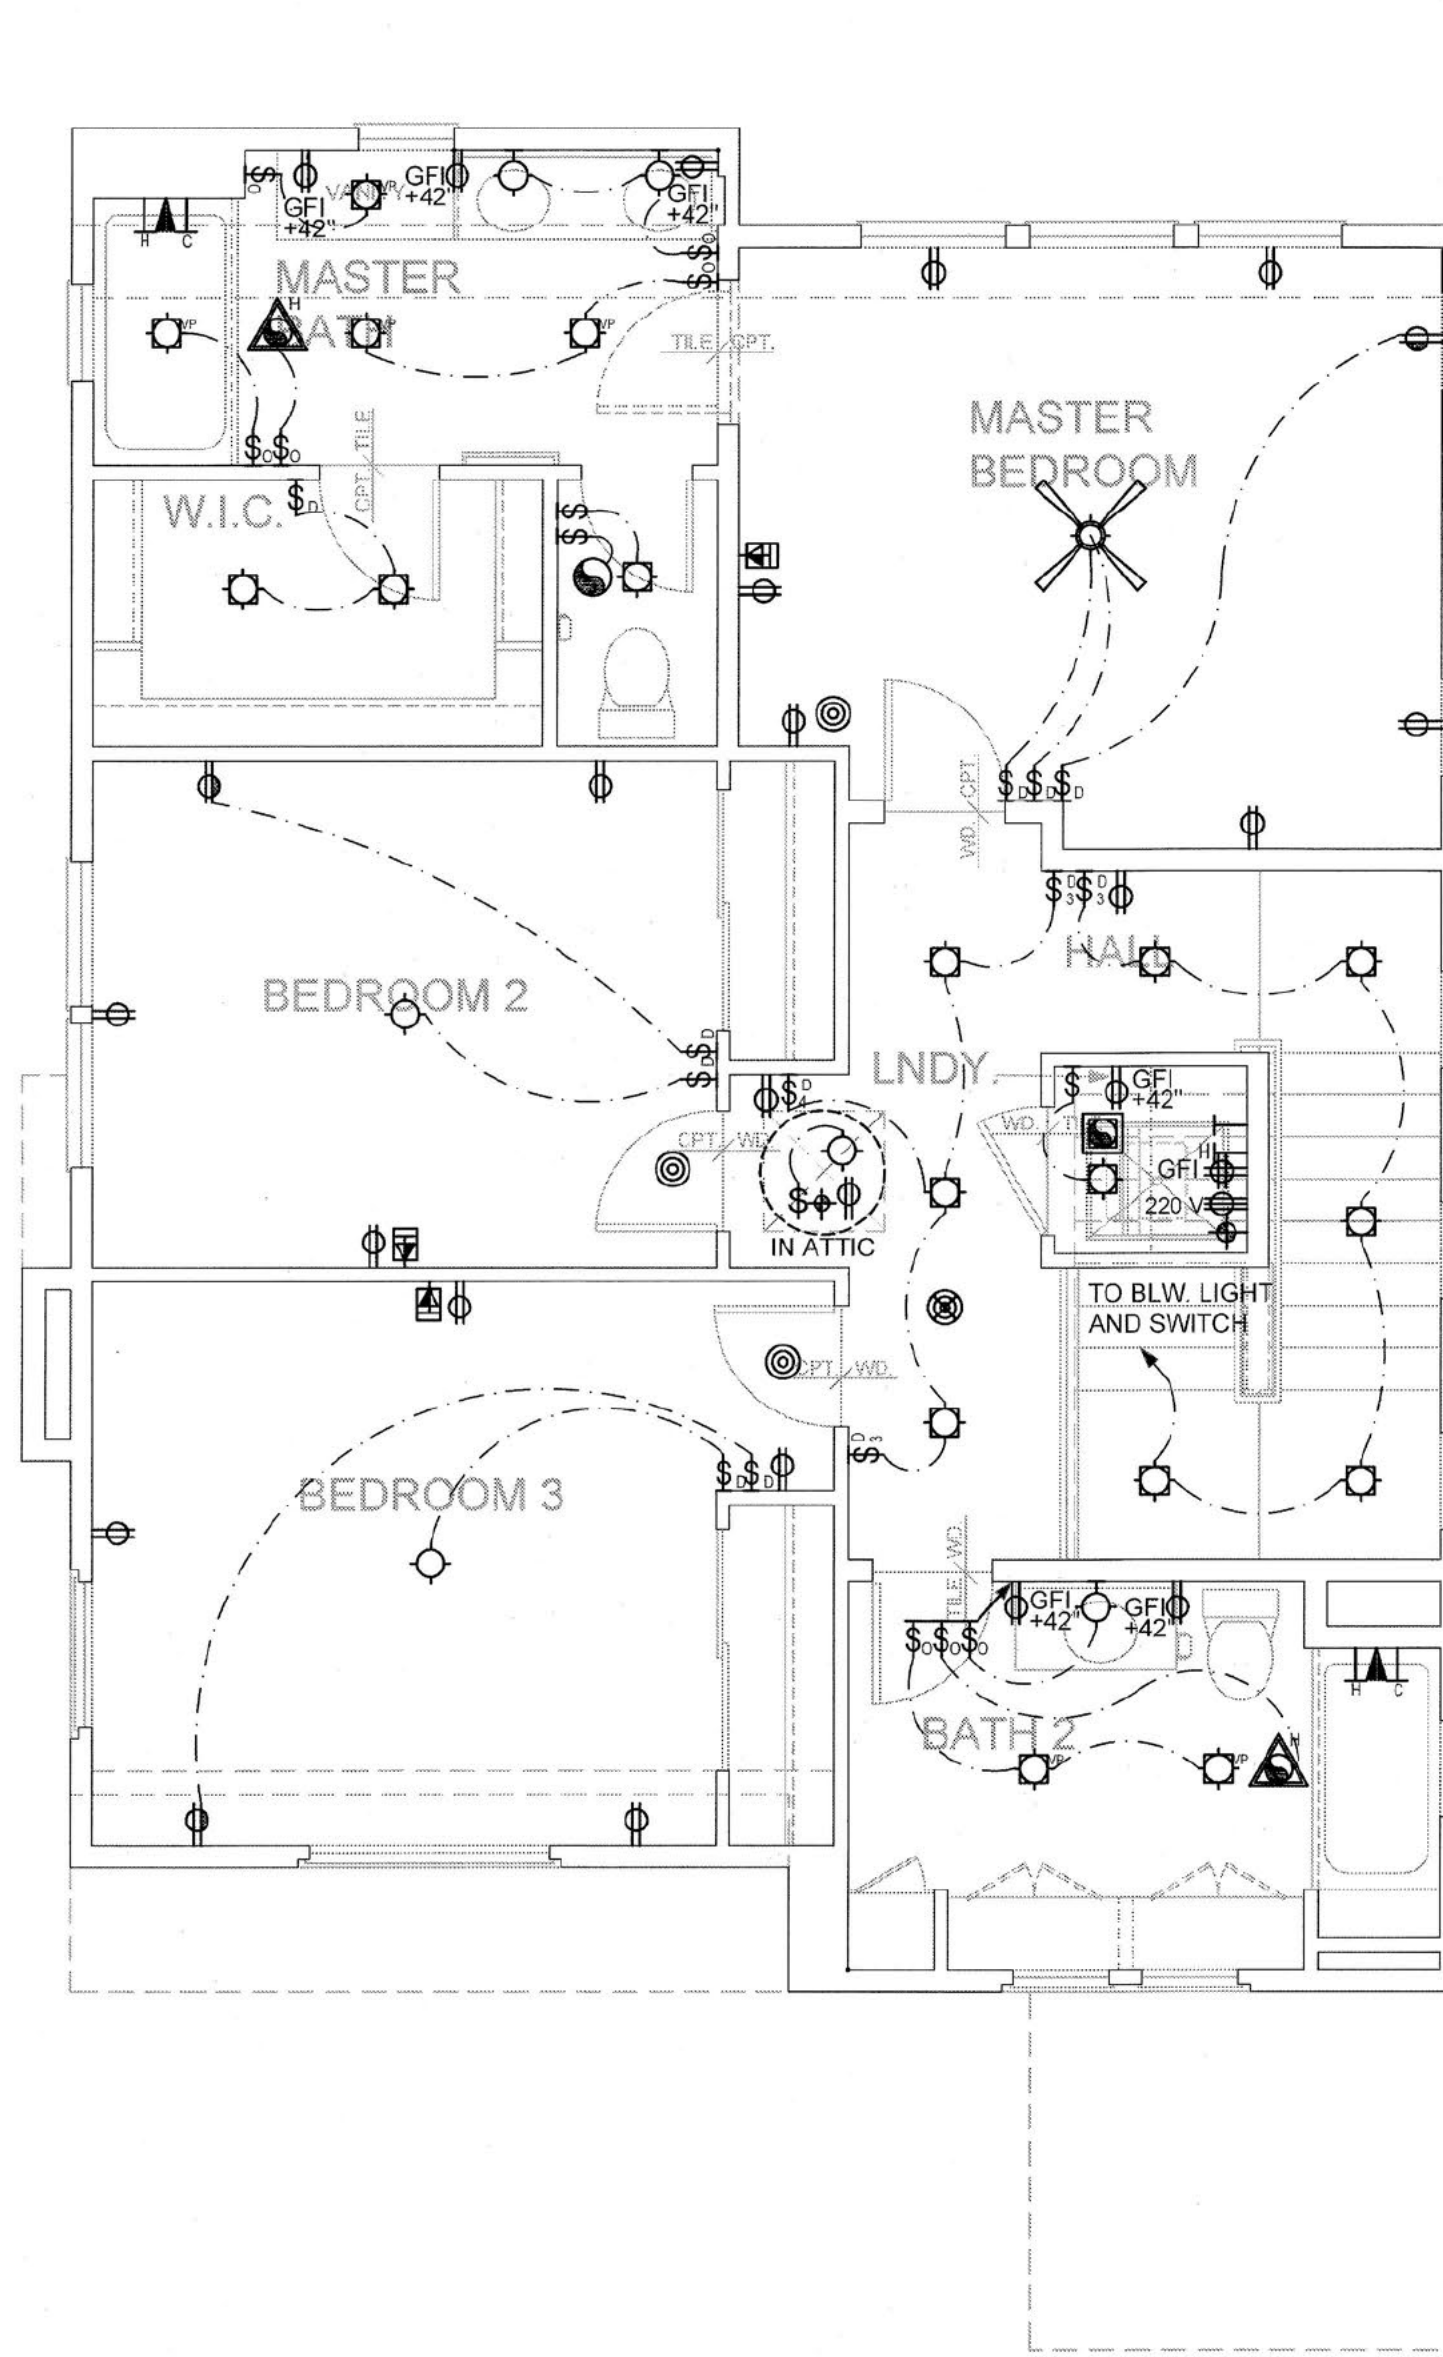


EMP SECOND FLOOR PLAN A
SCALE 1/4" = 1'-0"

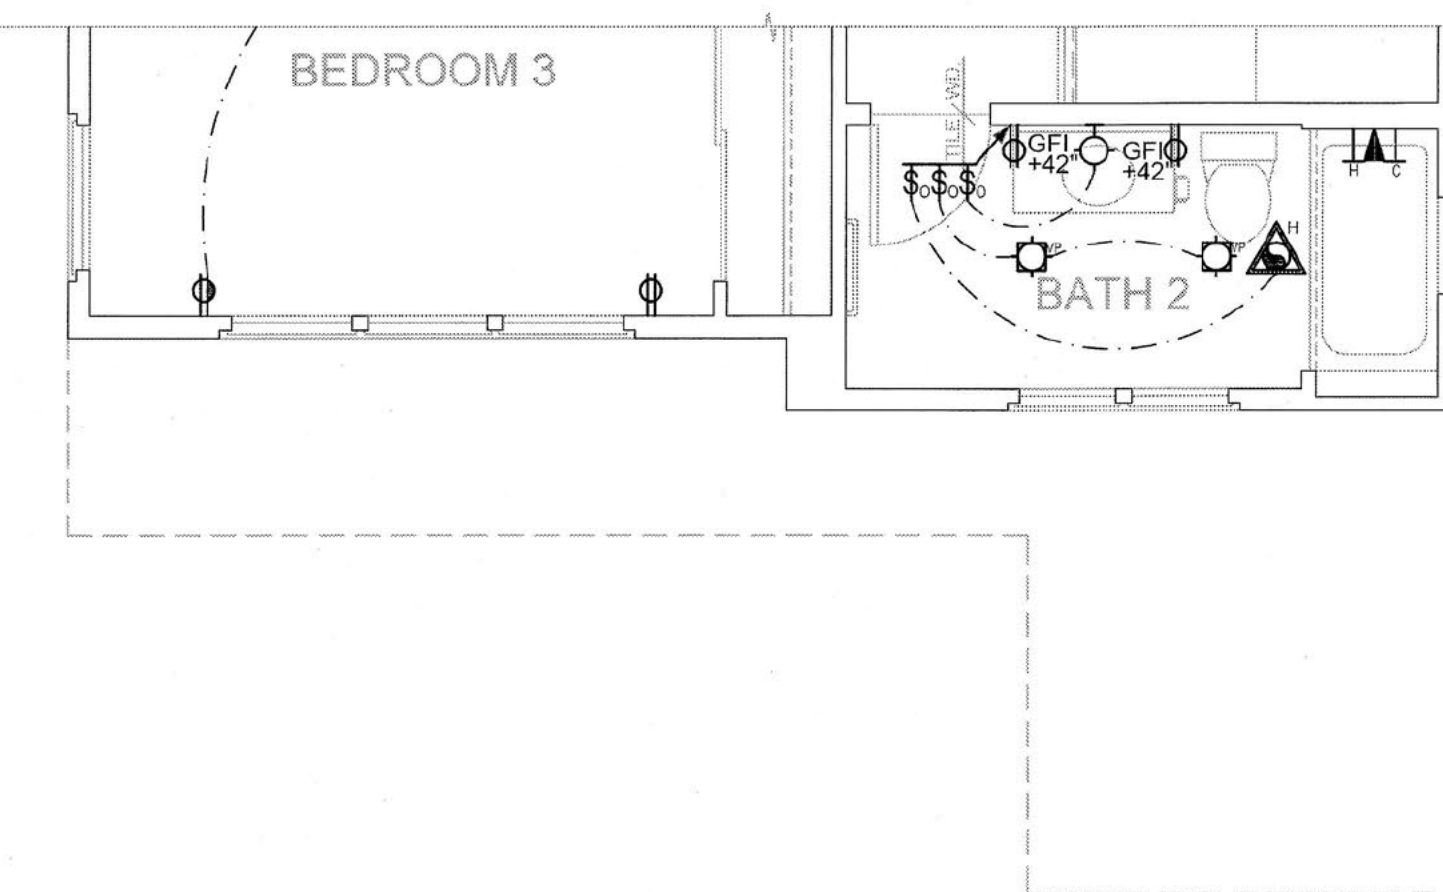


EMP SECOND FLOOR PARTIAL @ PLAN B
SCALE 1/4" = 1'-0"

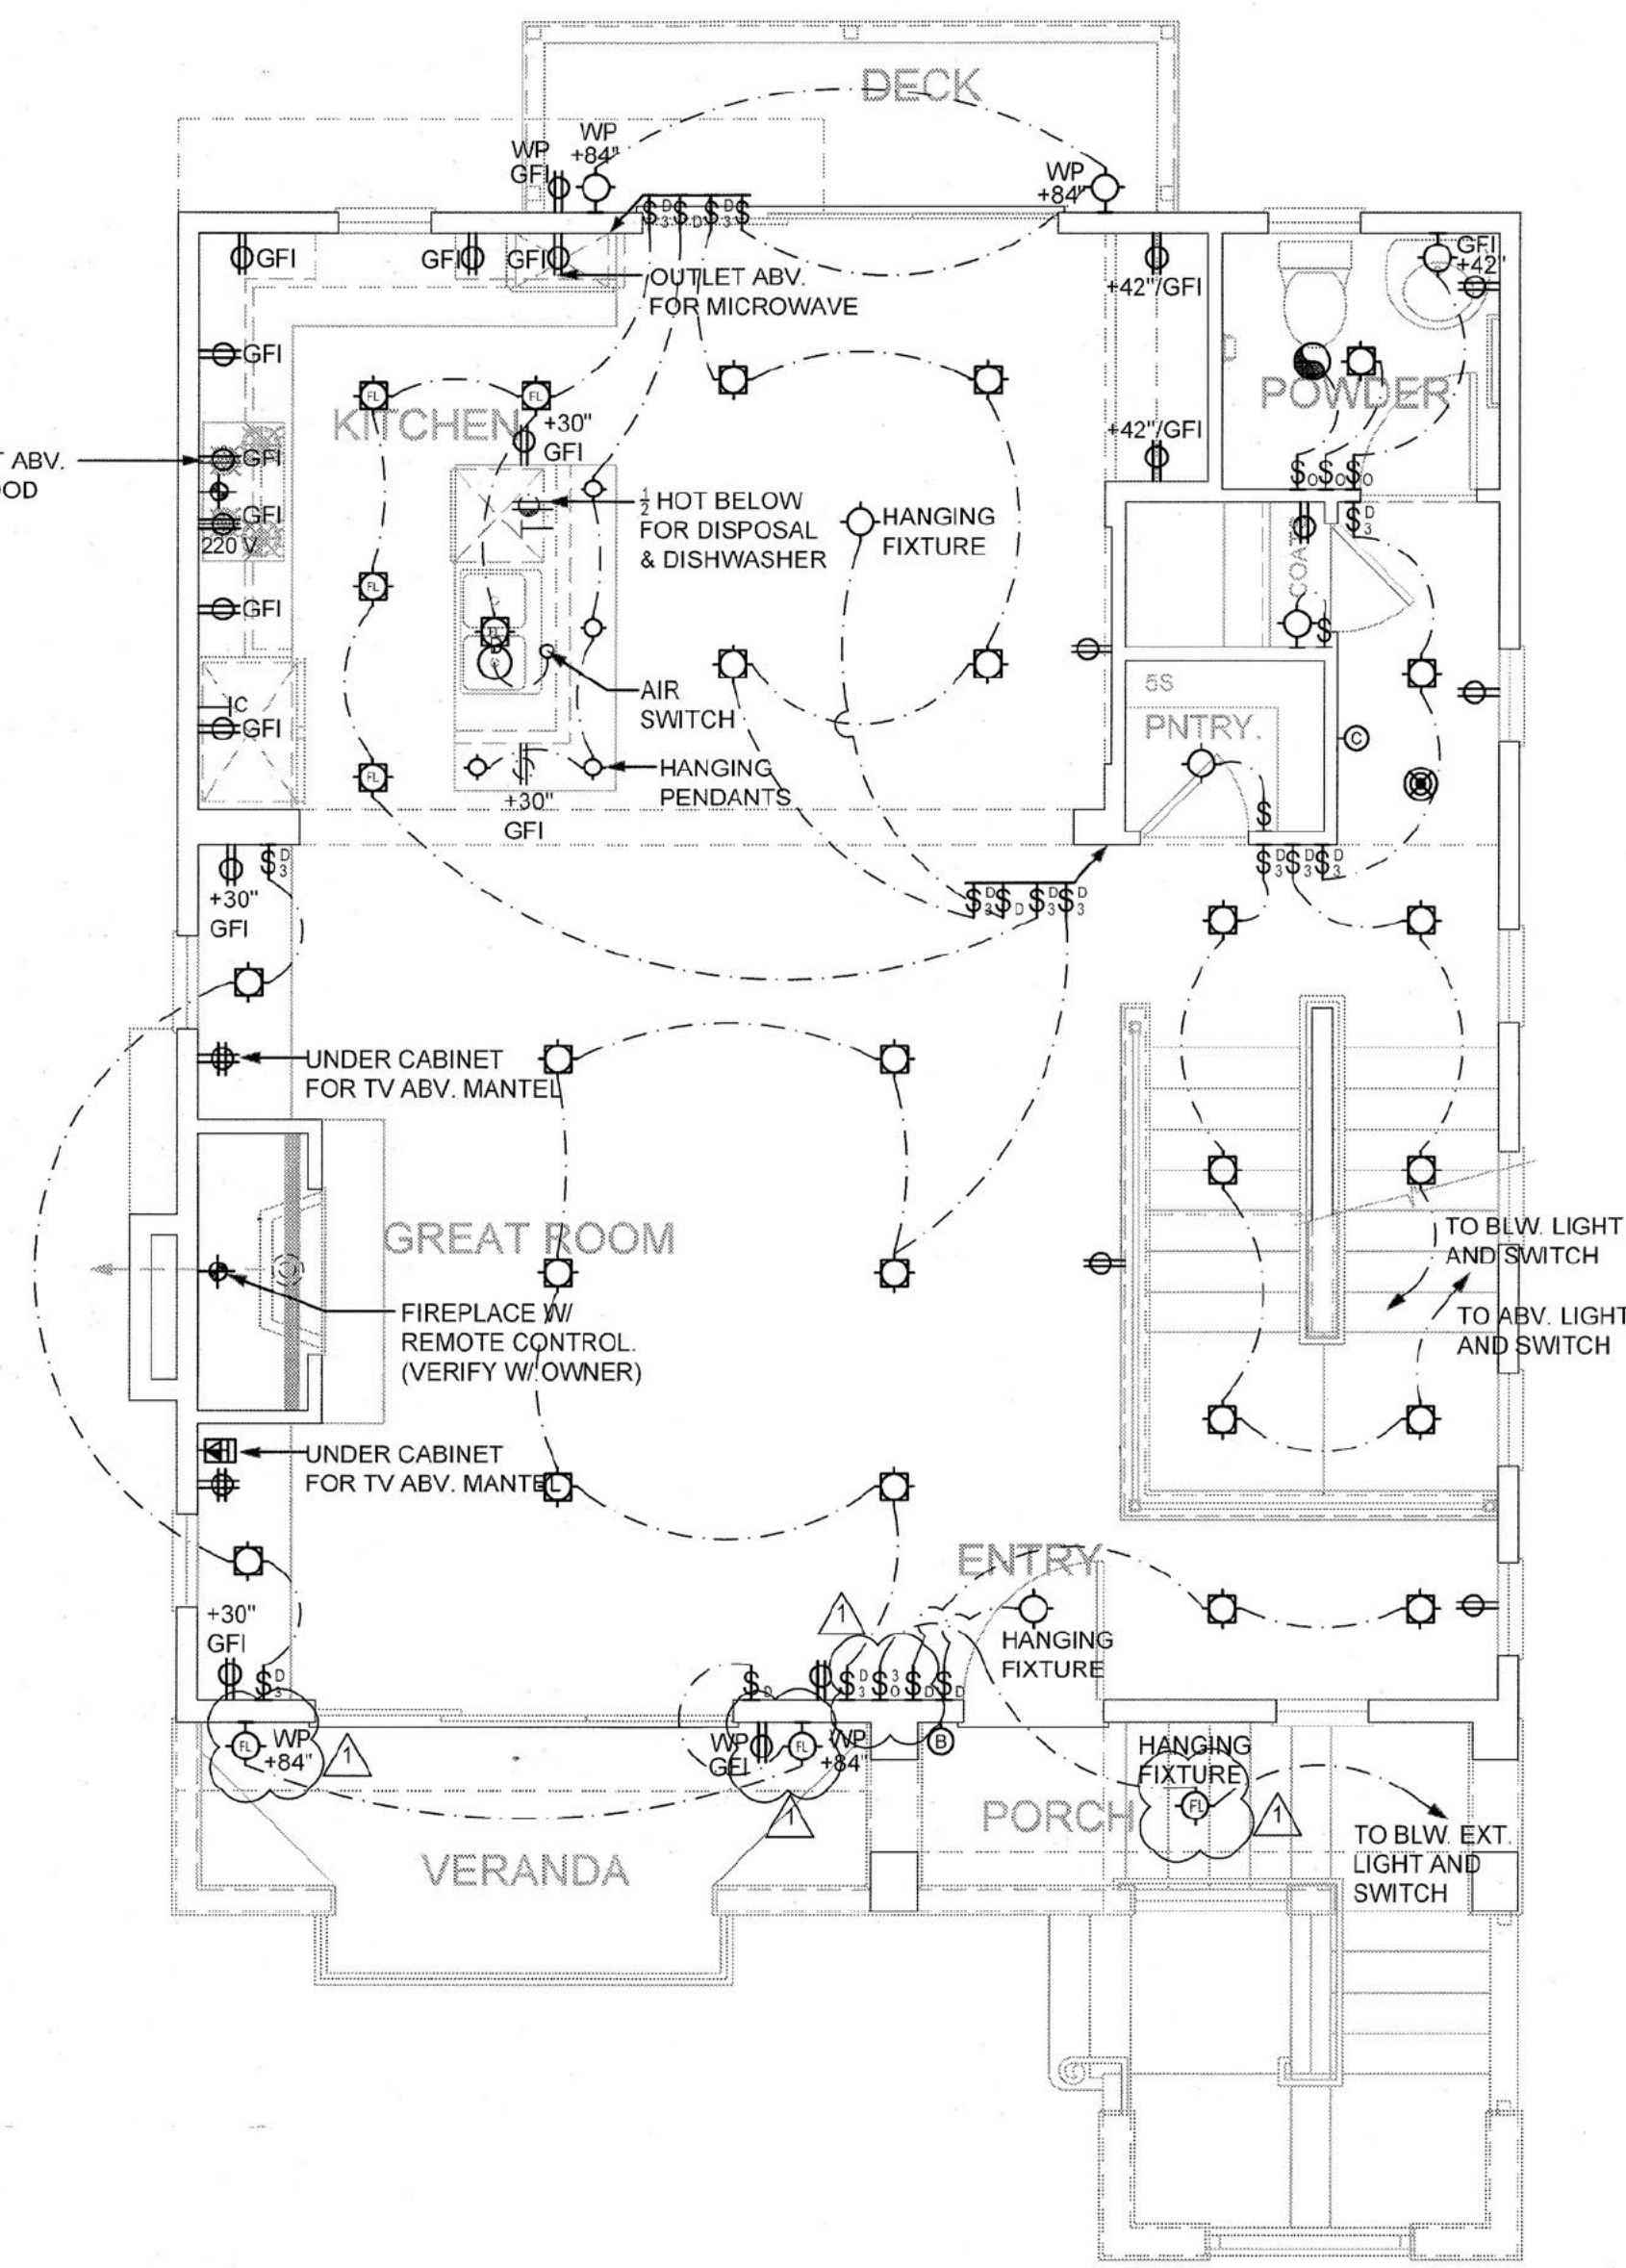


EMP FIRST FLOOR PLAN A
SCALE 1/4" = 1'-0"

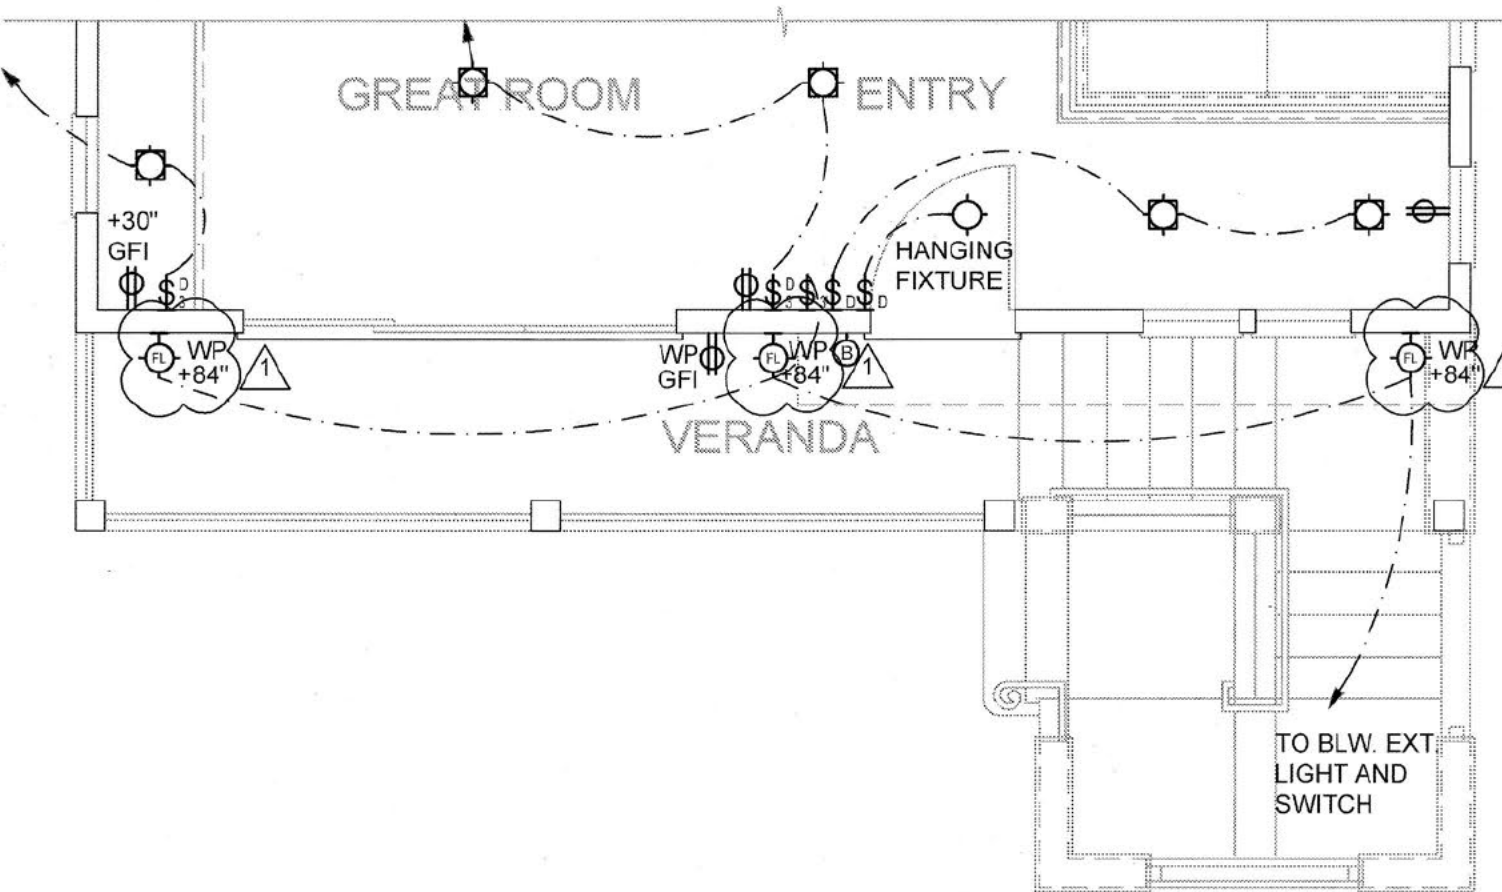

EMP FIRST FLOOR PARTIAL @ PLAN B
SCALE 1/4" = 1'-0"

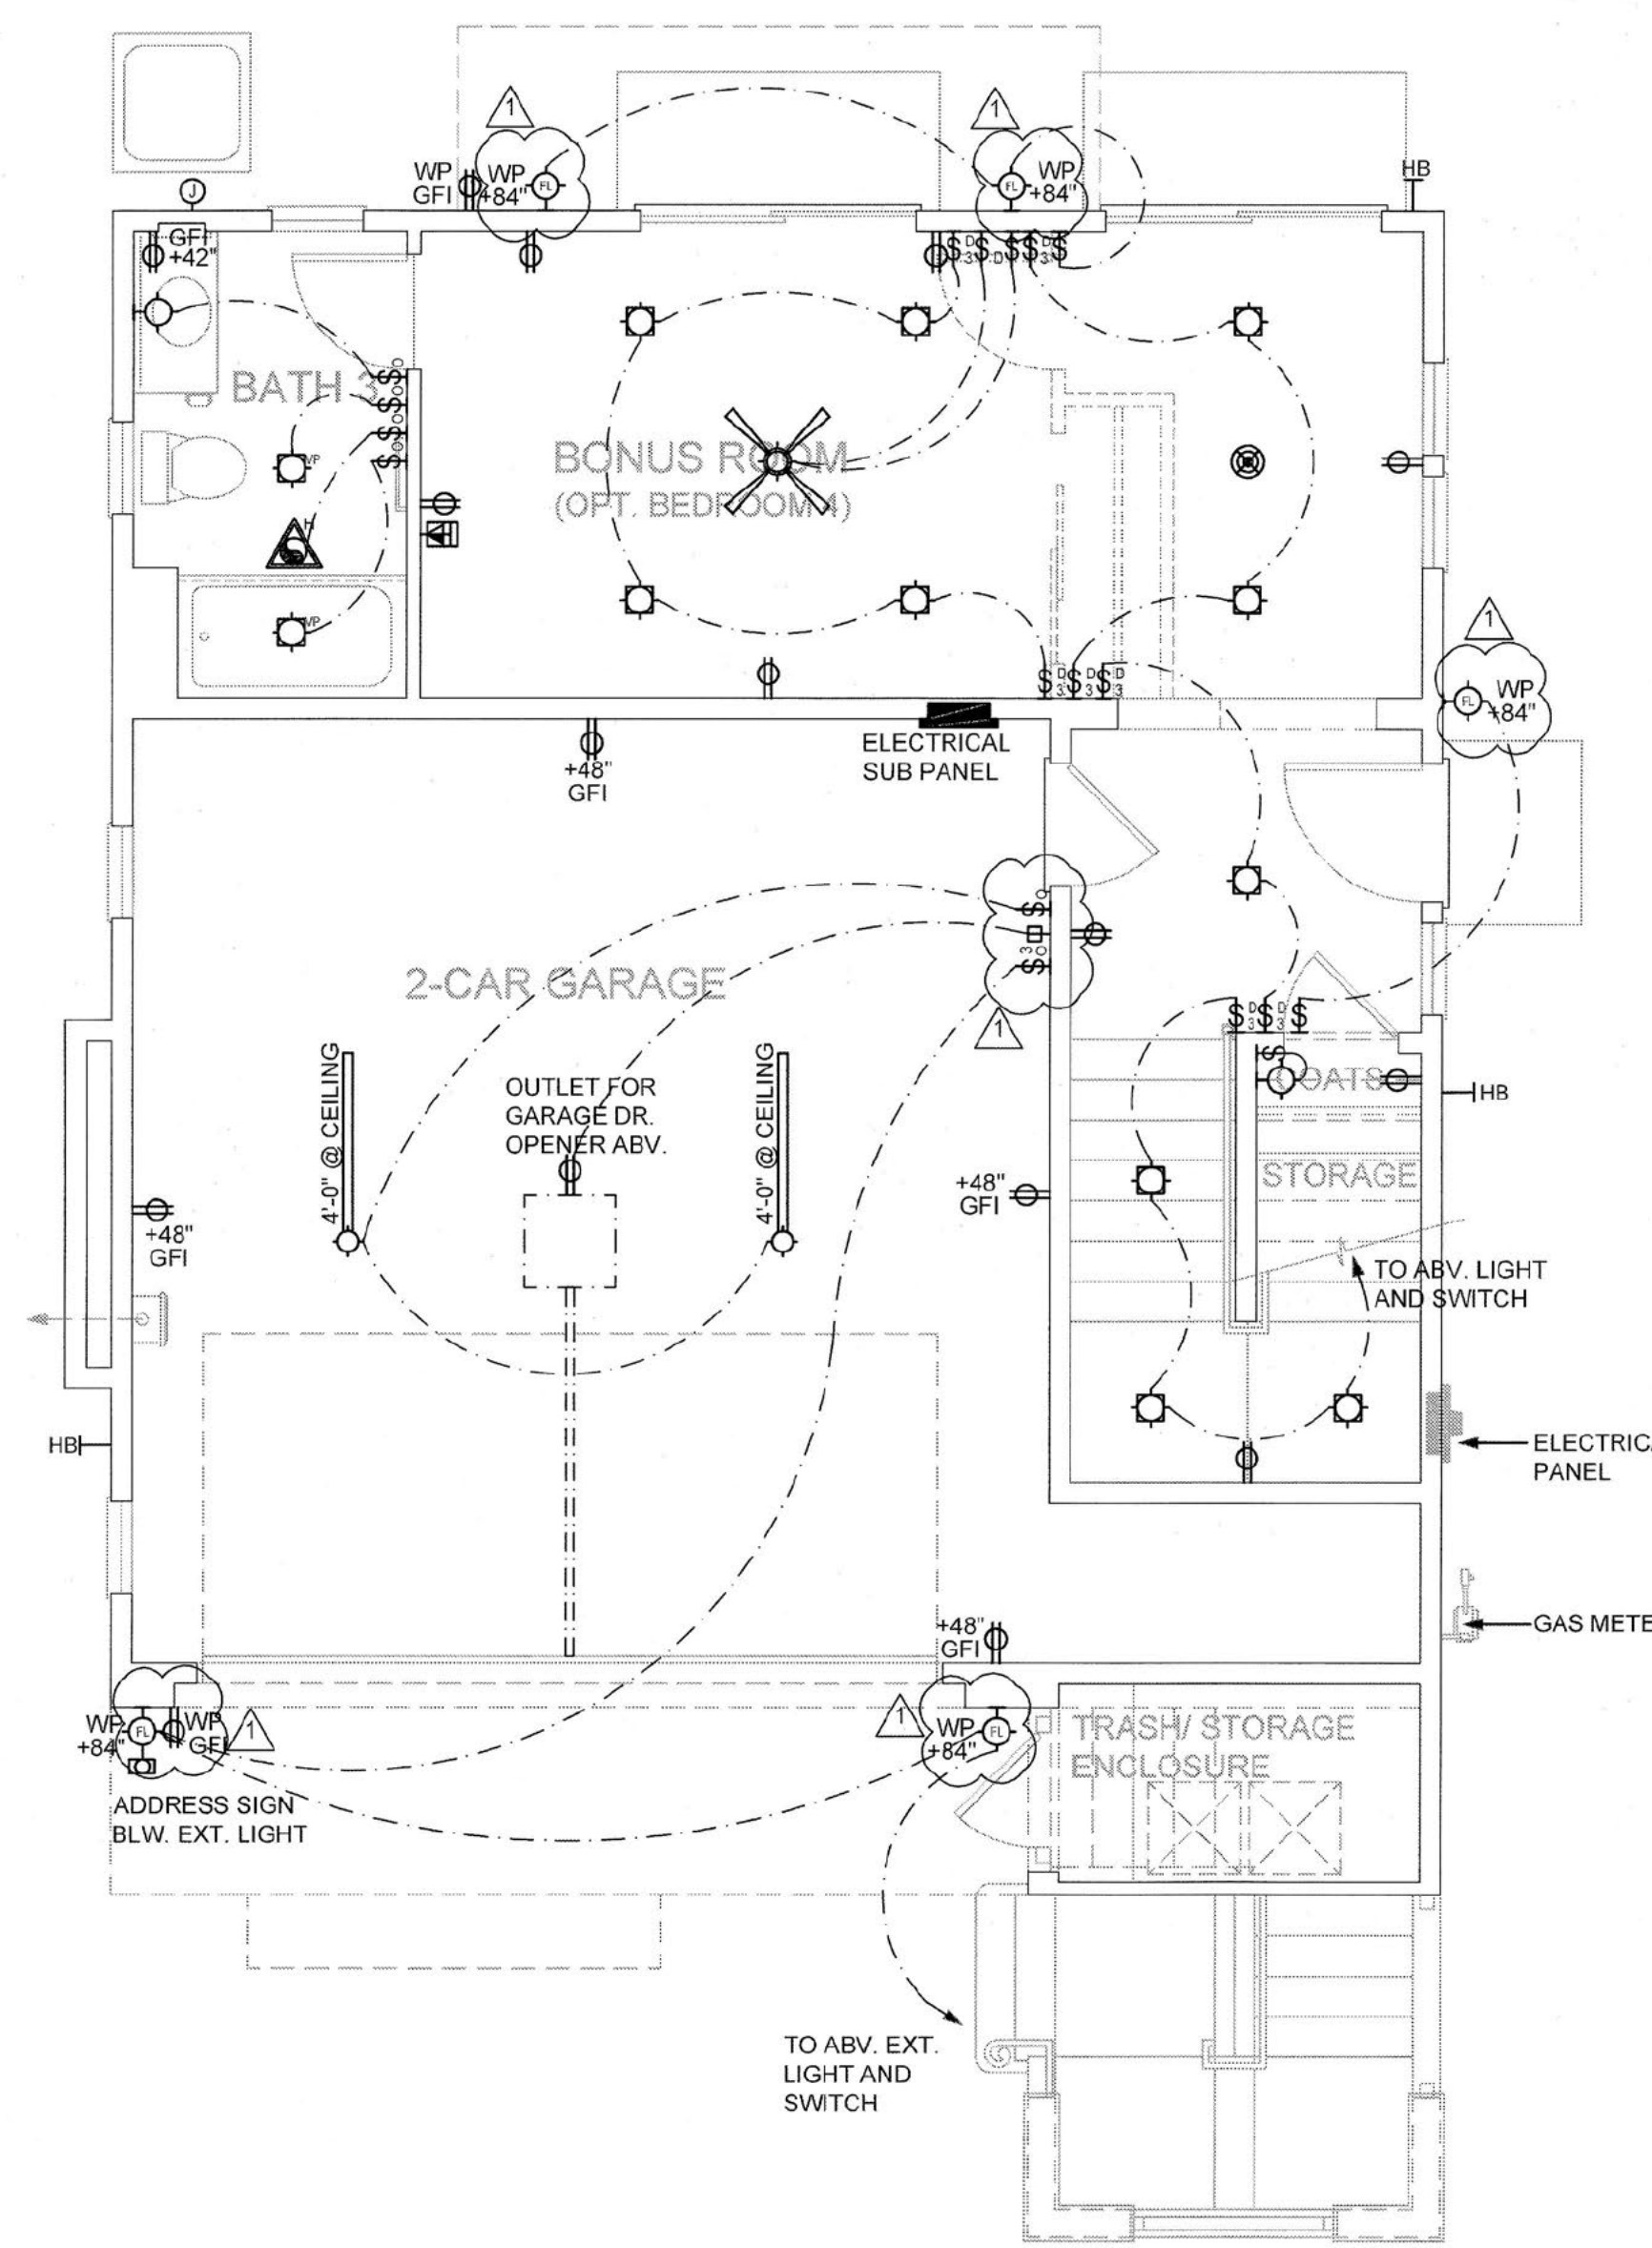

EMP GROUND FLOOR PLAN A & B
SCALE 1/4" = 1'-0"

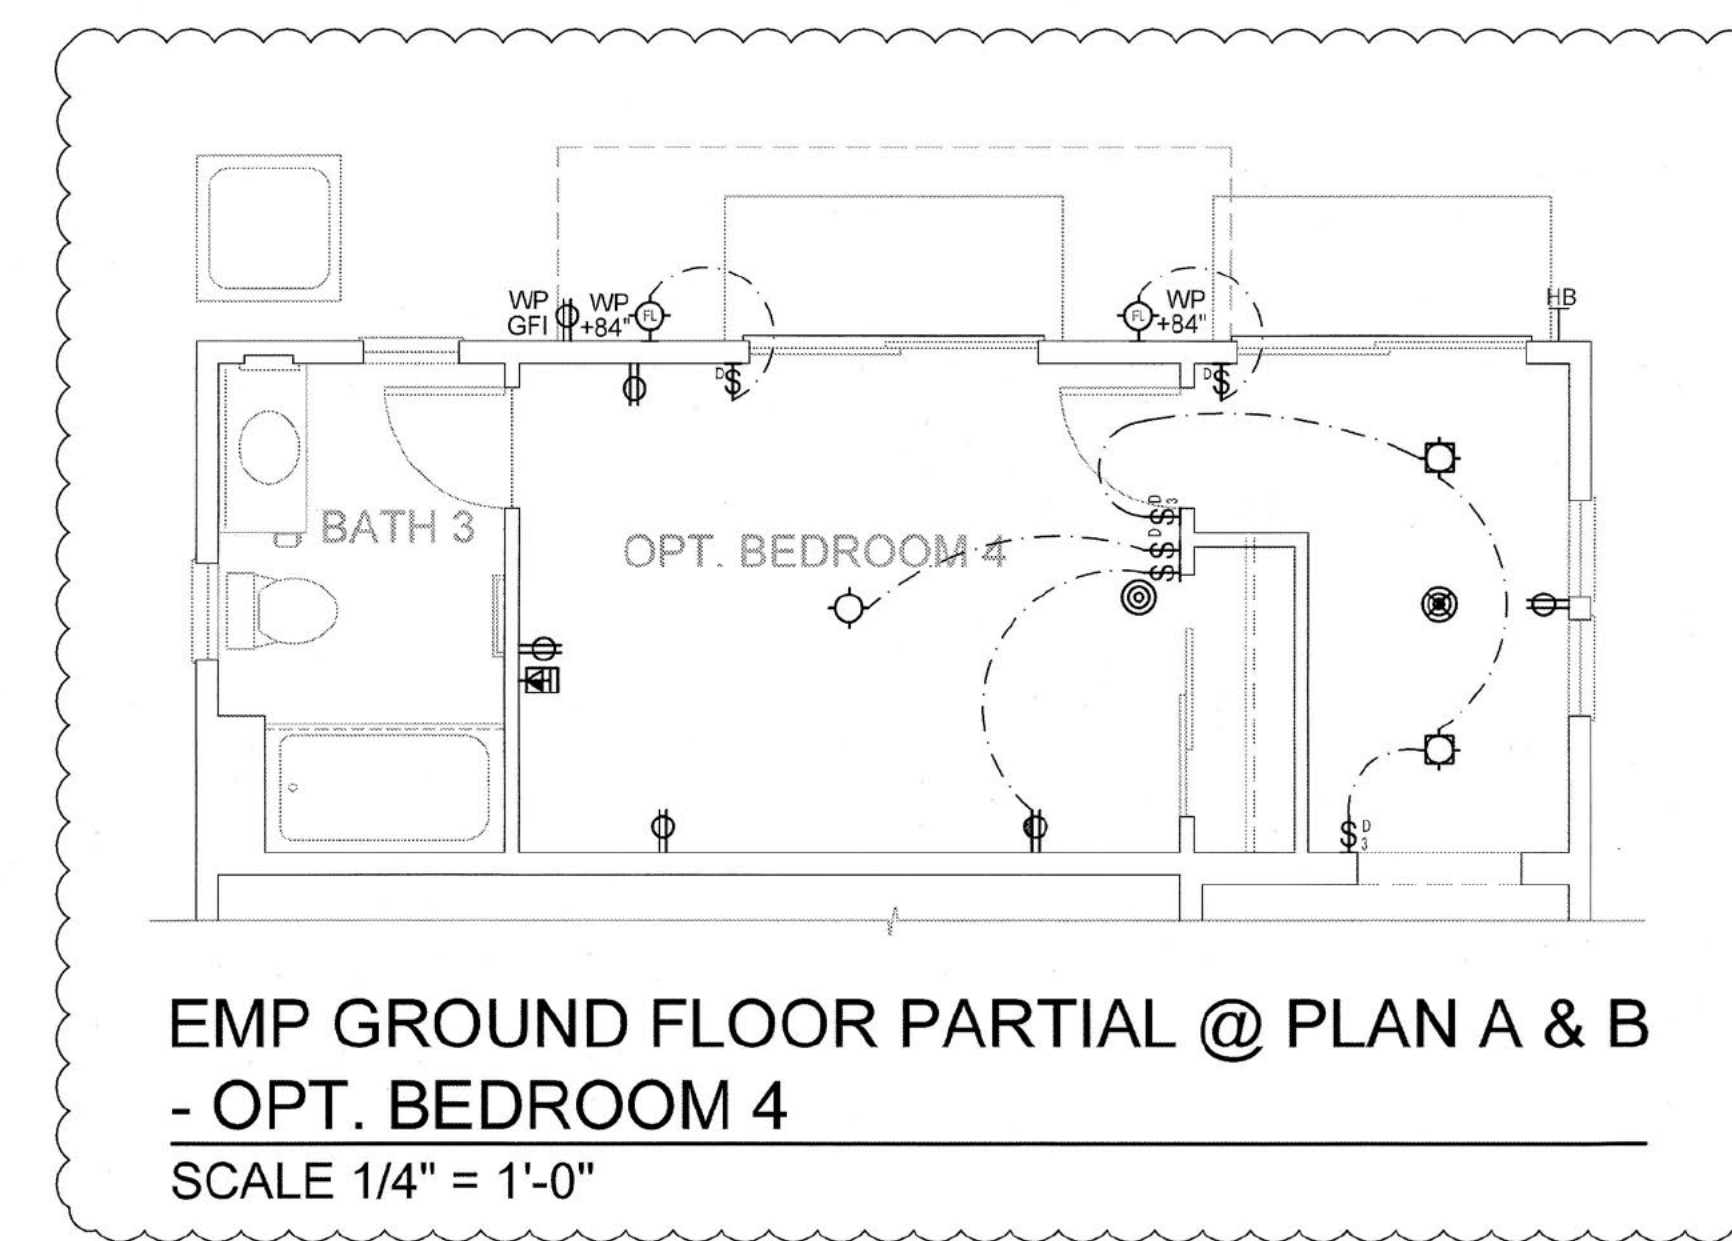

EMP GROUND FLOOR PARTIAL @ PLAN A & B
- OPT. BEDROOM 4
SCALE 1/4" = 1'-0"

ELECTRICAL NOTES

- MECHANICAL, ELECTRICAL AND PLUMBING SYSTEMS ARE SHOWN FOR INTENT ONLY. THESE SYSTEMS SHALL BE ENGINEERED BY OTHERS. THE CONTRACTOR SHALL BE RESPONSIBLE FOR PROPER INSTALLATION AND PLACEMENT.
- HIGH EFFICACY LUMINAIRES SHALL BE SWITCHED SEPARATELY FROM LOW EFFICACY LUMINAIRES. (CENC 150 (n) 2A)
- EXHAUST FANS SHALL BE SWITCHED SEPARATELY FROM LIGHTING SYSTEM. (OR SEE EXCEPTION - CENC 150 (k) 2B)
- ALL 125-VOLT, 15 AND 20 AMPERE DWELLING UNIT RECEPTACLES SHALL BE LISTED TAMPER-RESISTANT PER 2013 CEC 408.12
- LIGHTING IN GARAGES, LAUNDRY ROOMS AND UTILITY ROOMS SHALL BE HIGH EFFICACY AND CONTROLLED BY VACANCY SENSORS (2013 CENC 150 (k) 6)
- A 120V ELECTRIC RECEPTACLE SHALL BE LOCATED WITHIN 3FT FROM THE WATER HEATER AND BE ACCESSIBLE TO THE WATER HEATER WITHOUT OBSTRUCTIONS. (CENC 150 (n) 1A)
- RECESSED LUMINAIRES IN CEILINGS SHALL CONFORM TO 2013 CENC 150 (k) 8
- FANLIGHTS IN WET OR DAMP LOCATIONS SHALL BE LABELED "SUITABLE FOR WET OR DAMP LOCATIONS". (PER 2013 CEC 410.11 (A) 1)
- ALL KITCHEN, BATHROOM, LAUNDRY ROOM, GARAGE AND EXTERIOR RECEPTACLES SHALL BE GFCI PER CEC 210.8(A)
- PROVIDE A MINIMUM OF 1-20 AMP LAUNDRY BRANCH CIRCUIT PER 2013 CEC 110.11 (C) 2
- PROVIDE A MINIMUM OF 2-20 AMP CIRCUITS TO KITCHEN COUNTERTOPS FOR SMALL APPLIANCES PER 2013 CEC 210.11 (C) 1
- A DEDICATED 20 AMP CIRCUIT TO SERVE THE REQUIRED BATHROOM OUTLETS. THIS CIRCUIT CANNOT SUPPLY ANY OTHER RECEPTACLES, LIGHTS, FANS, ETC. CEC 210.11 (C) 3
- EXTERIOR LIGHT FIXTURES & WEATHERPROOF OUTLETS SHALL BE INSTALLED PER 2013 CEC 410.10(A)(D) & 408.9
- RECEPTACLES AT THE FRONT AND REAR OF THE HOME MUST BE WITHIN 6 FEET 6 INCHES OF GRADE (AND WATERPROOF AND GFCI PROTECTED). 2013 CEC 210.52 E & 210.8(A)
- ALL BRANCH CIRCUITS SUPPLYING 120-VOLT SINGLE-PHASE 15 & 20-AMPERE RECEPTACLE OUTLETS INSTALLED IN FAMILY ROOMS, DINING ROOMS, LIVING ROOMS, PARLORS, LIBRARIES, DENIS, BEDROOMS, SUNROOMS, REC ROOMS, CLOSETS, HALLWAYS, OR SIMILAR SHALL BE PROTECTED BY A LISTED ARC-FAULT CIRCUIT INTERRUPTER(S) PER 2013 CEC 210.12(B)
- TERMINATION OF ALL ENVIRONMENTAL AIR DUCTS (i.e., CLOTHES DRYER VENTS, BATH AND UTILITY FANS, ETC.) SHALL BE A MINIMUM OF 3 FEET FROM PROPERTY LINES OR ANY OPENINGS INTO THE BUILDING. PER 2013 CMC 504.5
- STAIRWAYS SHALL BE ILLUMINATED TO NOT LESS THAN 1-FOOT CANDLE (11 LUX) ON TREAD RUNS (2013 CRC R303.7)
- SEE DET. 17/AD.1 FOR CONCRETE ENCASED GROUNDING ROD
- SEE DETAIL 12813/AD.1 FOR PROPER INSTALLATION OF SERVICE METERS.
- SMOKE ALARMS SHALL BE PROVIDED IN THE FOLLOWING LOCATIONS: PER 2013 CRC R314.3 & R314.3.4
 - IN EACH SLEEPING ROOM
 - OUTSIDE EACH SEPARATE SLEEPING AREA IN THE IMMEDIATE VICINITY OF THE BEDROOMS
 - ON EACH ADDITIONAL STORY
- LOCATION REQUIREMENTS:
 - MIN. 3 FT. FROM BATHROOMS WITH TUBS OR SHOWERS.
 - MIN. 20 FT. FROM PERMANENTLY INSTALLED COOKING APPLIANCES.
 - MIN. 3 FT. FROM TIP OF SUSPENDED CEILING FAN BLADE.
 - WITHIN 12 IN. VERTICALLY FROM HIGHEST POINT OF SLOPED OR COFFERED CEILING.
- MAIN ELECTRICAL SERVICE PANEL SHALL HAVE A MINIMUM BUSBAR RATINGS OF 200 AMPS. (CENC 110.10 (e) 1)
- MAIN ELECTRICAL SERVICE PANEL SHALL HAVE A RESERVED SPACE TO ALLOW FOR THE INSTALLATION OF DOUBLE POLE CIRCUIT BREAKER FOR A FUTURE SOLAR ELECTRIC INSTALLATION. RESERVED SPACE SHALL BE POSITIONED OPPOSITE (LOAD) END FROM THE INPUT FEEDER LOCATION OR MAIN CIRCUIT LOCATION AND BE PERMANENTLY MARKED AS "FOR FUTURE SOLAR ELECTRIC" (CENC 110.10 (e) 2)
- PROVIDE A MINIMUM EXHAUST RATE OF 50 CUBIC FEET PER MINUTE FOR THE BATHROOM EXHAUST FANS. [CMC SR403.7]
- PROVIDE A MINIMUM VENTILATION EXHAUST RATE OF 100 CFM FOR KITCHEN HOODS. [ASHRAE 62.2-10 TABLE 5.1]

ELECTRICAL, MECHANICAL AND PLUMBING PLANS

EMP SYMBOL LEGEND

SWITCH	DIMMER SWITCH	DUPLEX RECEPTACLE	CEILING FAN
3-WAY SWITCH	4-WAY SWITCH	FOURPLEX RECEPTACLE	GAS METER
PHONE JACK	DATA JACK	QUARTER HOT FOURPLEX RECEPTACLE	ELECTRICAL MAIN PANEL
PHONE/DATA JACK	PLUG AND PLAY OUTLET	220V RECEPTACLE	ELECTRICAL SUB PANEL
COMBO JACK	T.V. CABLE JACK	INCANDESCENT/FLUORESCENT LIGHT FIXTURE	POWER INVERTER
GAS STUB	KEY VALVE (GAS)	LED LIGHT FIXTURE (WALL)	RATED FOR INTERIORS IF LOCATED IN GARAGE
VACUUM PORT	INTERCOM	FLUORESCENT LIGHT FIXTURE (WALL)	SATELLITE
DISPOSAL	CHIMES	WALL WASHER LIGHT FIXTURE (RECESSED)	D DIMMABLE
DOORBELL		FLUORESCENT STRIP LIGHT	FL FLUORESCENT
THERMOSTAT		FLUORESCENT LIGHT FIXTURE (SURFACE)	LED LIGHT EMITTING DIODE
PHOTOCELL SENSOR		TRACK LIGHTING	MANUAL-ON OCCUPANCY SENSOR & MOTION SENSOR SWITCH THAT COMPLIES WITH CEC SECTION 110(6) & SHALL NOT HAVE A CONTROL THAT ALLOWS THE LUMINAIRES TO BE TURNED ON AUTOMATICALLY OR THAT HAS AN OVERRIDE ALLOWING THE LUMINAIRES TO BE ALWAYS ON OR CONTROLLED BY VACANCY SENSORS
VACANCY DETECTOR (CEILING)		BATHROOM EXHAUST FAN W/ HUMIDISTAT (CAL GREEN 4.506.1)	
VACANCY DETECTOR (WALL)		FAN	
SPEAKER (CEILING)		WHOLE BUILDING VENTILATION FAN - SEE CEM RED, (CENC 150 (o) & CAL GREEN 4.506.1)	
JUNCTION BOX 220V		INCANDESCENT LIGHT/FAN COMBINATION (RECESSED)	
GARAGE DOOR SWITCH		FLUORESCENT LIGHT/FAN COMBINATION (RECESSED)	
LIGHTED ADDRESS SIGN		FANLIGHT SIDE-BY-SIDE COMBINATION (RECESSED)	
SHOWER HEAD			
HOT WATER STUB			
COLD WATER STUB			
HOSE BIB W/ BACKFLOW PREVENTION DEVICE			
SMOKE DETECTOR - HARD WIRED			
INTERCONNECTED W/ BATTERY BACK-UP CRC R314			
CARBON MONOXIDE / SMOKE DETECTOR COMBO - HARD WIRED, INTERCONNECTED W/ BATTERY BACK-UP CRC R315			
SINGLE POLE RECEPTACLE			
FLUSH FLOOR DUPLEX RECEPTACLE			

MECHANICAL NOTES

- MECHANICAL, ELECTRICAL AND PLUMBING SYSTEMS ARE SHOWN FOR INTENT ONLY. THESE SYSTEMS SHALL BE ENGINEERED BY OTHERS. THE CONTRACTOR SHALL BE RESPONSIBLE FOR PROPER INSTALLATION AND PLACEMENT.
 - PROVIDE MIN. 4" DIA. SMOOTH METAL DRYER VENT W/ BACKDRAFT DAMPER TO EXTERIOR AS SHOWN ON PLAN. VENT RUN SHALL COMPLY WITH MNR'S SPECS. AND 2013 CMC 504.3.1 & 905. DUCT IS LIMITED TO 14 FT IN LENGTH W/ 2 90 DEG. ELBOWS FROM THE DRYER TO THE POINT OF TERMINATION. REDUCE THIS LENGTH BY 2 FT FOR EVERY ELBOW IN EXCESS OF 2. LENGTH OF RUN MAY EXCEED 14'-0" IF PERMITTED BY DRYER MANUFACTURER'S INSTALLATION INSTRUCTIONS AND APPROVED BY THE AUTHORITY HAVING JURISDICTION.
 - ALL EXHAUST FANS SHALL HAVE BACKDRAFT DAMPERS.
 - ALL AIR DUCTS IN GARAGE AND DUCTS PENETRATING SEPARATION WALLS OR CEILING BETWEEN GARAGE AND LIVING AREAS SHALL BE NO. 26 GAGE (0.019-INCH) SHEET STEEL AND HAVE NO OPENINGS INTO THE GARAGE. (CRC R302.5.2)
 - TERMINATION OF ALL ENVIRONMENTAL AIR DUCTS (i.e., CLOTHES DRYER VENTS, BATH AND UTILITY FANS, ETC.) SHALL BE A MINIMUM OF 3 FEET FROM PROPERTY LINES OR ANY OPENINGS INTO THE BUILDING. PER 2013 CMC 504.5
 - DRYER VENT OUTLET SHALL BE MIN. 5 FT. FROM AIR CONDITIONING CONDENSER (2013 CENC 150 (h) 3.A)
 - ROOMS CONTAINING TUBS, SHOWERS OR SIMILAR BATHING FIXTURES SHALL BE MECHANICALLY VENTILATED IN ACCORDANCE WITH 2013 CMC & (CRC R303.3.1) INCLUDING ACCESSIBLE HUMIDISTAT CONTROL (CAL GREEN 4.506.1)
 - SEE DETAIL 8/AD.1 TYP. ATTIC FURNACE INSTALLATION
 - WHOLE BUILDING VENTILATION SHALL BE PROVIDED AND CONFIRMED THRU FIELD VERIFICATION & DIAGNOSTIC TESTING. PER 2013 CENC 150 (o)
- CALCULATION: 1 CFM PER 100 SF FLOOR AREA PLUS NUMBER OF BEDROOMS PLUS ONE, MULTIPLIED BY 7.5 CFM.
EXAMPLE: 1500 SF HOME W/ 3 BEDRMS = 15 CFM BLDG + 30 CFM PER OCCUPANT = 45 CFM REQUIRED.

PLUMBING NOTES

- MECHANICAL, ELECTRICAL AND PLUMBING SYSTEMS ARE SHOWN FOR INTENT ONLY. THESE SYSTEMS SHALL BE ENGINEERED BY OTHERS. THE CONTRACTOR SHALL BE RESPONSIBLE FOR PROPER INSTALLATION AND PLACEMENT.
- ALL TUBS AND SHOWERS SHALL HAVE PRESSURE BALANCE, THERMOSTATIC OR COMBINATION MIXING VALVE CONTROL PER 2013 CPC 408.3
- WATER PIPES SHALL BE INSULATED PER 2013 CENC 150 (i) 2
- AUTOMATIC FIRE SPRINKLER SYSTEM SHALL BE DESIGNED AND INSTALLED IN ACCORDANCE WITH NFPA 13D, PER CRC R313
- FOR GAS OR PROPANE WATER HEATERS; A GAS SUPPLY LINE WITH CAPACITY OF AT LEAST 200,000 BTU/HR SHALL BE INSTALLED (CENC 150 (i) 10)
- SEE DETAIL 15/AD.1 FOR WATER SERVICE ENTRY TO HOUSE. (VERIFY LOCATION PRIOR TO CONSTRUCTION)
- SEE DETAIL 13/AD.1 FOR PROPER INSTALLATION OF SERVICE METERS.
- SEE DETAIL 8/AD.1 TYP. ATTIC FURNACE INSTALLATION.
- SEE DETAIL 7/AD.1 TYP. PLUMBING VENTING AT ISLAND.

REVISIONS

1ST CITY PLAN CHECK	08-01-16
IN-HOUSE REVISIONS	08-01-16

BUILDING DEPARTMENT SUBMITTAL 1
EMP FLOOR PLANS
SCALE 1/4"=1'-0"





JOB NO. 1249.001 SHEET

DRAWN MWS / AMF / RG





CHECK

DATE 08-01-16





A1.06

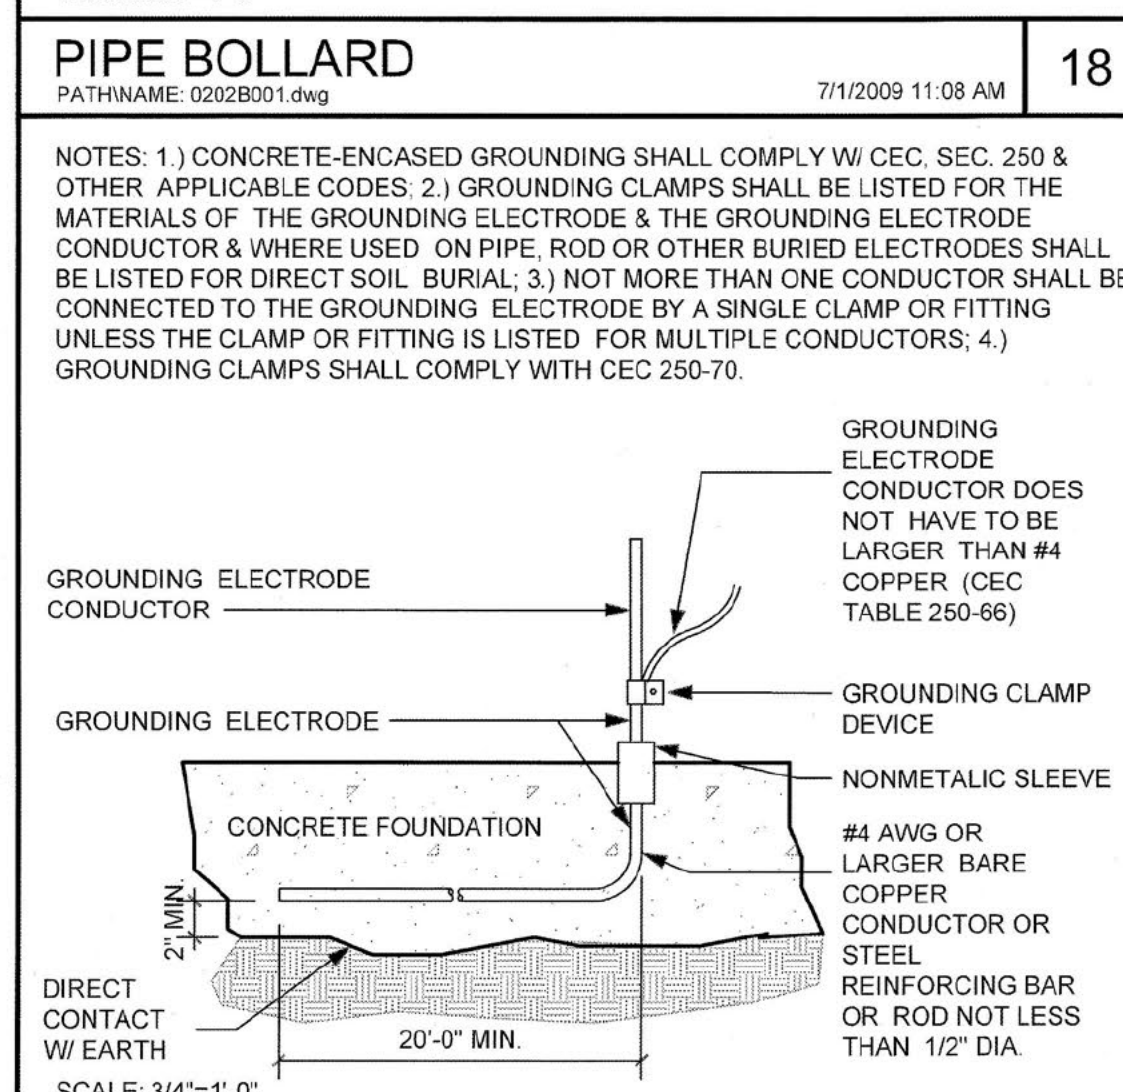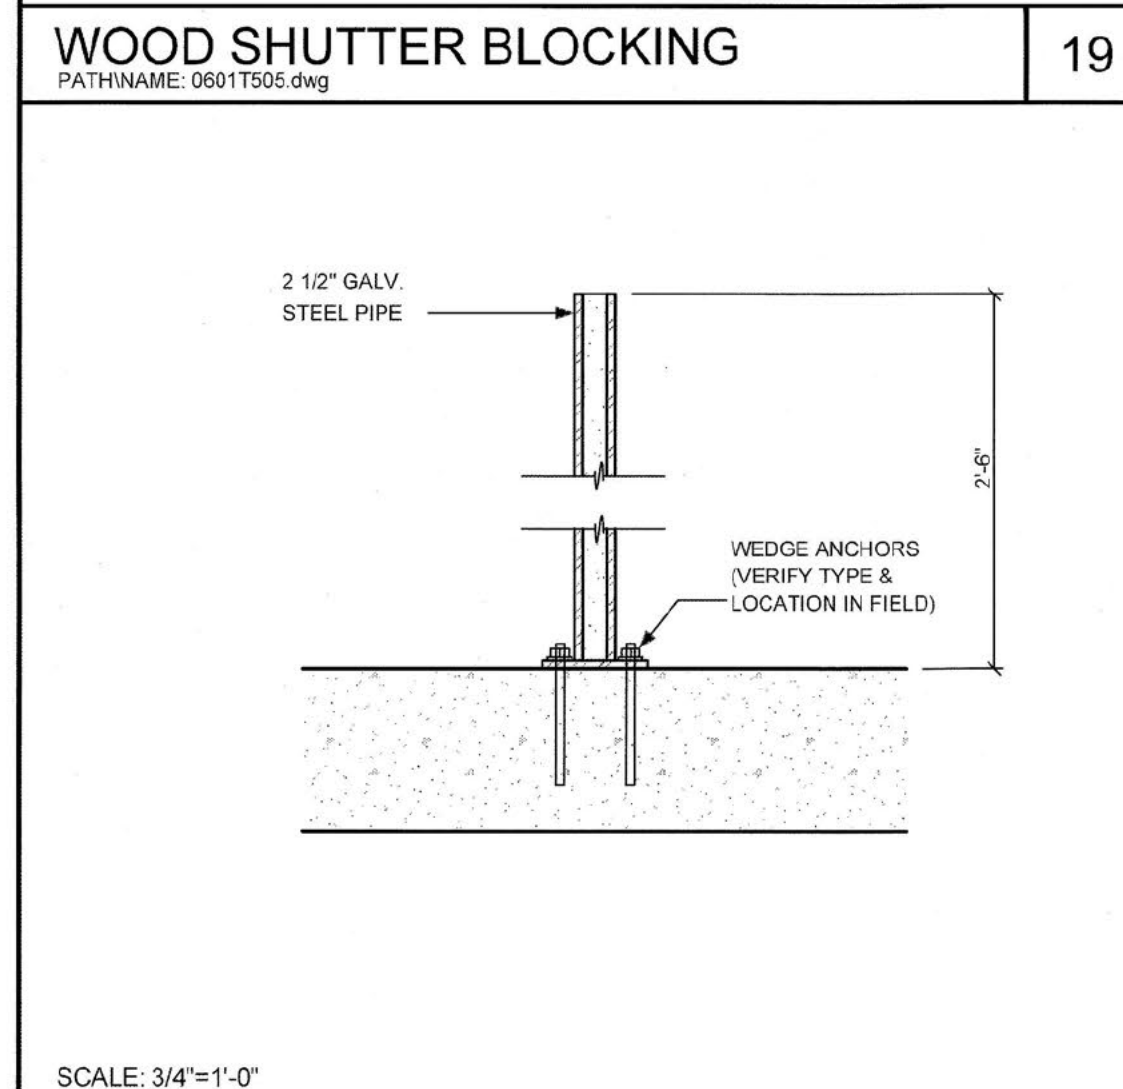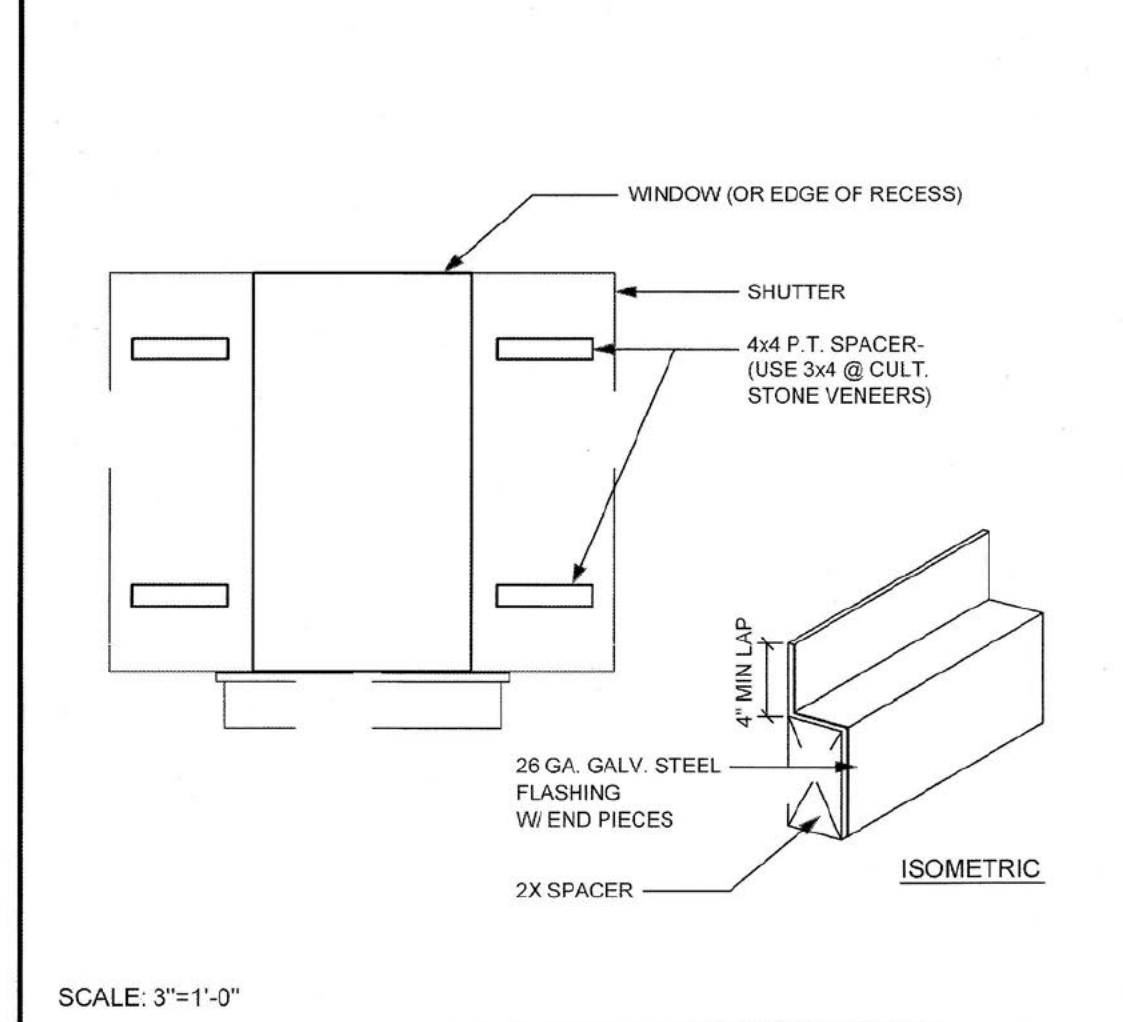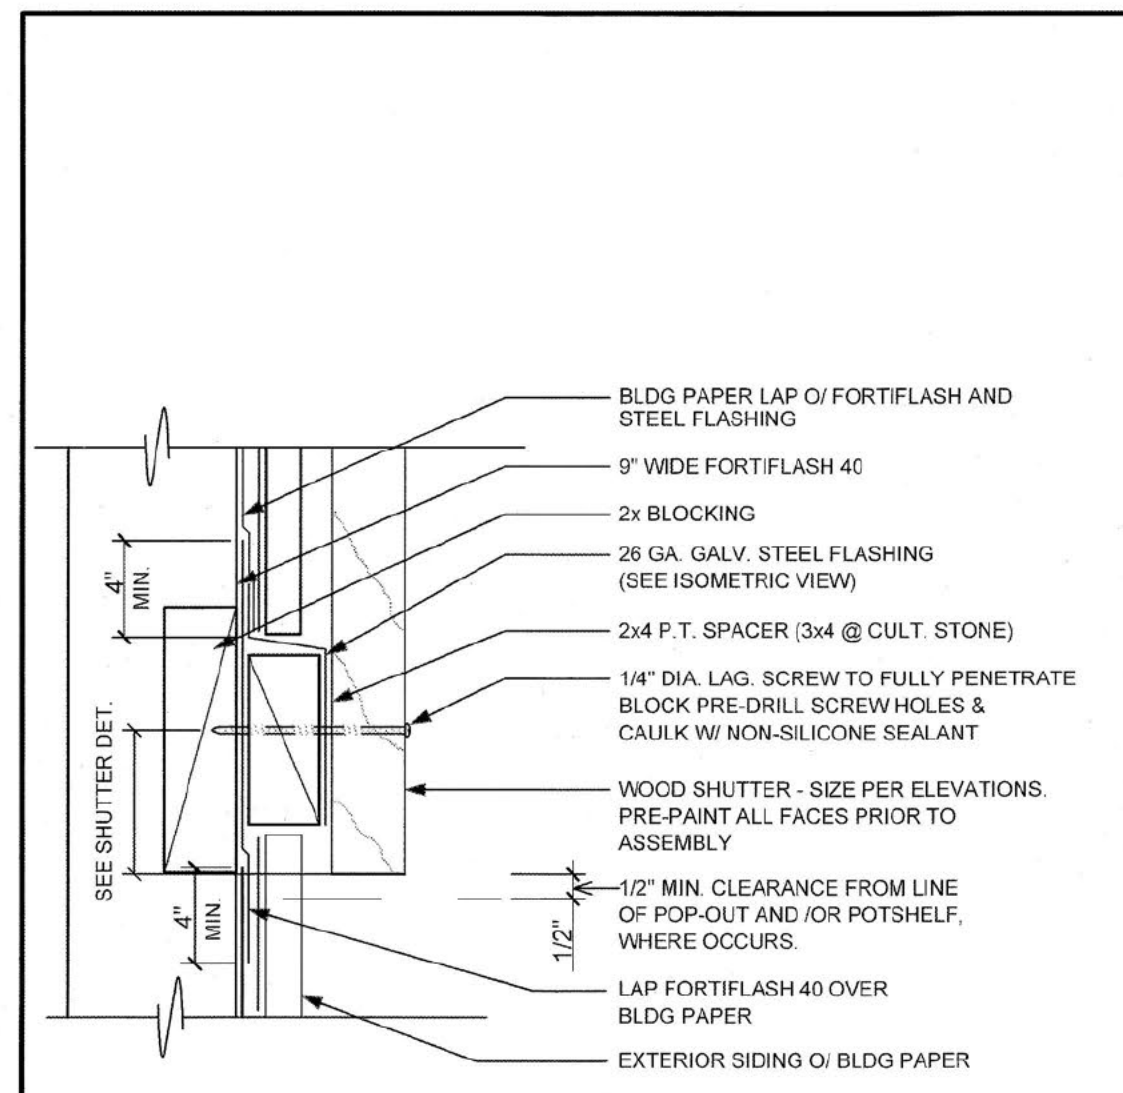





CONCRETE-ENCASED GROUNDING
PATHNAME: 1699303.dwg 11/20/2010 17

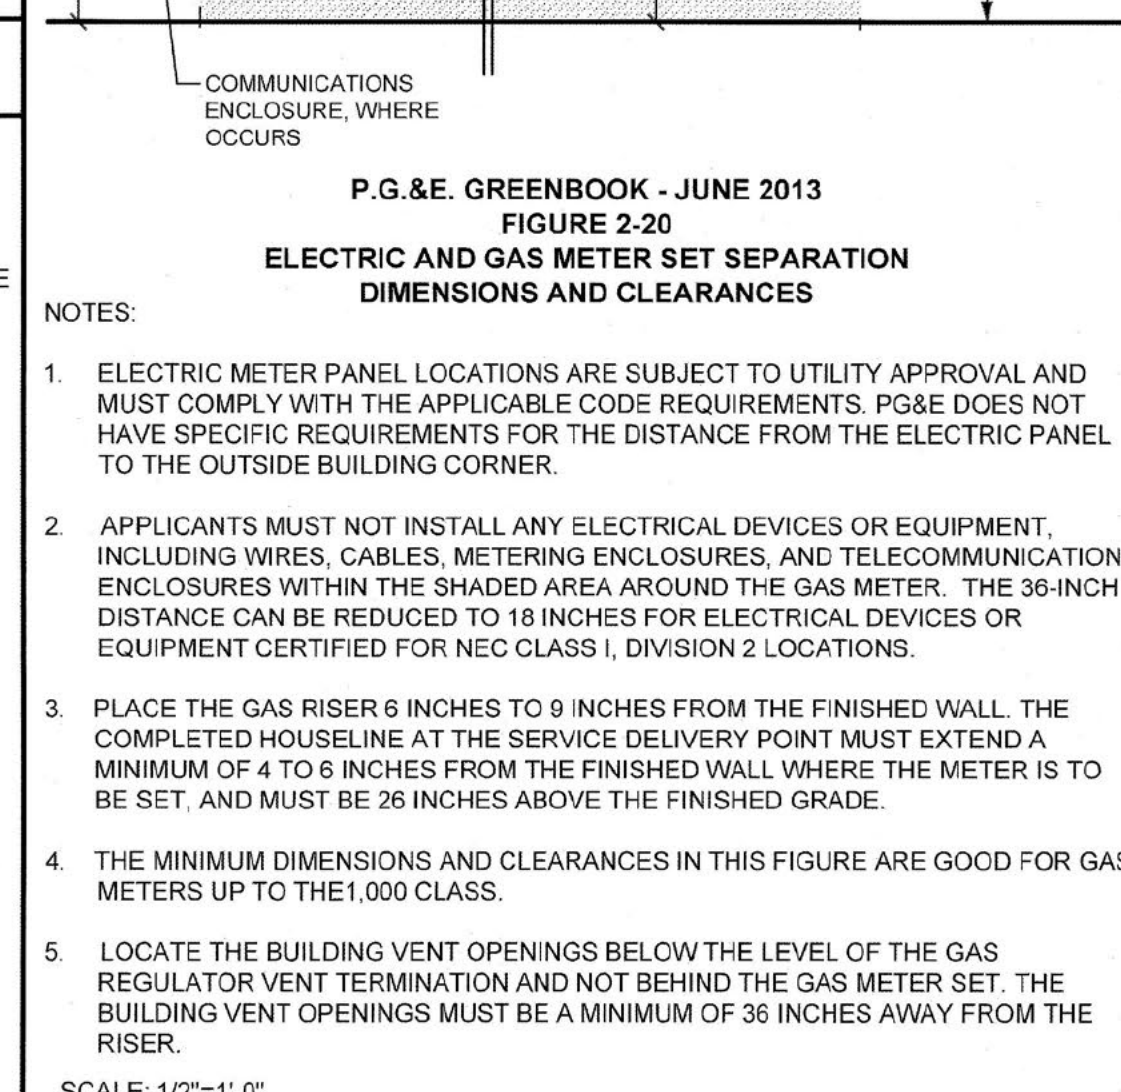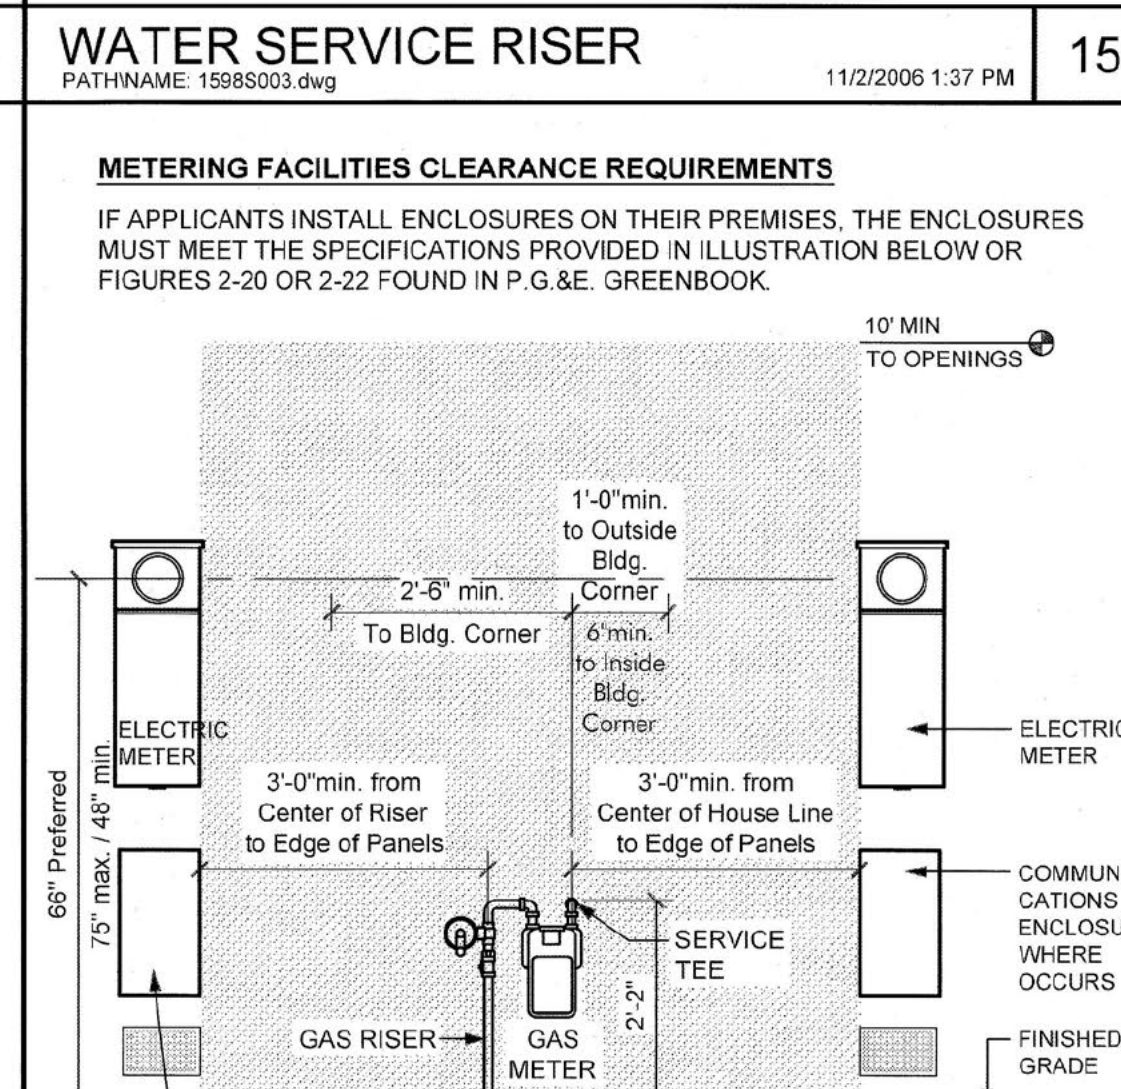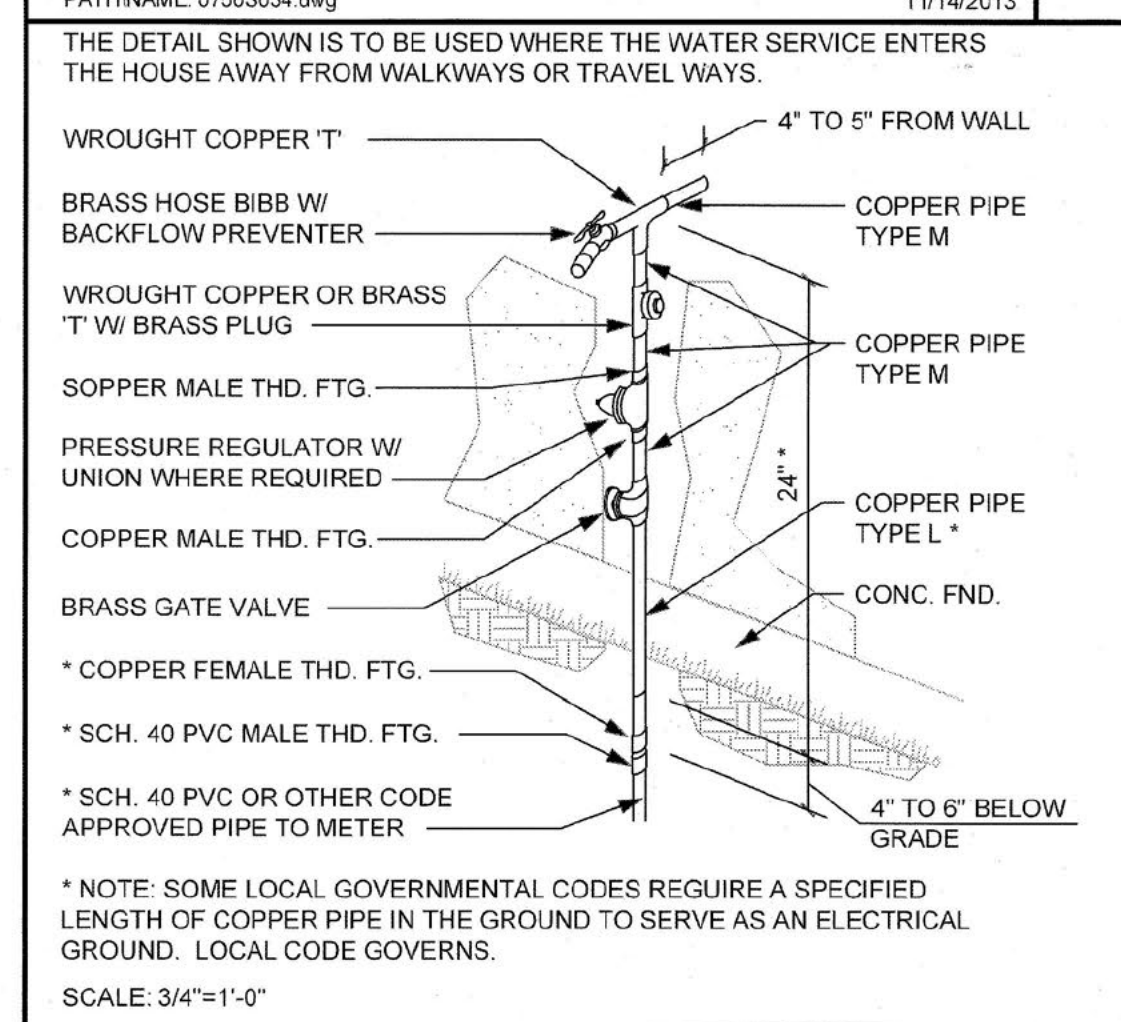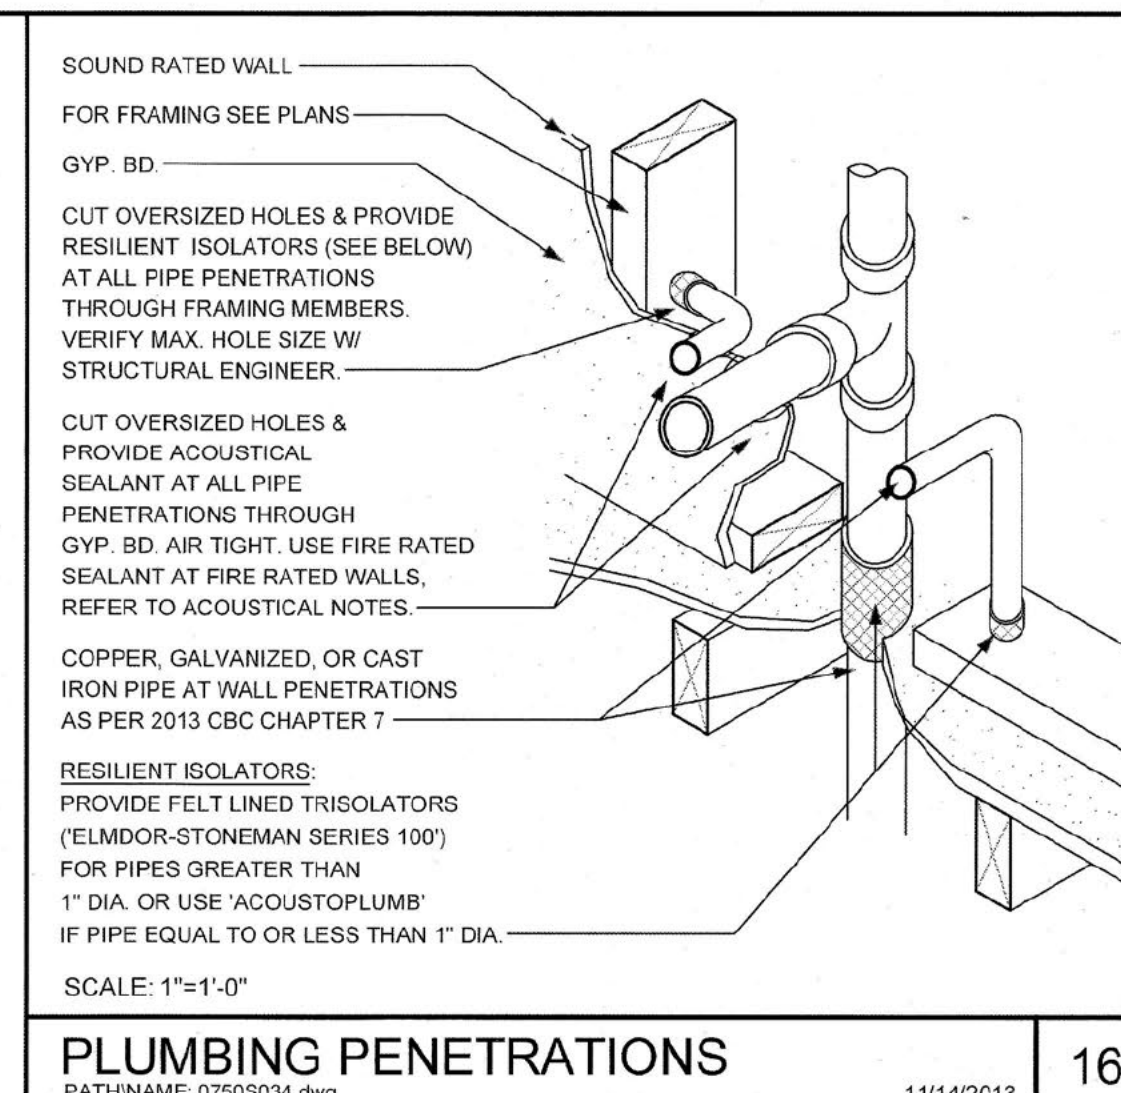





MIN. METER CLEARANCE REQ.
PATHNAME: 1699303_2013.dwg 11/19/2013 13

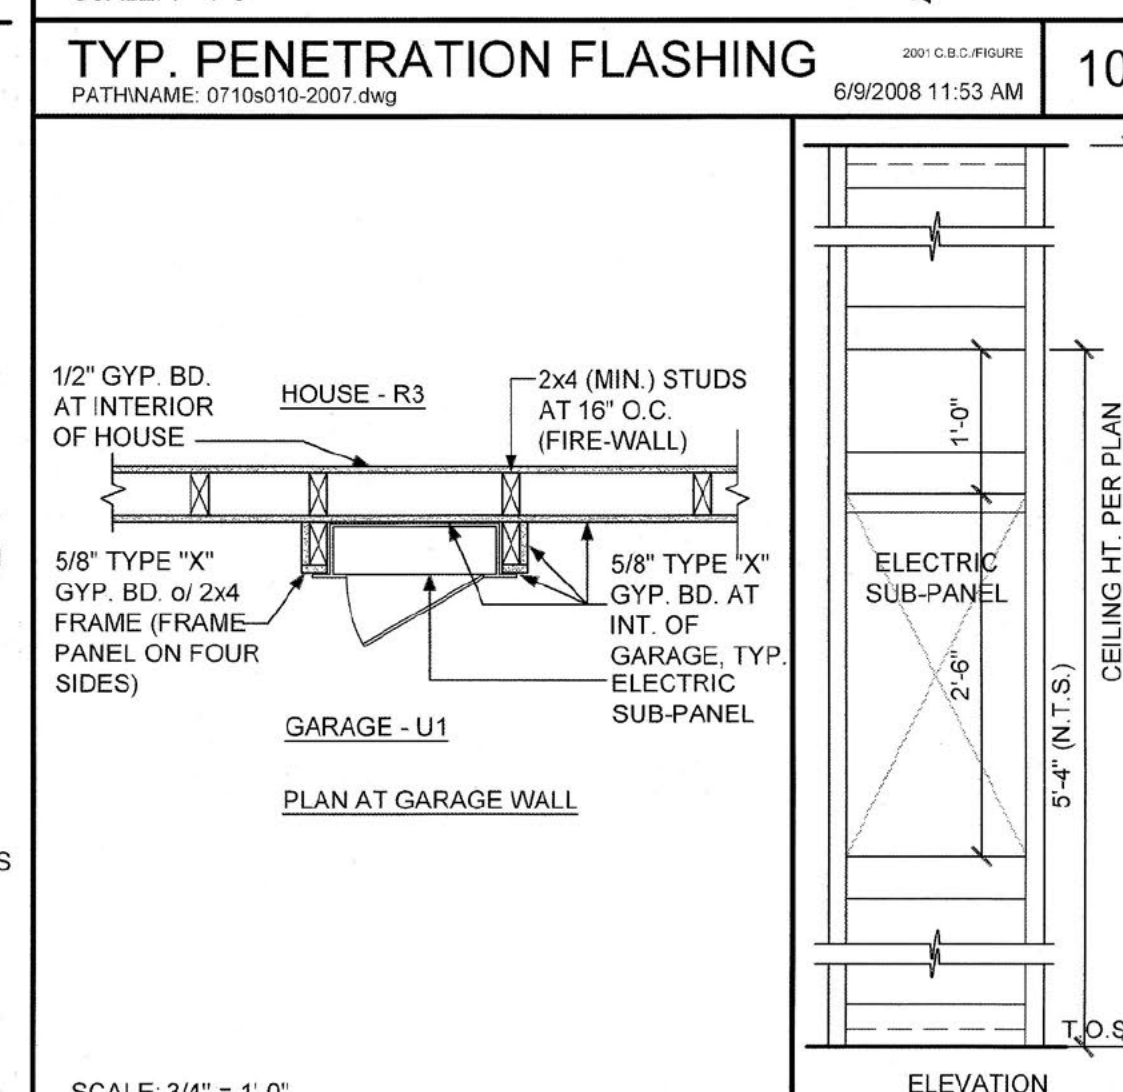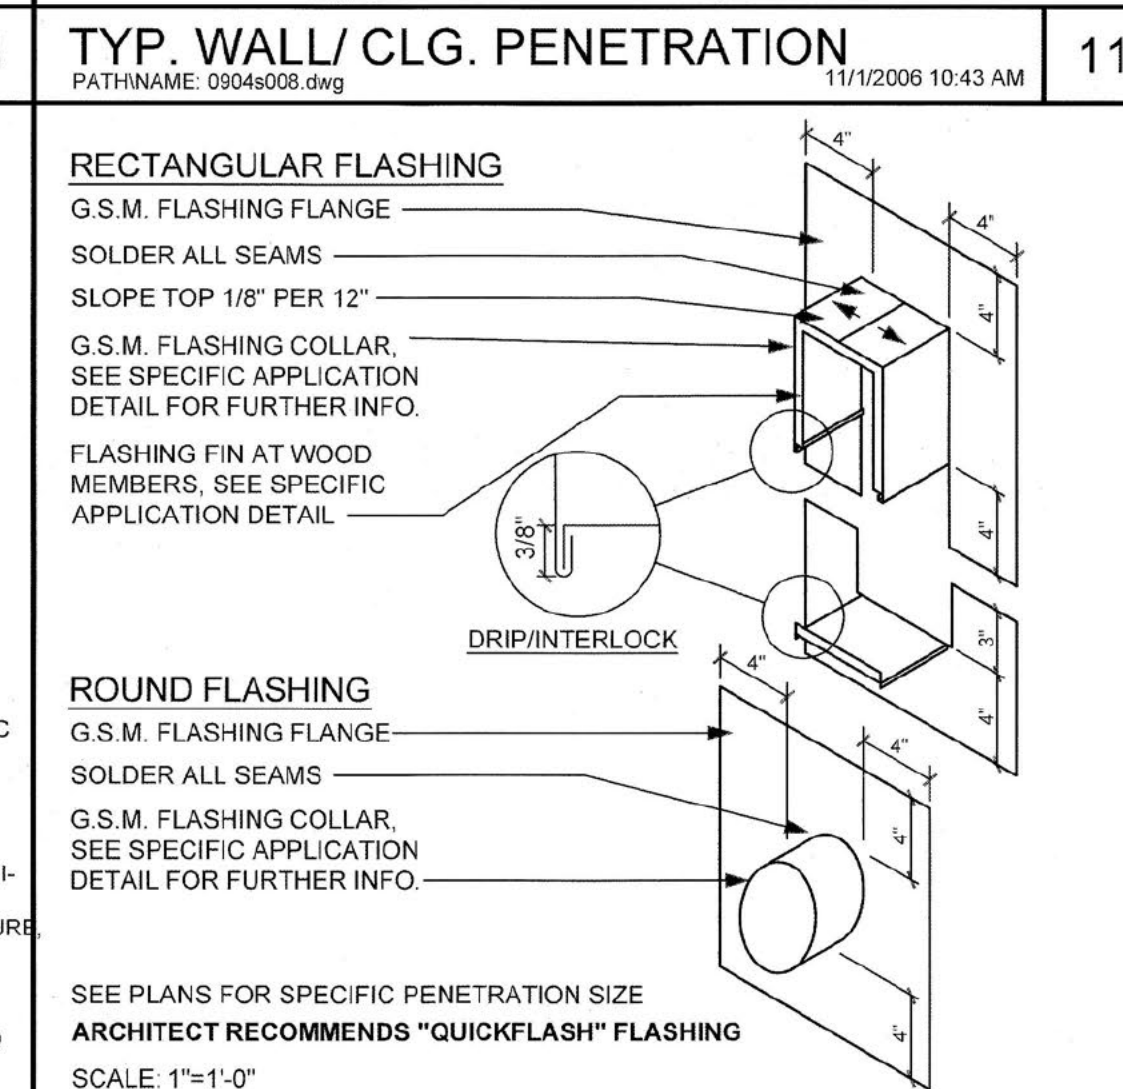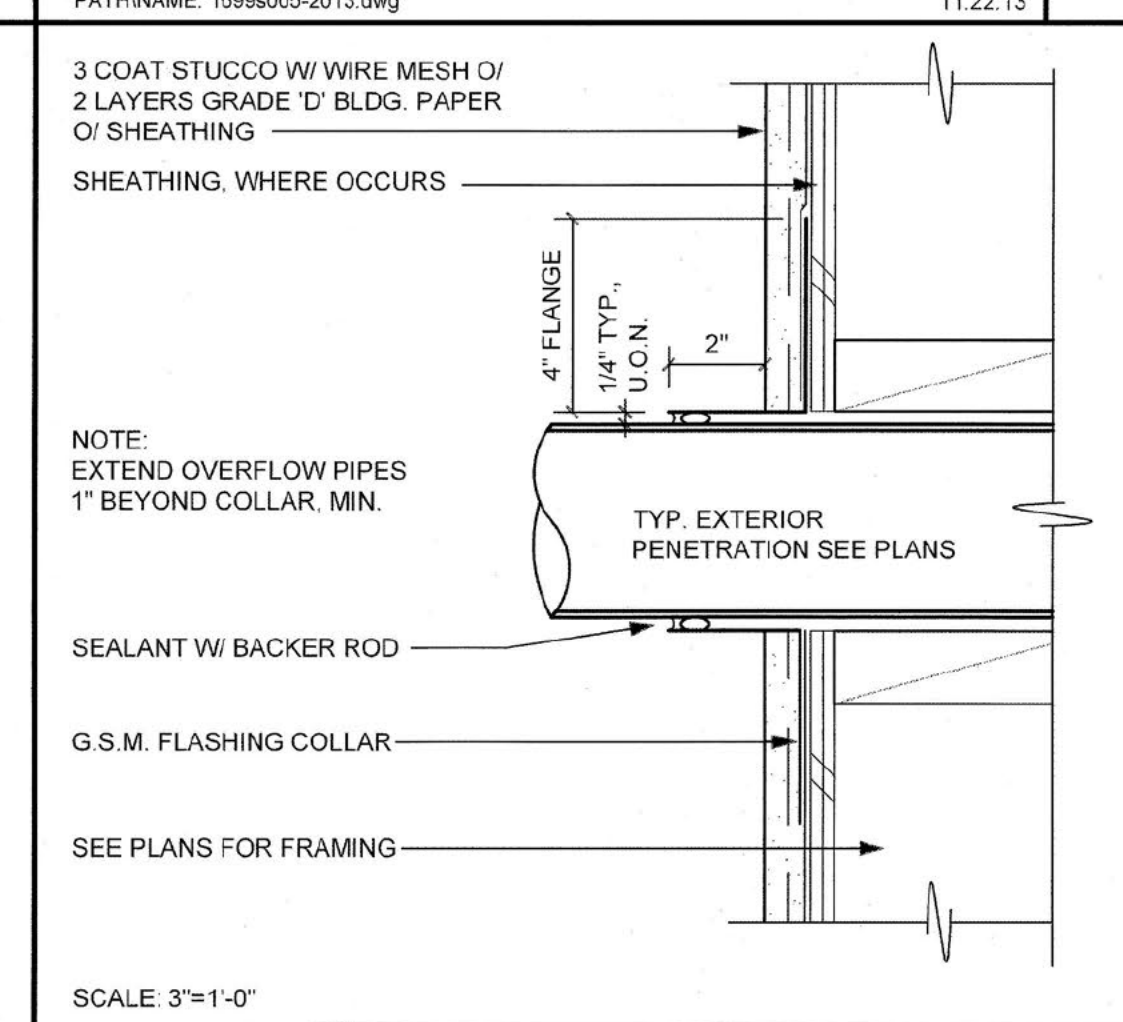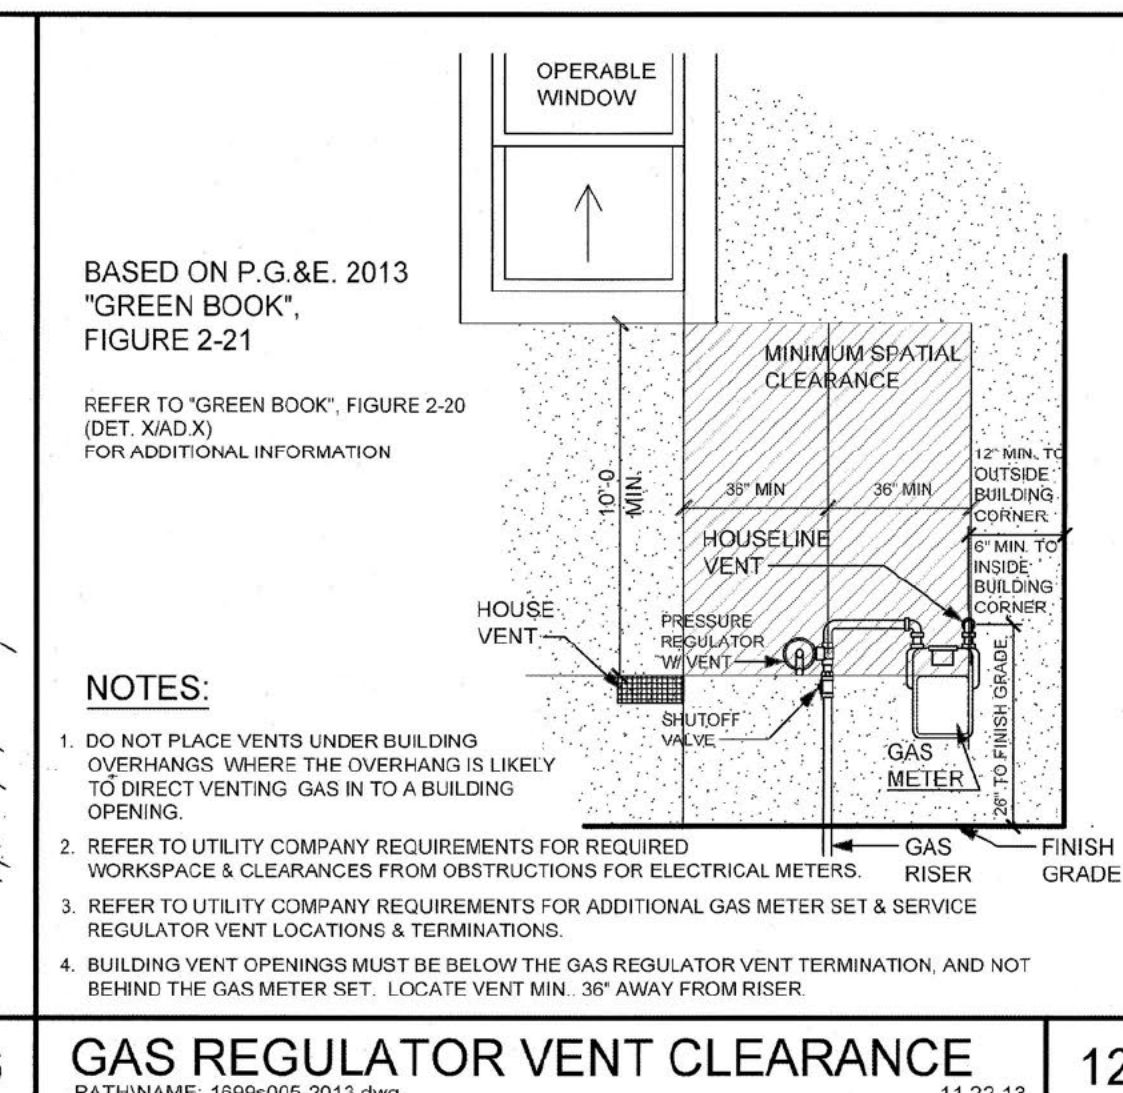

ELECTRICAL SUB-PANEL
PATHNAME: 1699303.dwg 11/19/2013 9

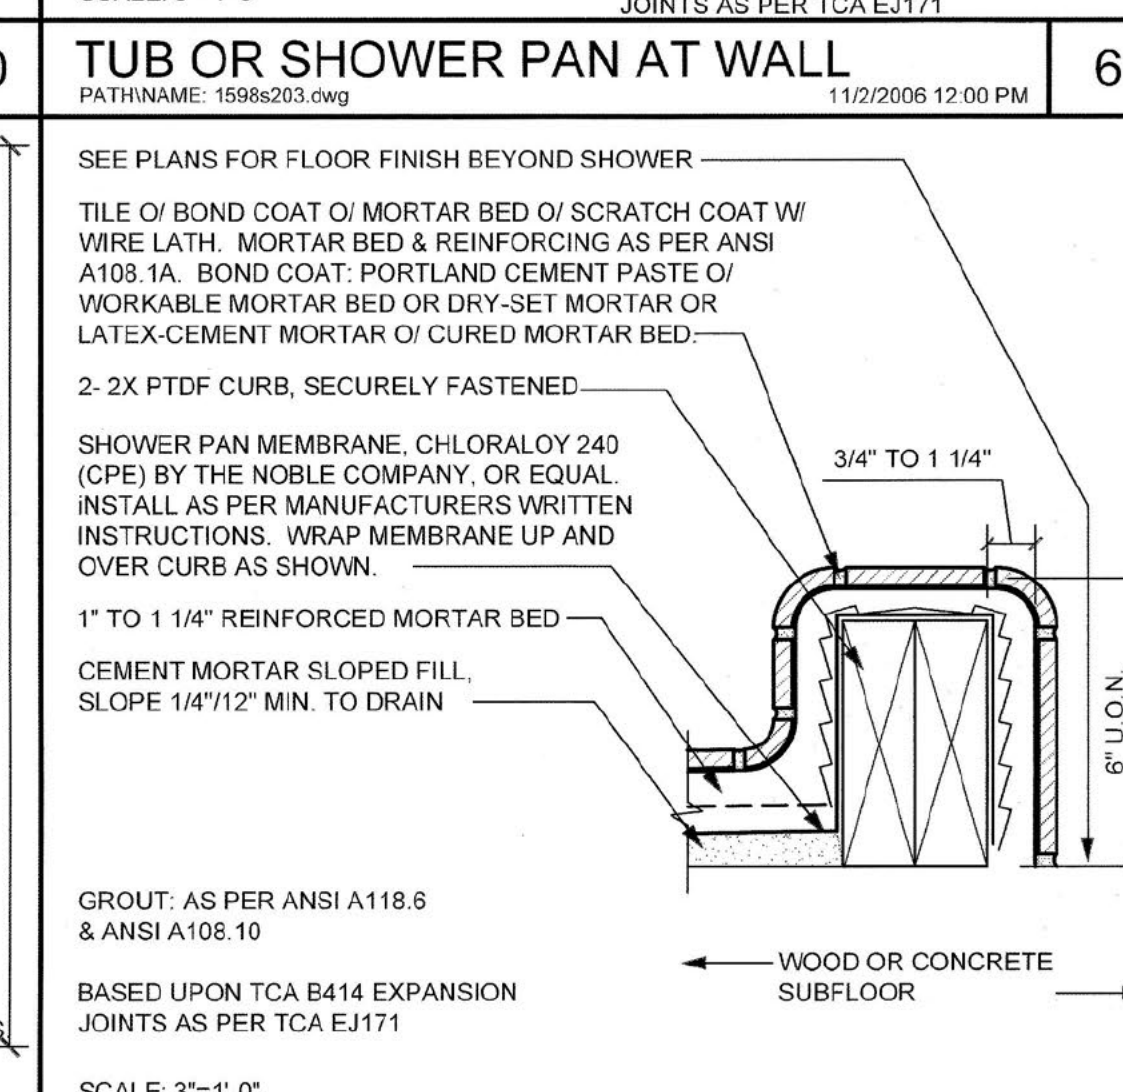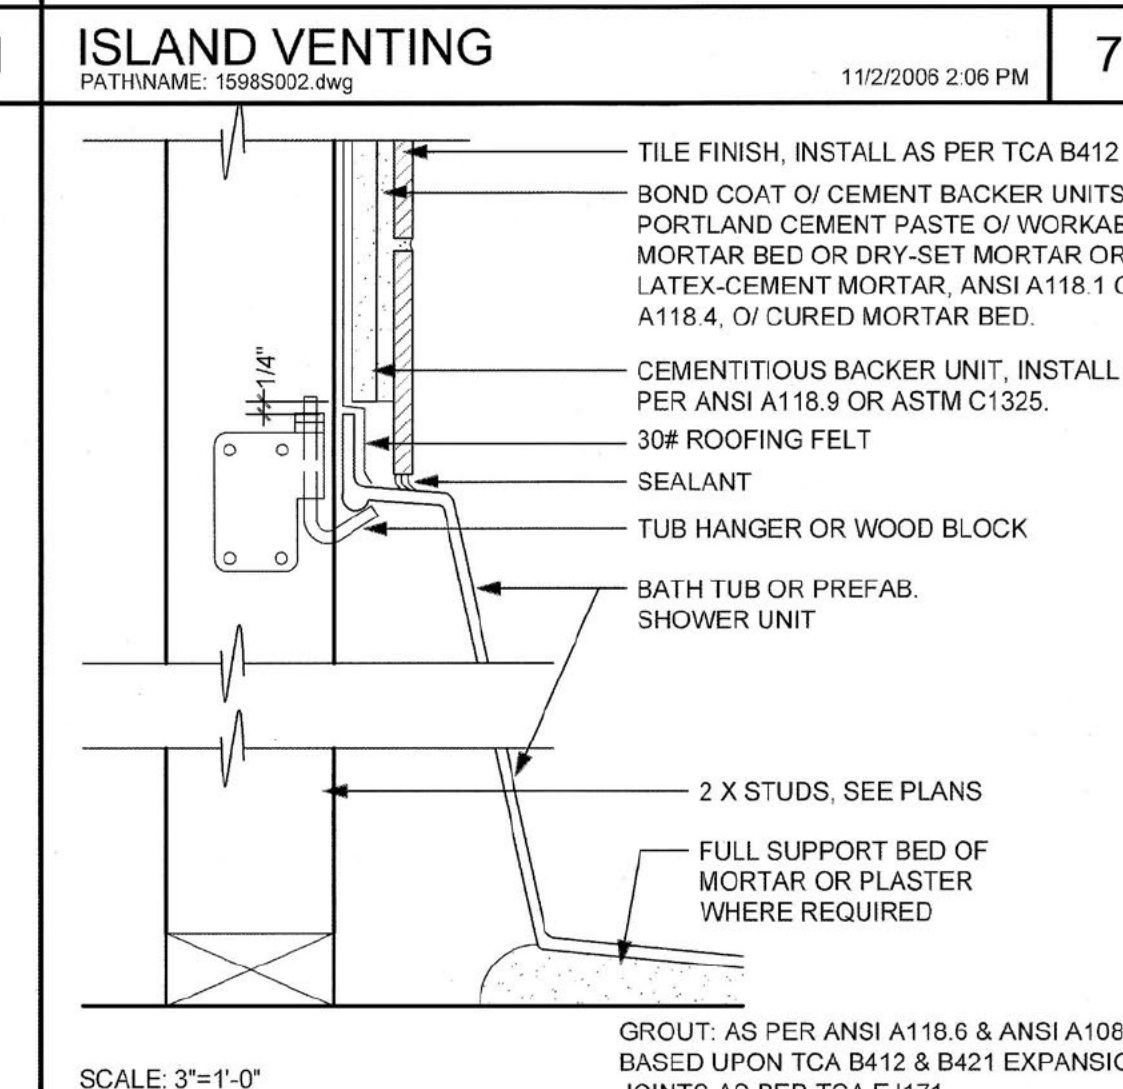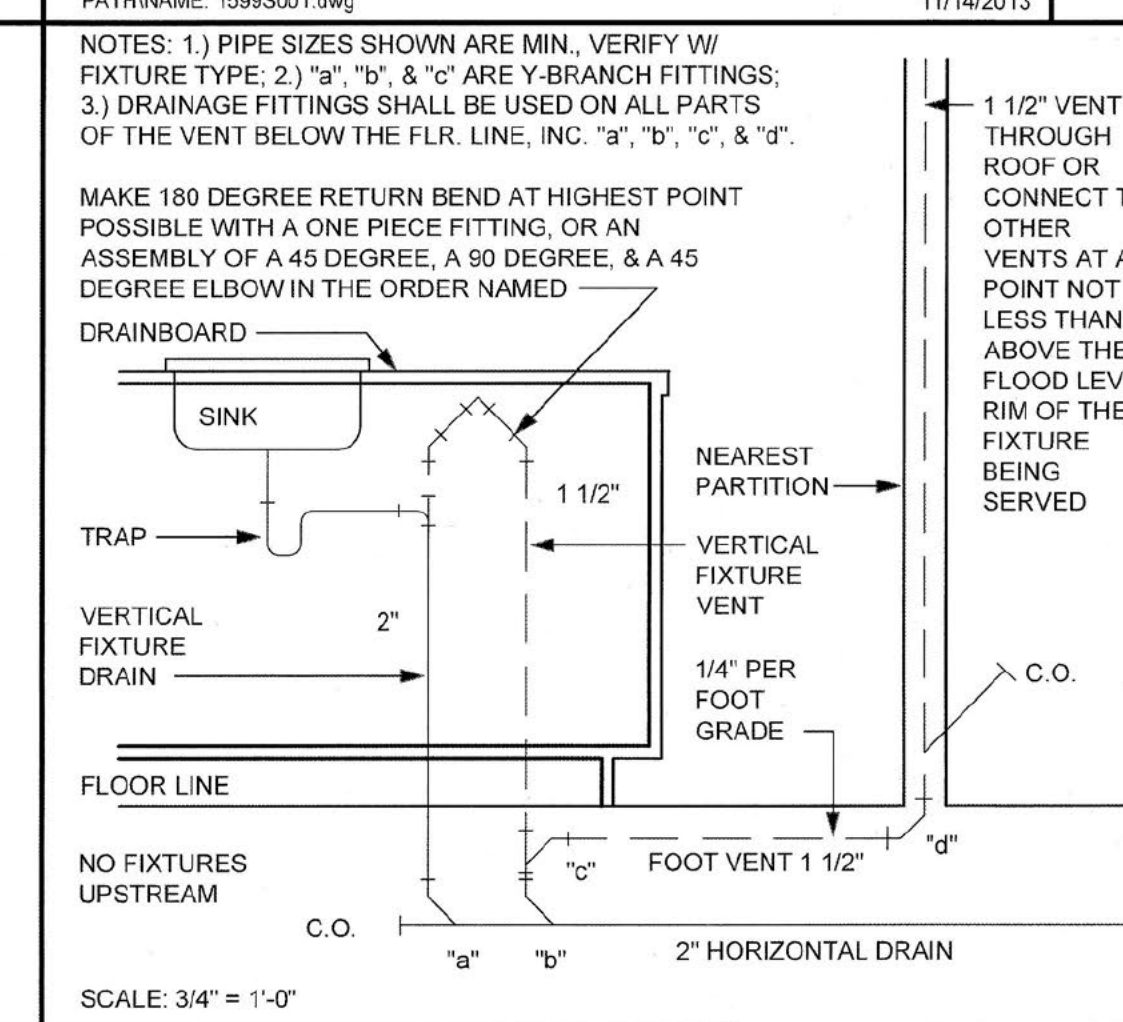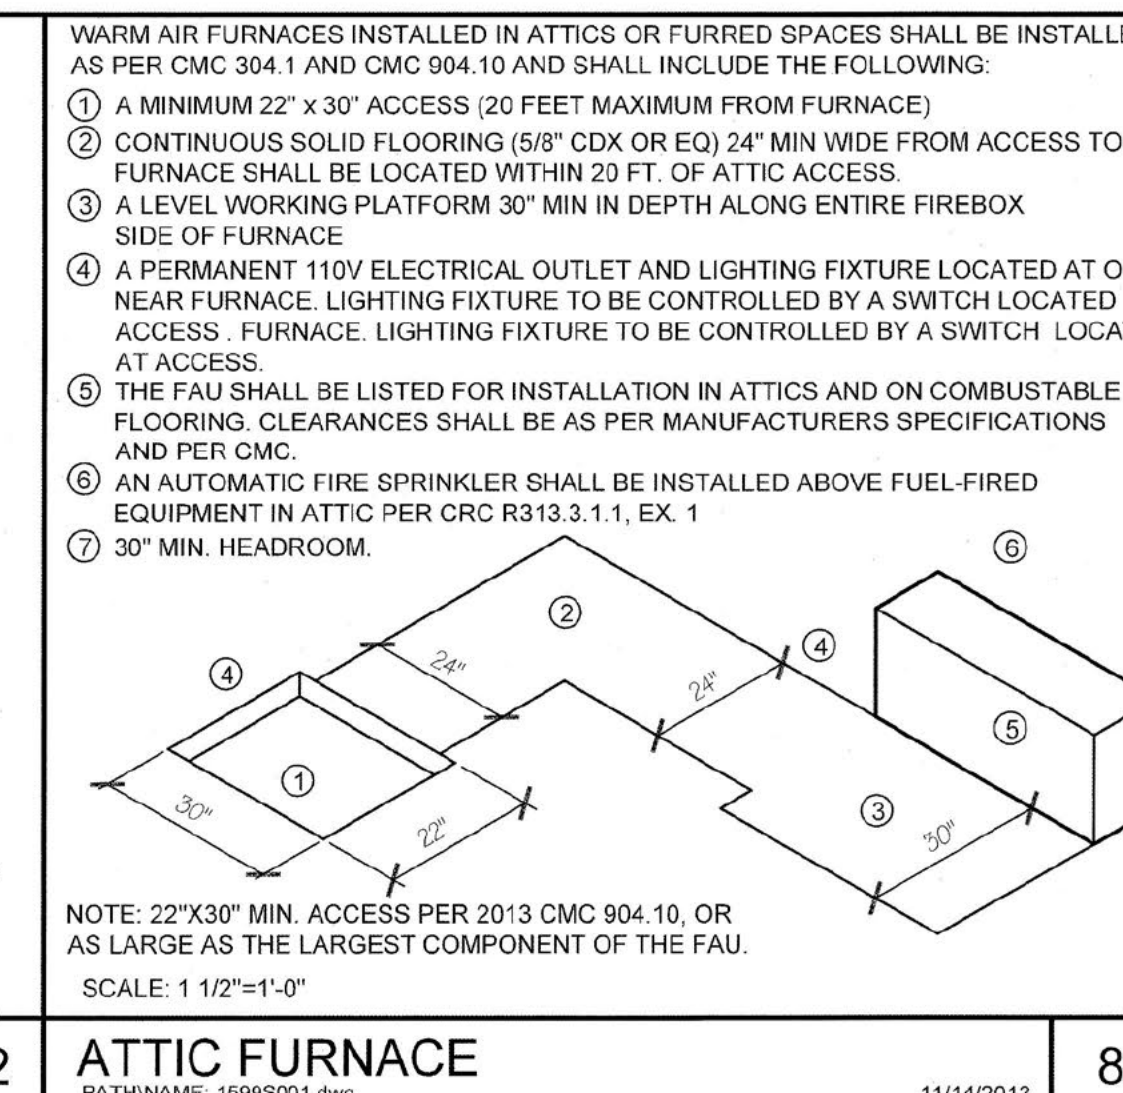

CURB AT SHOWER
PATHNAME: 1699303.dwg 11/20/2010 5

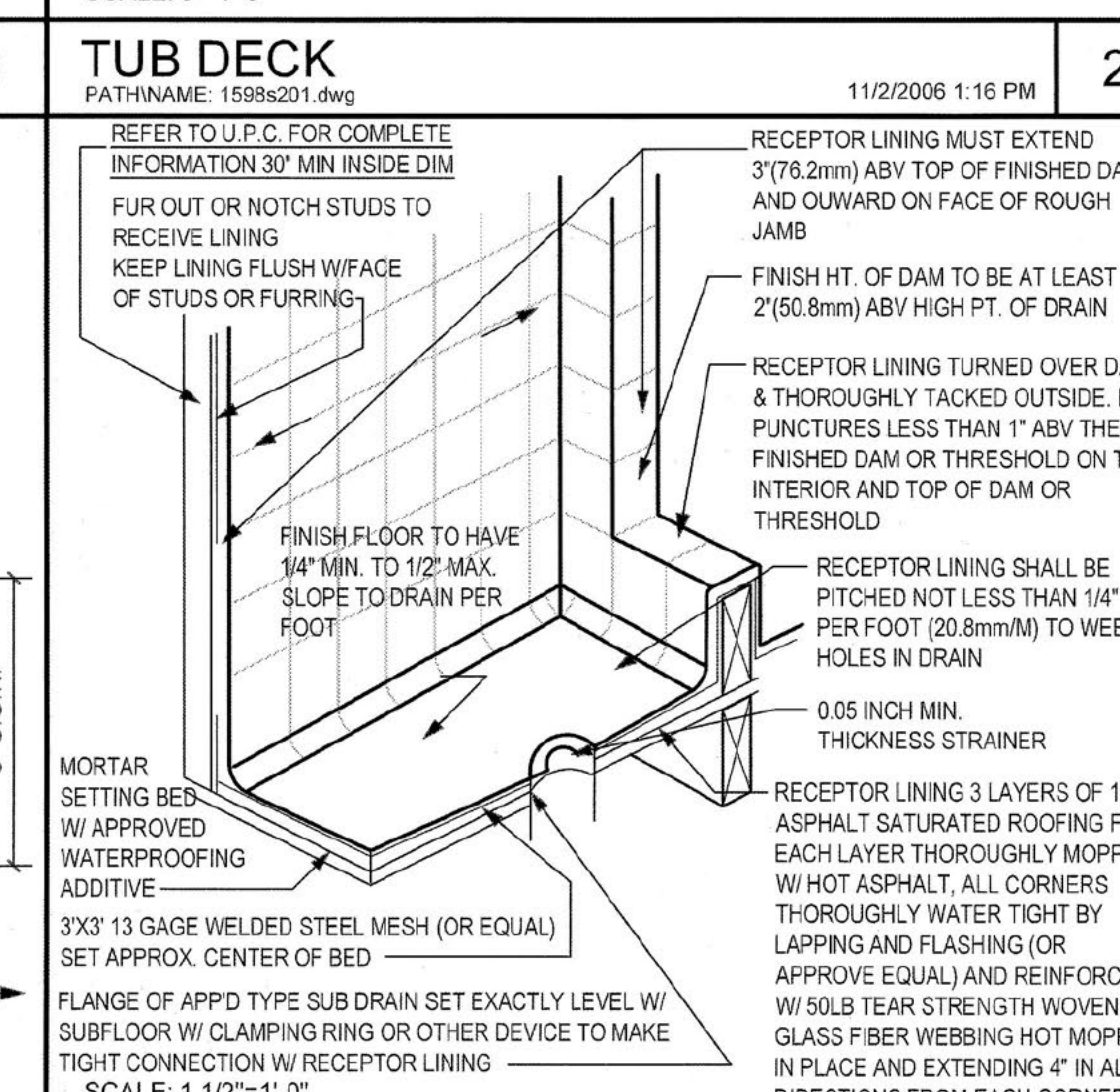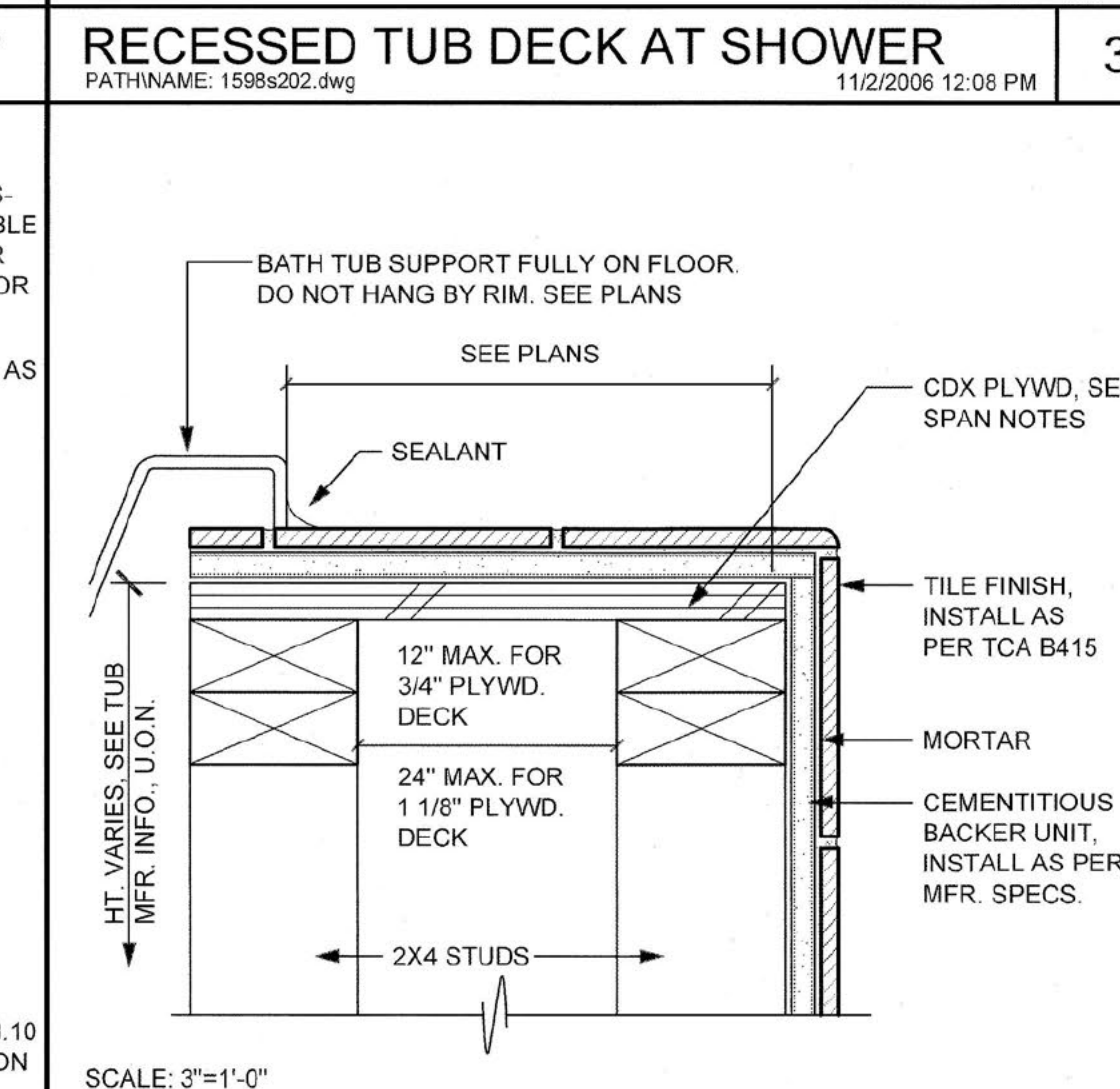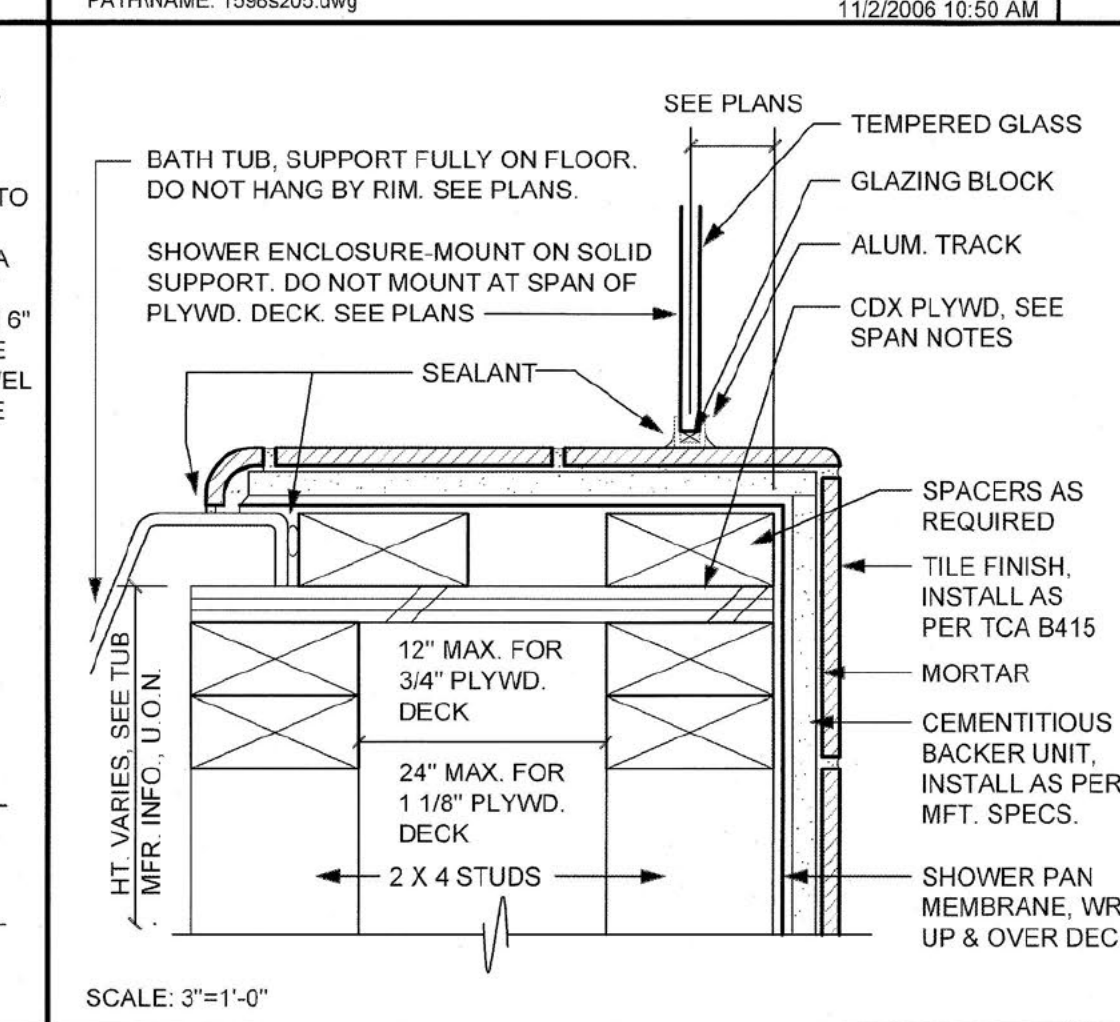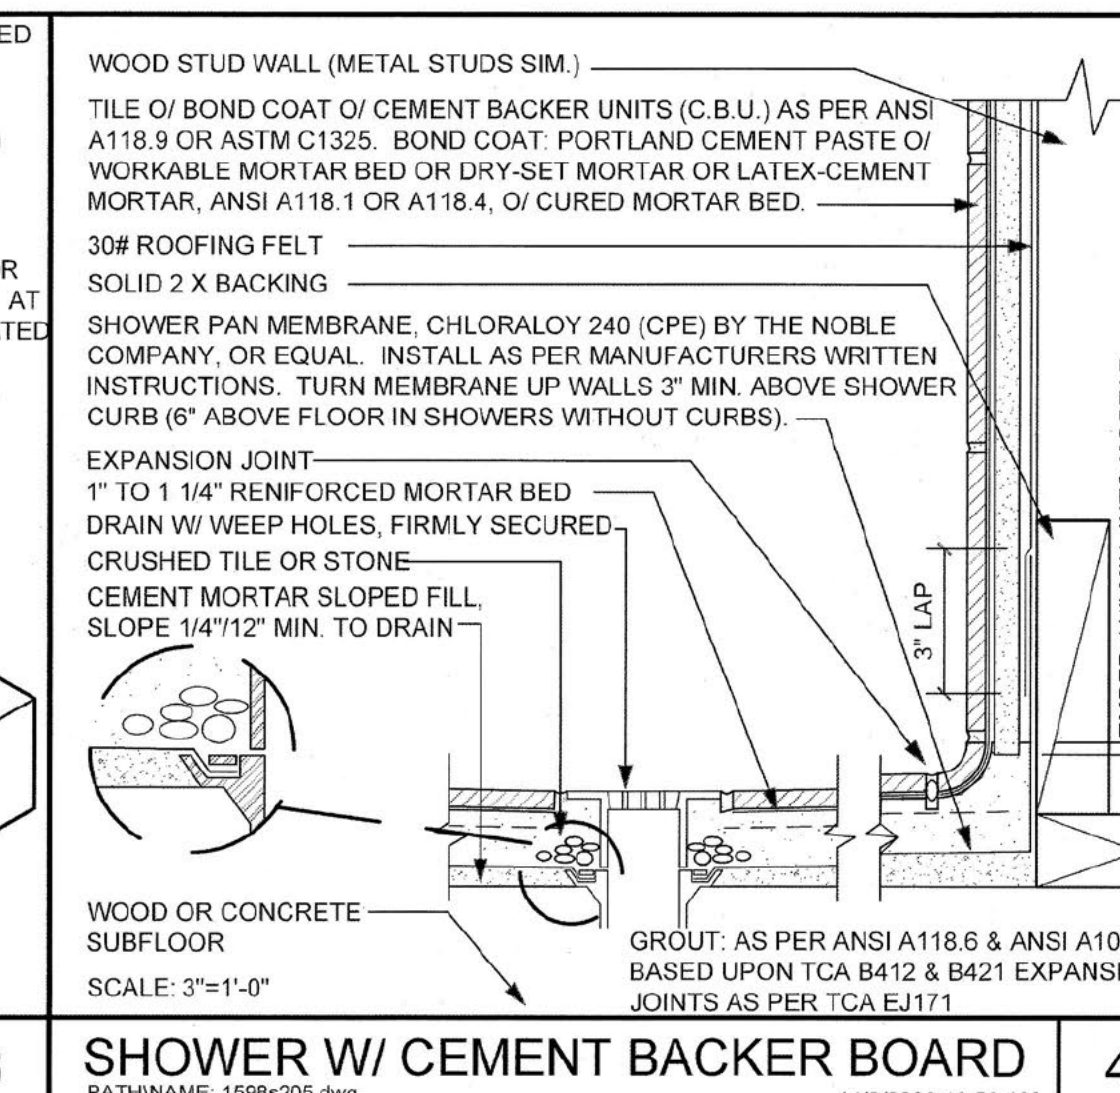

HOT MOP SHOWER RECEPTOR
PATHNAME: 1699303.dwg 11/20/2010 1

REVISIONS

- 1ST CITY PLAN CHECK 08-01-16
- IN-HOUSE REVISIONS 08-01-16

BUILDING DEPARTMENT SUBMITTAL 1 ARCHITECTURAL DETAILS

JOB NO. 1249.001 SHEET
DRAWN MWS / AMF / RG
CHECK
DATE 08-01-16 AD.1

REVISIONS

REVISION INFO



Engineer

Structural

STRUCTURAL NOTES AND NAILING SCHEDULE

Sheet Title:

Client:

Date: 4/15/16

Scale: AS NOTED

Drawn: RAS

Job: 16-031

CAD File: 16-031-SN.DWG

Sheet:

SN

Table with 3 columns: CONNECTION, FASTENING, LOCATION. Lists various connection types such as JOIST TO SILL OR GIRDER, BRIDGING TO JOIST, etc., with corresponding fastening requirements and locations.

Table with 2 columns: CONNECTION, FASTENING. Lists connections for wood structural panels, panel siding, fiberboard sheathing, and interior paneling with specific fastening details.

FOR S: 1 INCH = 25.4 MM. Includes general notes and specific requirements for nailing, fasteners, and framing lumber.

SHEAR WALL SCHEDULE

Table for Shear Wall Schedule with columns: NUMBER, SURFACE MATERIAL, NAILING, SILL PLATE CONNECTION, TOP PLATE TO BLOCKING, ALL SHEAR (PLF). Details nailing and fastening for various wall materials.

SHEARWALL NOTES. Includes instructions for nailing, fastener spacing, and blocking for shear walls.

STRUCTURAL NOTES

GENERAL: THE INTENT OF THESE DRAWINGS IS TO SHOW ALL ITEMS NECESSARY TO COMPLETE THE STRUCTURE. TYPICAL DETAILS AND NOTES WITHIN THESE CALCULATIONS SHALL APPLY TO SIMILAR CONDITIONS, UNLESS SPECIFICALLY NOTED OTHERWISE.

OR GENERAL

- GR-1) WORK SHOWN IS NEW UNLESS NOTED AS EXISTING. (E). GR-2) DRAWINGS REPRESENT COMPLETE NEW WORK.

CD - DESIGN BASIS


Table of Design Basis parameters: SEISMIC DESIGN DATA, RISK CAT, S, I, WIND SPEED, WIND EXPOSURE, SITE CLASS, SEISMIC CATEGORY, DESIGN COOR, LONGITUDE COOR.

ROOF FRAMING PLAN TRUSS NOTES

A. PRE-FABRICATED TRUSSES SHALL BE DESIGNED BY A CALIFORNIA LICENSED ENGINEER PRIOR TO FABRICATION OF TRUSSES. B. TRUSS MANUFACTURER SHALL OBTAIN CALCULATIONS FROM THE TRUSS MANUFACTURERS STRUCTURAL ENGINEER PRIOR TO INSTALLATION OF THE TRUSSES.


DESIGN LOADS: WIND SPEED: 110 MPH EXPOSURE: "B" ROOF MEAN HEIGHT: 34' LIVE LOAD = 20 PSF DEAD LOAD: TOP CHORD = 12 PSF BOTTOM CHORD = 7.5 PSF

REVISIONS	BY
1	DAN
2	
3	
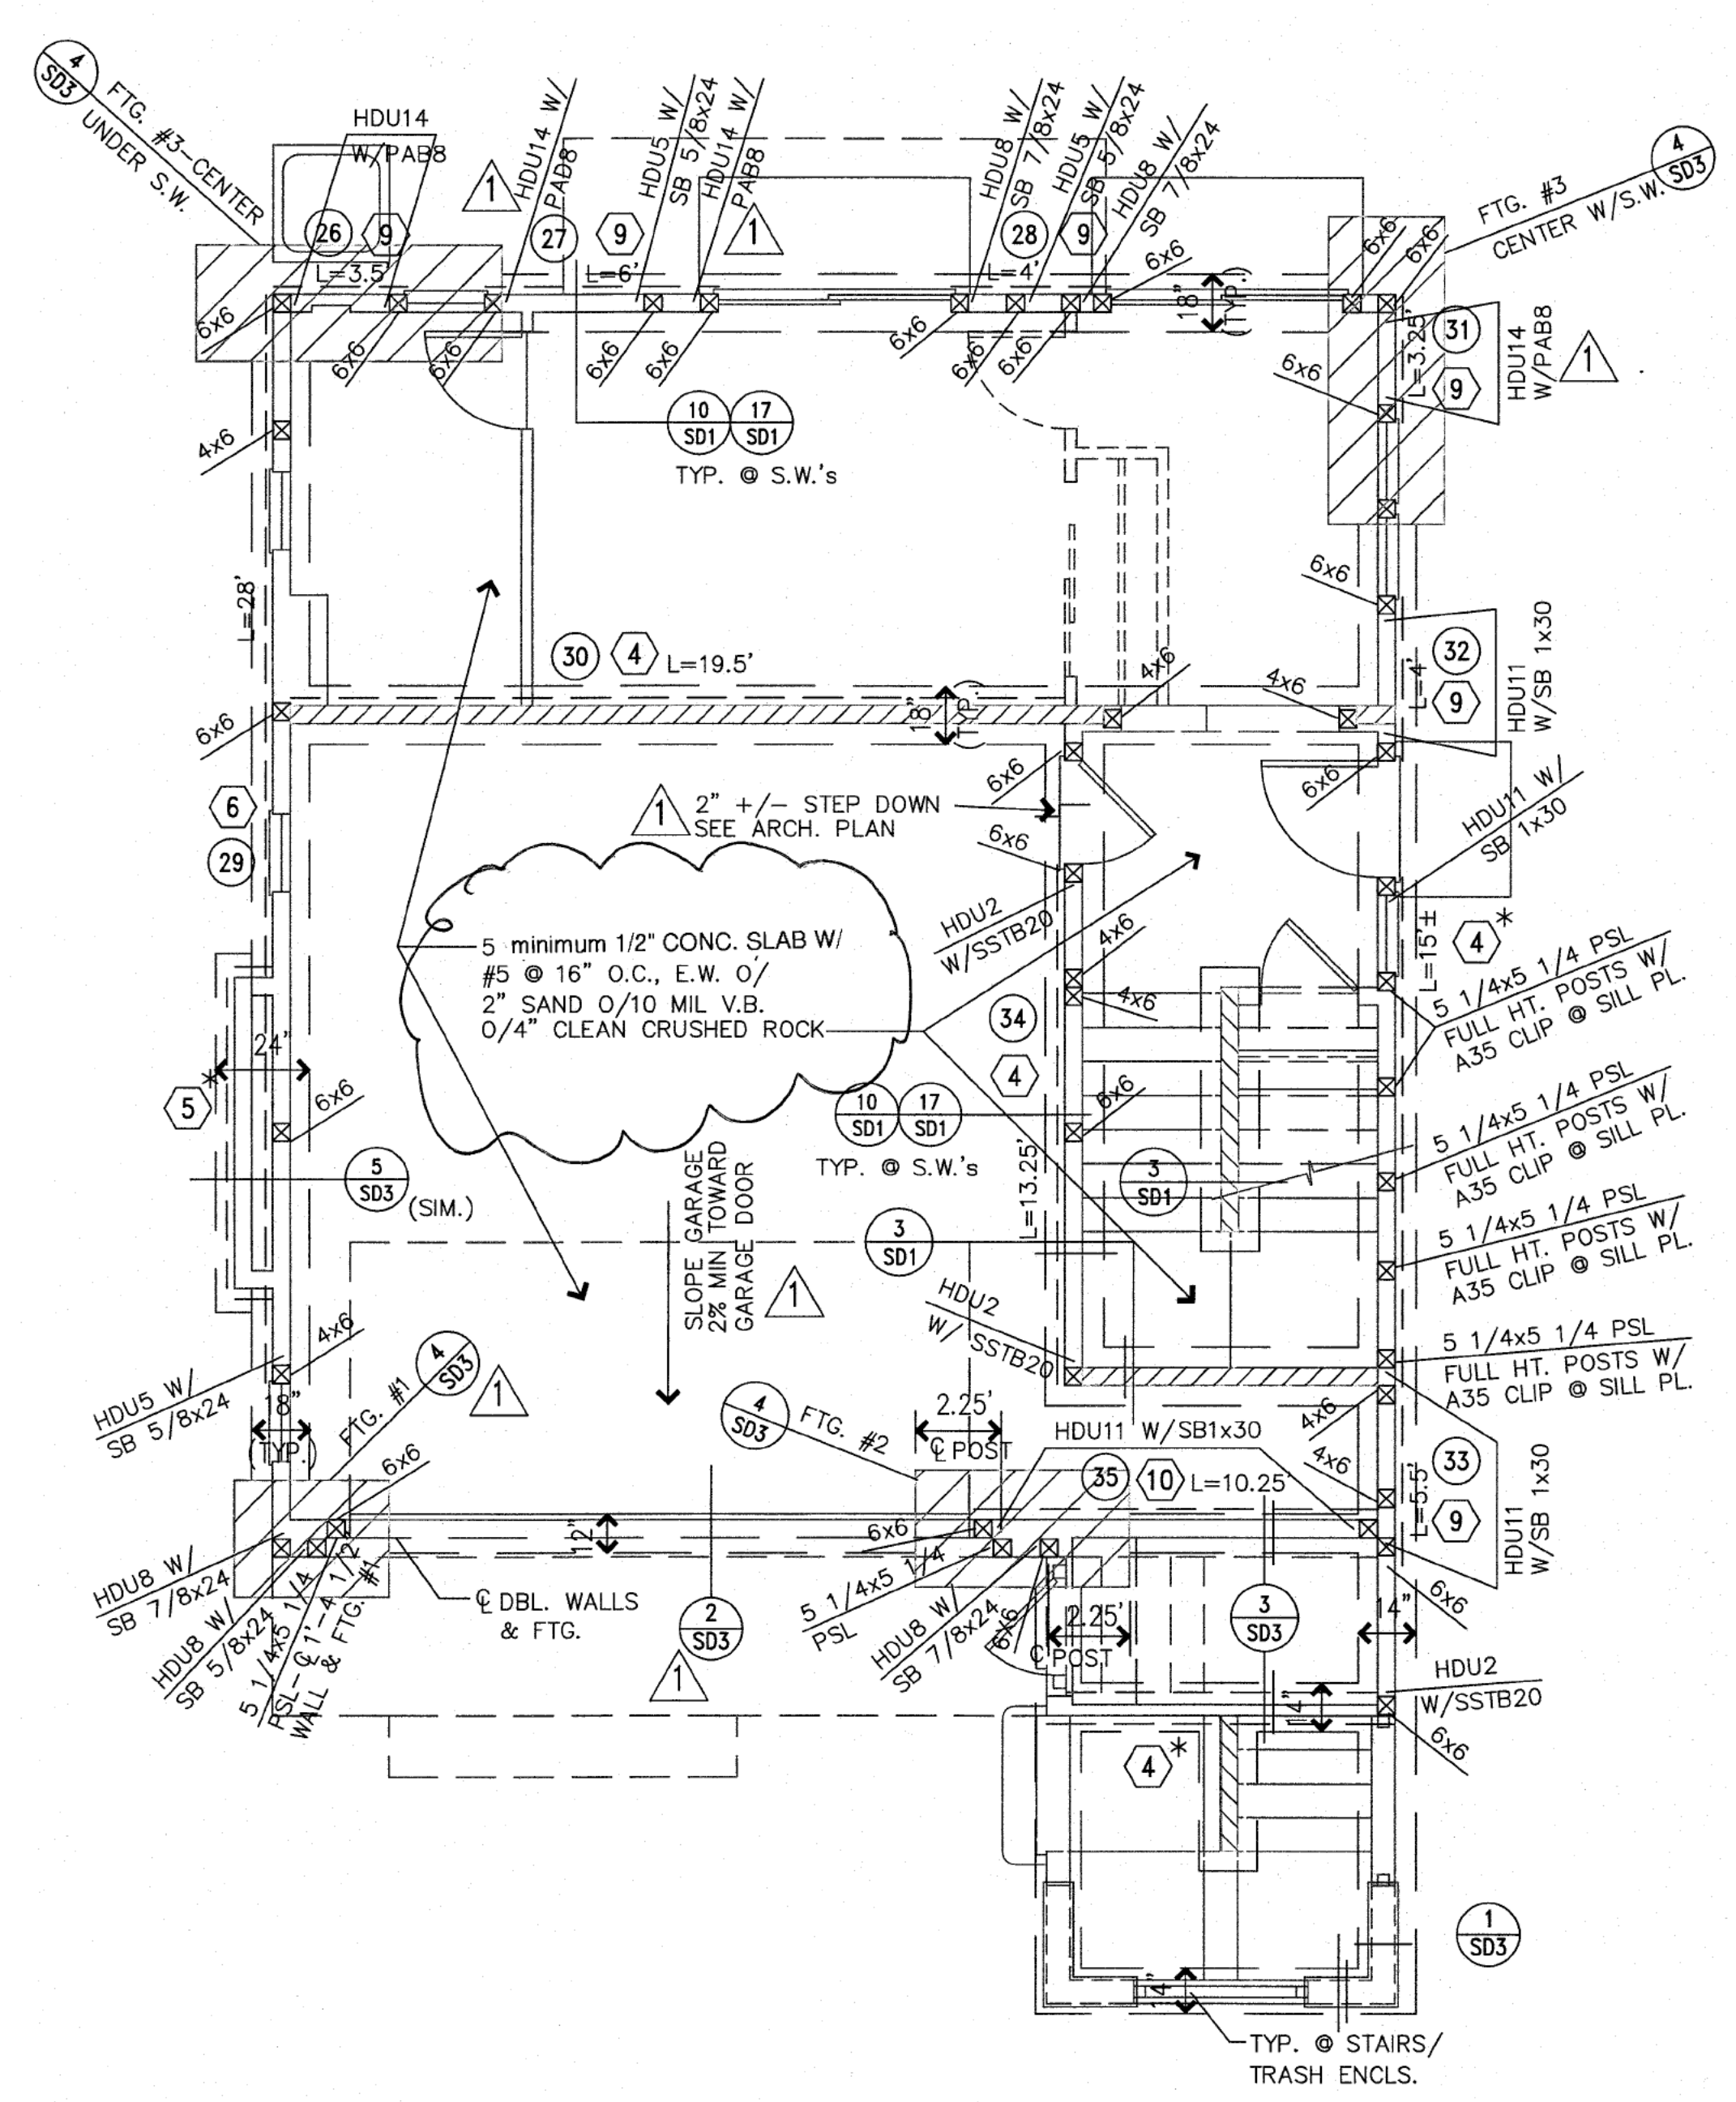

PLAN A & B FOUNDATION PLAN

1

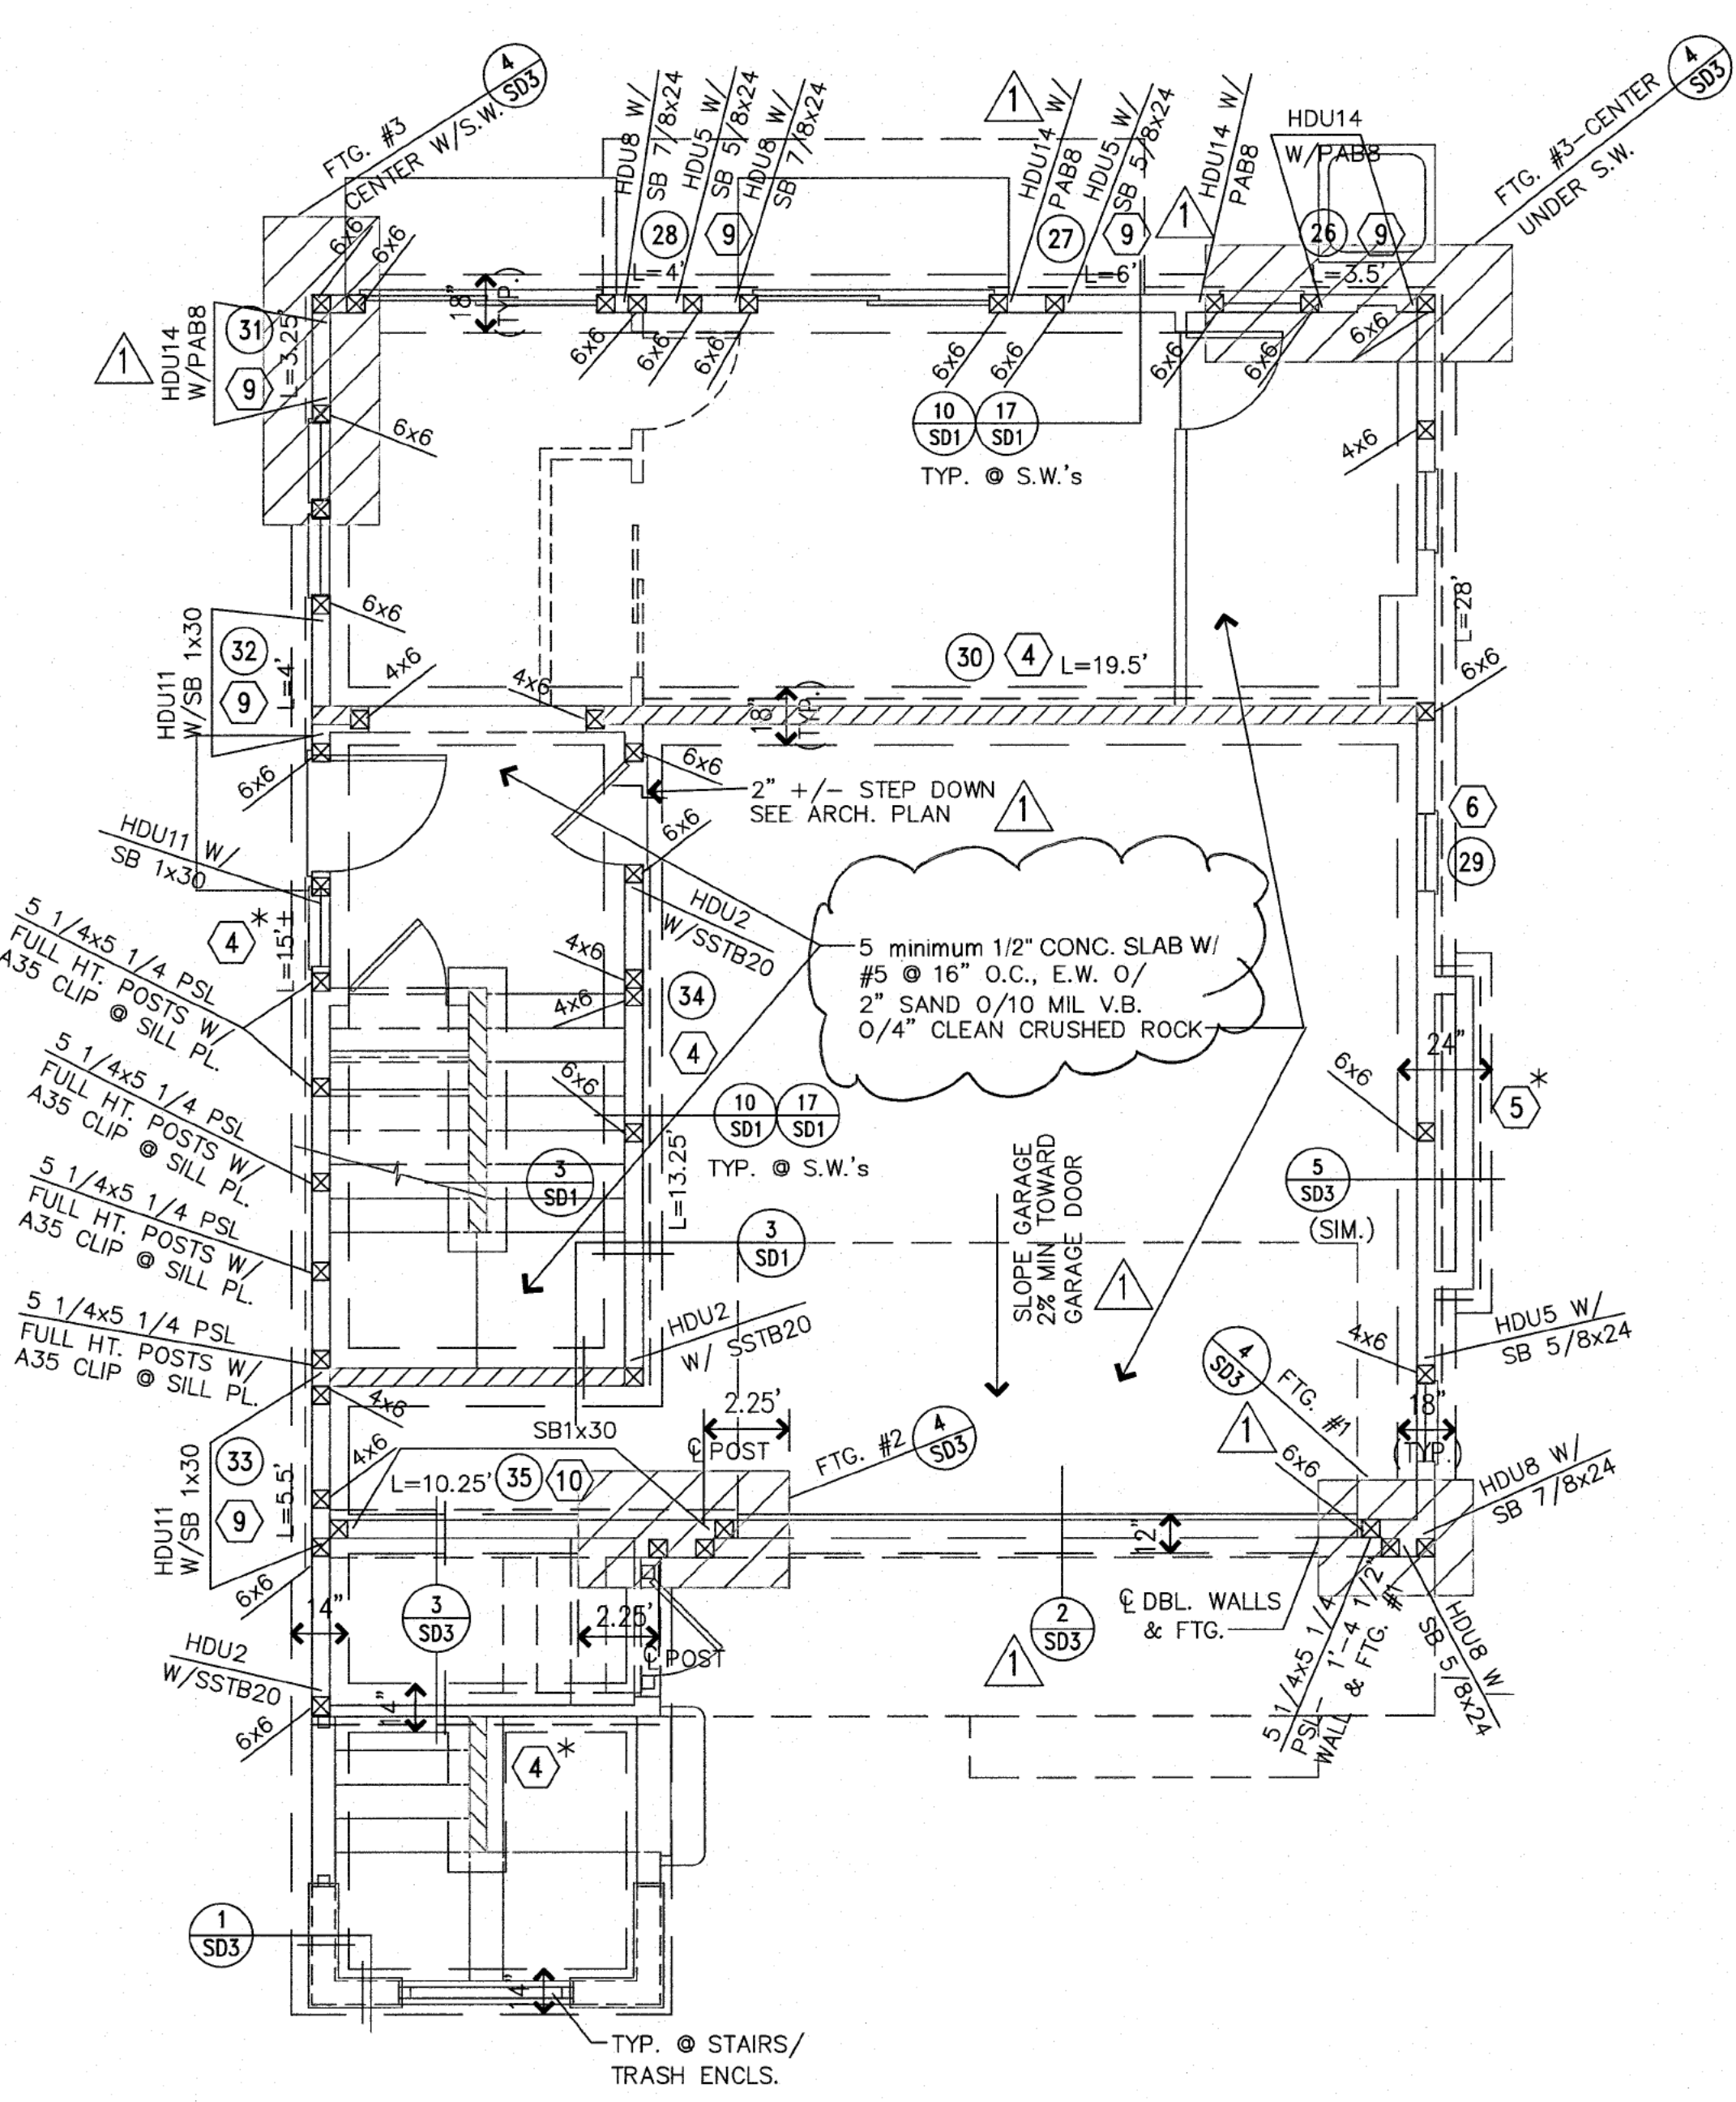

PLAN A REVERSE FOUNDATION PLAN

2

FOUNDATION NOTES:

- WOOD POSTS: (PRESSURE TREATED AS REQ'D.)
- SILL PLATE: 3x P.T. DF#2 OF SILL PLATES. CONTINUE ALL POSTS TO FOUNDATION, U.O.N.
- ANCHOR BOLTS: A307
- CONTRACTOR TO VERIFY ALL DIMENSIONS WITH ARCHITECTURAL PLANS. ARCHITECTURAL PLAN DIMENSIONS SHALL SUPERSEDE STRUCTURAL PLAN DIMENSIONS. CONTACT ENGINEER WITH DISCREPANCIES.
- REFERENCE SHEETS SN & SD1 FOR STRUCTURAL NOTES AND SHEAR TRANSFER INFORMATION.
- ALL BOLTS, NAILS, SCREWS, STAPLES AND ANY OTHER CONNECTORS FOR PRESSURE TREATED WOOD AND WOOD EXPOSED TO WEATHER, SHALL BE HOT-DIPPED ZINC-COATED GALVANIZED, STAINLESS STEEL, SILICON BRONZE OR COPPER, PER SECTION 2304.8.3 OF THE UBC. DO NOT MIX TYPES OF CONNECTORS.
- ALL EXTERIOR WALLS ARE 2X6 DF#2 @16" OC. (U.O.N.)
ALL INTERIOR WALLS ARE 2X4 DF#2 @16" OC. (U.O.N.)

MAIN FLOOR FRAMING & FOUNDATION LEGEND:

- POST PER PLAN, (PRESSURE TREATED AS REQUIRED)
- SHEAR WALL (S.W.), REF. DET. 10/SD1
- REDUNDANT SHEAR WALL - NOT PART OF STRUCTURAL CALC.
- INTERIOR TRUSS BEARING WALLS OR BEAMS
- SHEARWALL TYPE (REF. SW SCHEDULE, SHEET SN)
- SHEAR WALL I.D. NUMBER
- SHEAR WALL LENGTH
- HOLDOWN TYPE & ANCHOR BOLT @ FOUNDATION. REF. DETAILS 17/SD.1 &/OR 4/SD.3

- U.O.N. UNLESS OTHERWISE NOTED
- O.C. ON CENTER
- T.P. TOP PLATE
- F.V. FIELD VERIFY


FOOTING SCHEDULE:

- FTG. #1: 3' x 4' x 30" DEEP W/(3) #5'S LONG DIRC., (4) #5'S SHORT, T&B
 - FTG. #2: 3' x 4' x 30" DEEP W/(3) #5'S LONG DIRC., (5) #5'S SHORT, T&B
 - FTG. #3: 3' x 8' x 30" DEEP W/(3) #5'S LONG DIRC., (6) #5'S SHORT, T&B
- with 12" of overexcavation and replacing with non-expansive engineered fill compacted to minimum 95% relative compaction

STRUCTURAL PLANS

Date:	3/15/16
Scale:	1/4"=1'-0"
Author:	PAT
Check:	15-031
Drawn:	15-031-S1

REV.	PER PLAN CK.	DAN	BY
6/13/16			

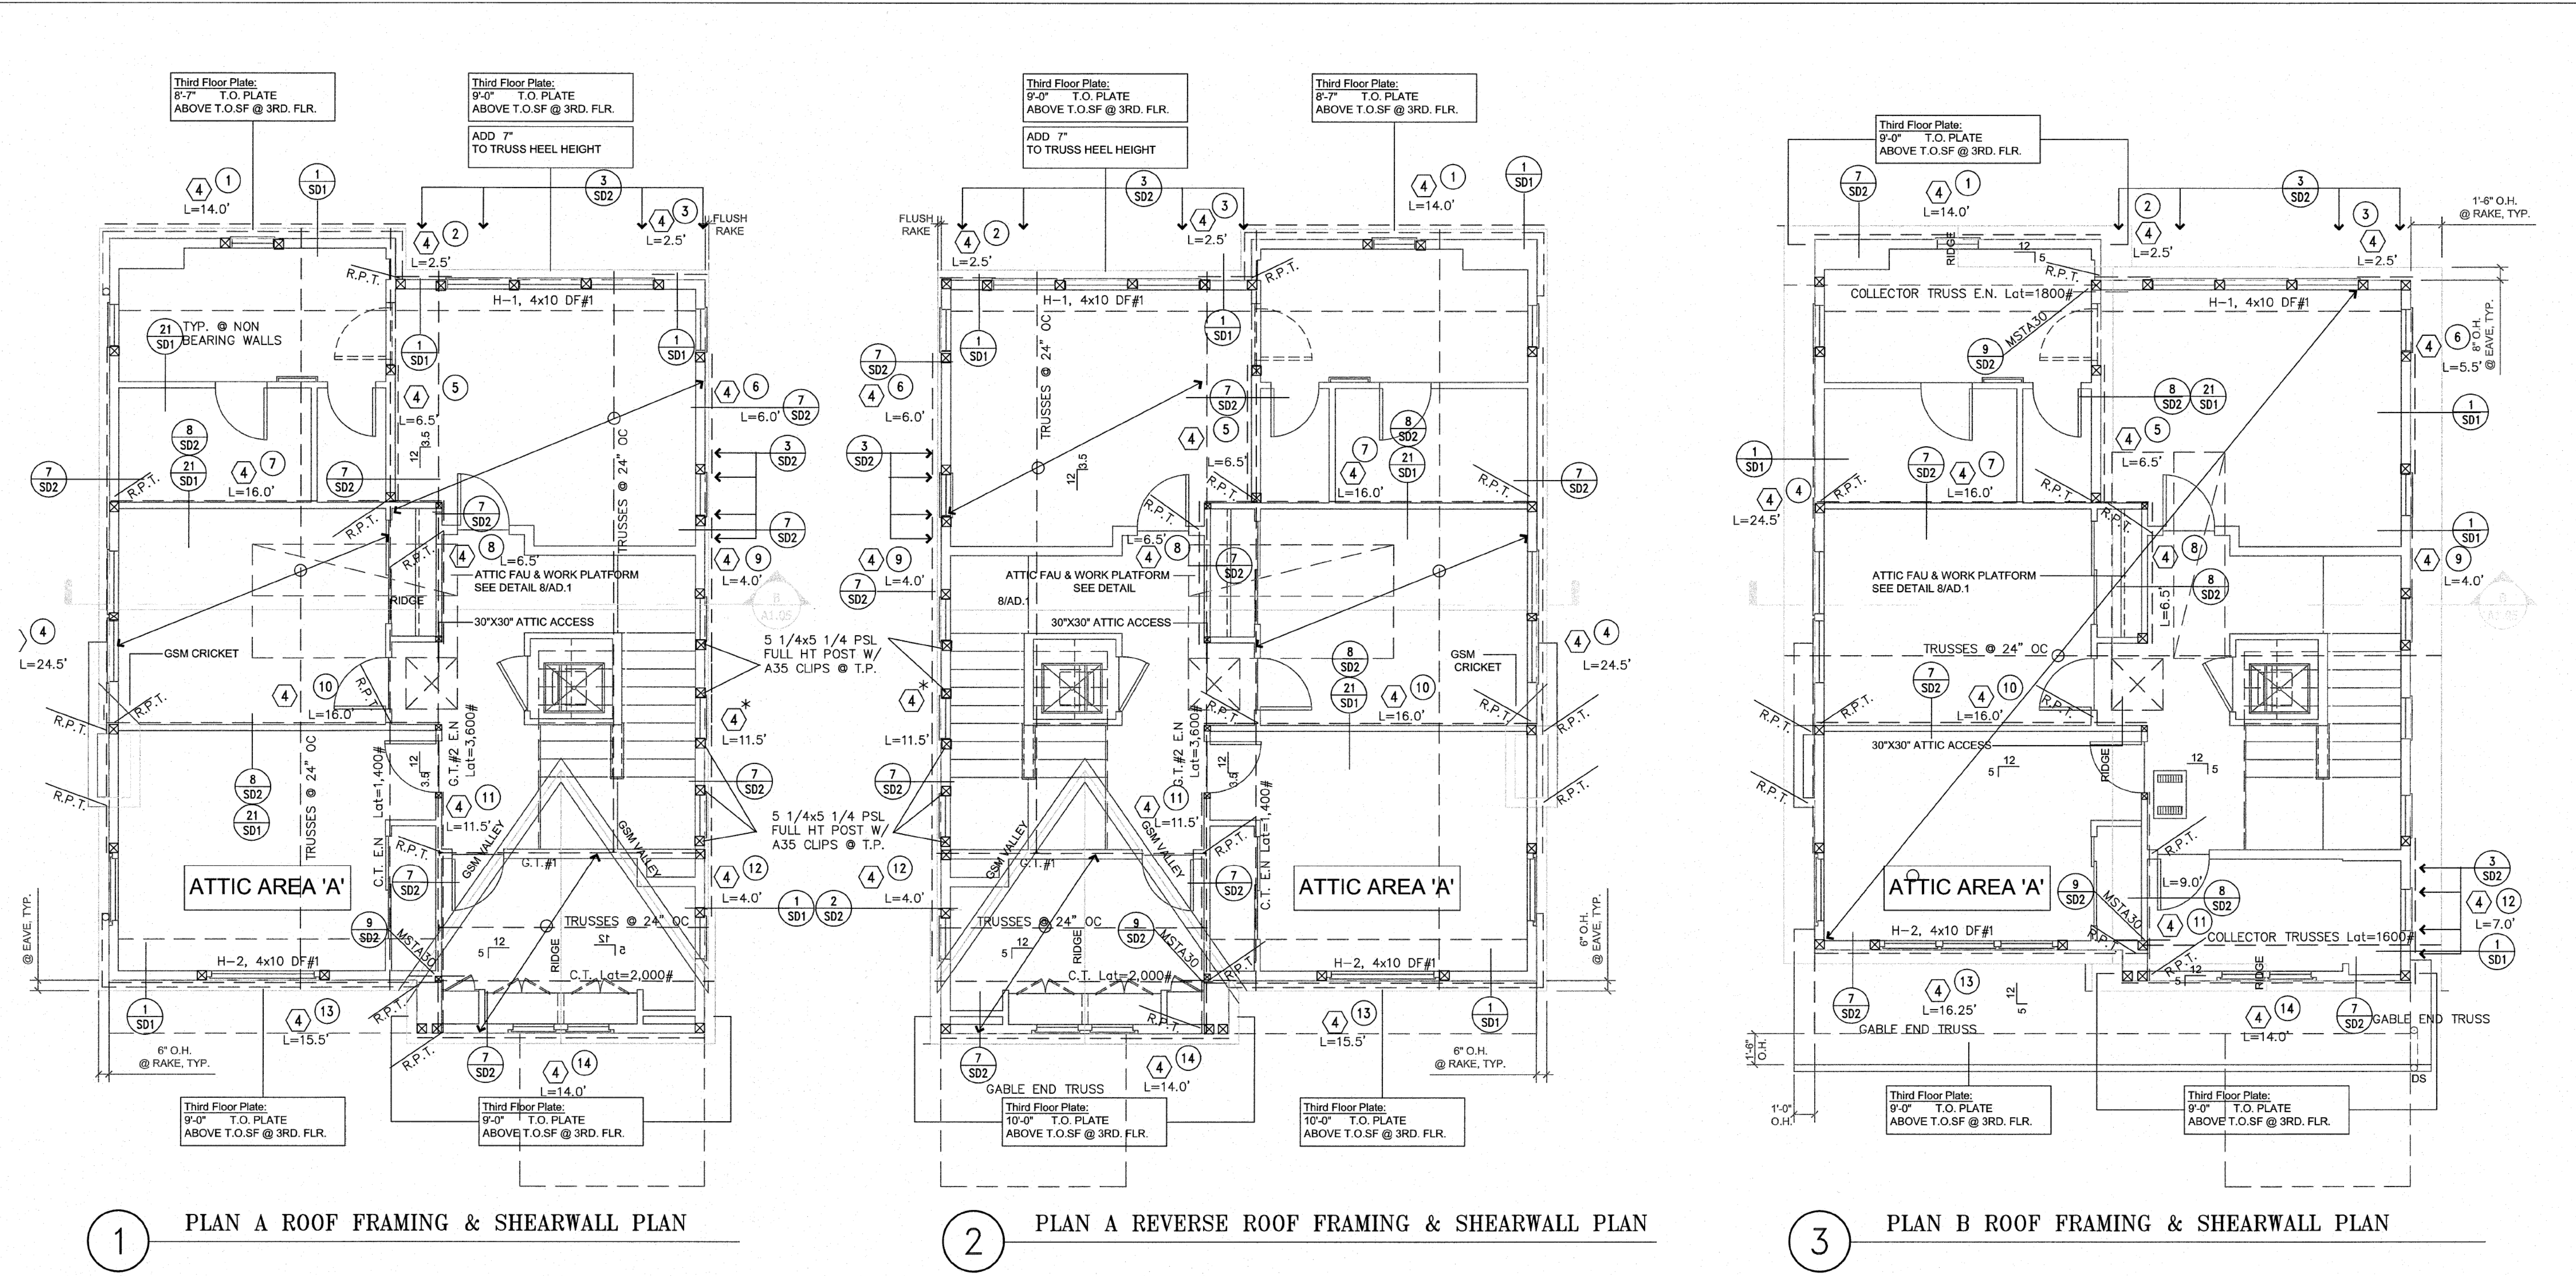

1 PLAN A ROOF FRAMING & SHEARWALL PLAN

2 PLAN A REVERSE ROOF FRAMING & SHEARWALL PLAN

3 PLAN B ROOF FRAMING & SHEARWALL PLAN

- ROOF FRAMING NOTES:**
1. PRE-FABRICATED TRUSSES TO BE DESIGNED BY THE TRUSS MANUFACTURER.
 2. SEE PRE-FABRICATED TRUSS GENERAL NOTES FOR MANUFACTURED ROOF TRUSSES.
 3. HEADERS - 4x8 DF#1 (TYPICAL U.O.N.)
 4. FULL HT. STUDS @ STAIRWELL - (2) 1.5x5.5 LSL'S @ 12" OC MAX. B/LKG PER PLAN.
 5. FULL HT. WOOD POSTS @ STAIRWELL - 1.5x5.5 PSL - B/LKG PER PLAN.
 6. CONTINUE ALL POSTS TO FOUNDATION, U.O.N.
 7. SPLICE ALL DISCONTINUOUS TOP PLATES WITH MSTA30 STRAP. REFERENCE DETAIL U.S.S-2 FOR TOP PLATE SPLICES. REFERENCE DETAIL 2SD-1 FOR TYPICAL TOP PLATE SPLICE @ BEAM.
 8. CONTRACTOR TO VERIFY ALL DIMENSIONS WITH ARCHITECTURAL PLANS. ARCHITECTURAL PLAN DIMENSIONS SHALL SUPERSEDE STRUCTURAL PLAN DIMENSIONS. CONTACT ENGINEER WITH ANY DISCREPANCIES.
 9. ROOF DIAPHRAGM - 1/2" CDX PLYWOOD OR 1/2" OSB FRP-108 W/16" NAILS @ 4" O.C. EDGE, 12" O.C. FIELD. CASE 1 PLYWOOD LAYOUT, UNLOCKED, U.O.N.
 10. REFERENCE SHEET SN & SD-1 FOR STRUCTURAL NOTES AND SHEAR TRANSFER INFORMATION.
 11. ALL EXTERIOR WALLS ARE 2X8 DF#2 @16" OC. (U.O.N.) ALL INTERIOR WALLS ARE 2X4 DF#2 @16" OC. (U.O.N.)


- ROOF FRAMING LEGEND:**
- ☒ 4x8 DF #1 POST TO BELOW, U.O.N.
 - SHEAR WALL (S.W.)
 - ☒ SHEAR WALL TYPE - NOT PART OF STRUCTURAL CALC.
 - ☒ SHEARWALL TYPE (REF. SW SCHEDULE, SHEET SN)
 - ☒ SHEAR WALL I. D. NUMBER
 - L= SHEAR WALL LENGTH

- R.P.T. RUN PLYWOOD THROUGH GIRDER TRUSS
 G.T. GIRDER TRUSS
 C.T. COLLECTOR TRUSS
 LATERAL LOAD ON C.T.
 E.N. EDGE NAIL ROOF PLY FULL LENGTH FRAMING MEMBER
 D.S. DRAG STRUT
 U.O.N. UNLESS OTHERWISE NOTED
 O.C. ON CENTER

ROOF TILE WEIGHT TO 8 PSF MAX

STRUCTURAL PLANS

3/15/16
1/4"=1'-0"
PAT
15-031
15-031-54

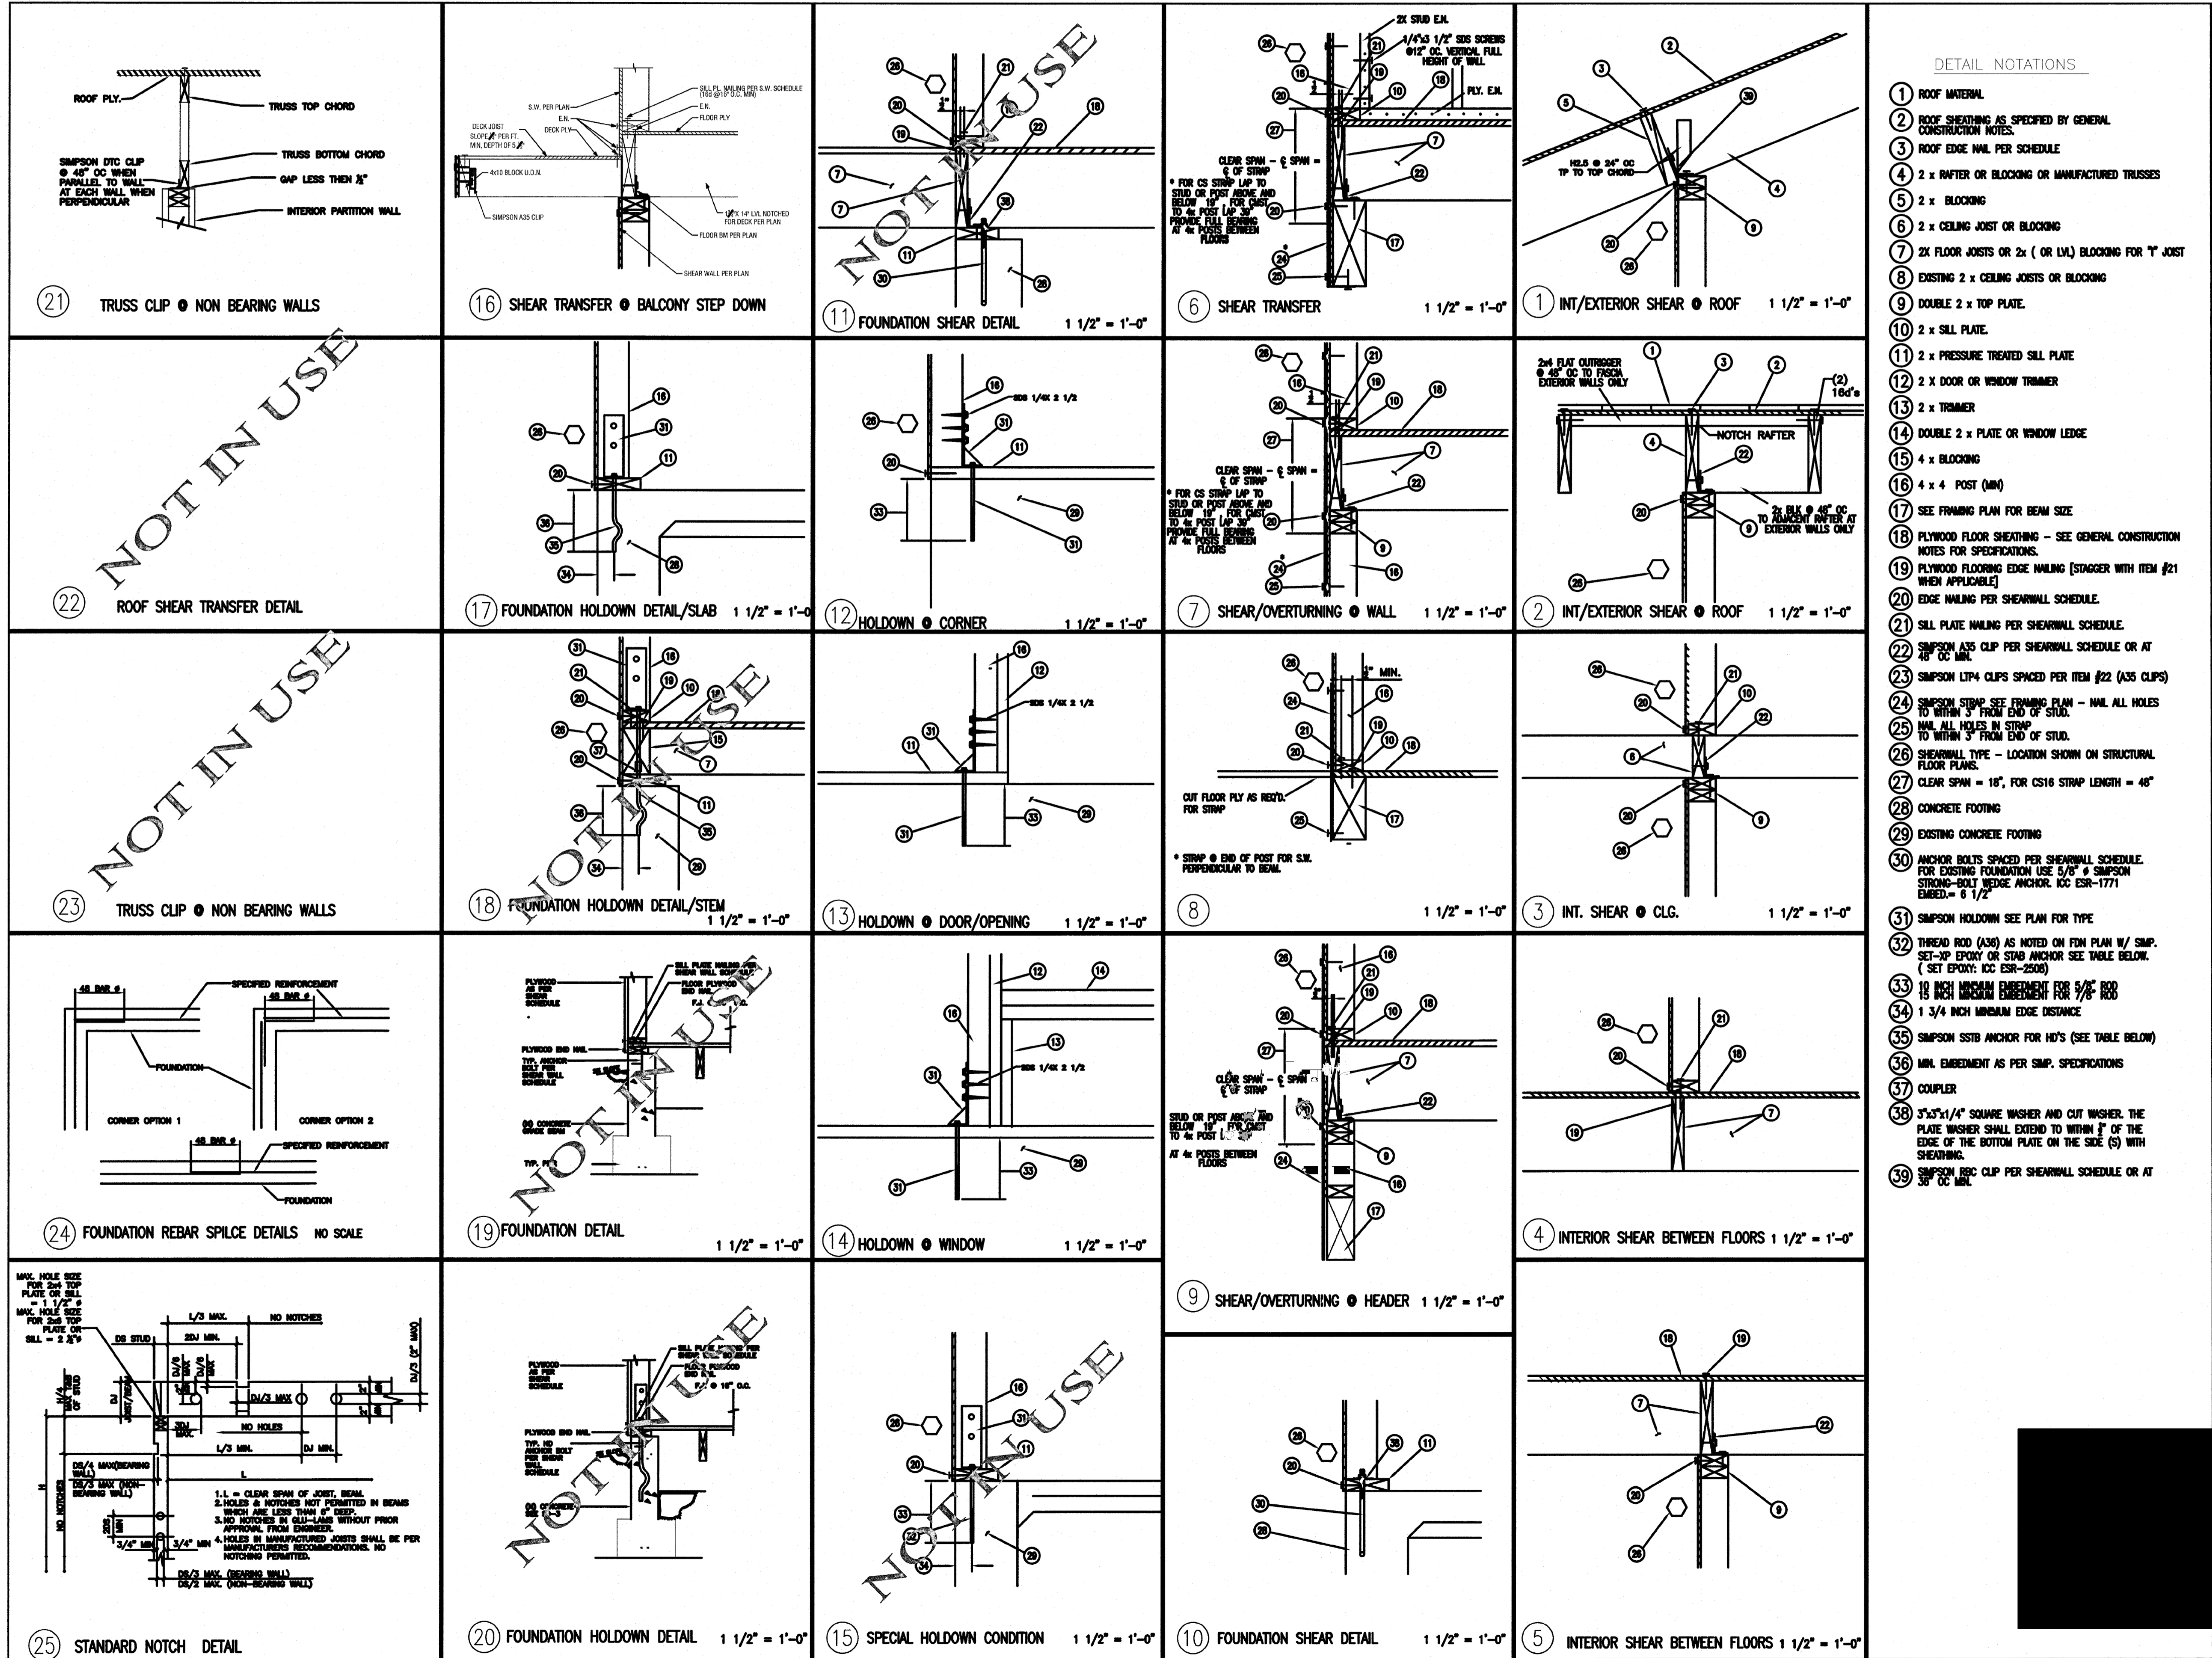


DETAIL NOTATIONS

- 1 ROOF MATERIAL
- 2 ROOF SHEATHING AS SPECIFIED BY GENERAL CONSTRUCTION NOTES
- 3 ROOF EDGE NAIL PER SCHEDULE
- 4 2 x RAFTER OR BLOCKING OR MANUFACTURED TRUSSES
- 5 2 x BLOCKING
- 6 2 x CEILING JOIST OR BLOCKING
- 7 2x FLOOR JOISTS OR 2x (OR LVL) BLOCKING FOR 1" JOIST
- 8 EXISTING 2 x CEILING JOISTS OR BLOCKING
- 9 DOUBLE 2 x TOP PLATE
- 10 2 x SILL PLATE
- 11 2 x PRESSURE TREATED SILL PLATE
- 12 2 x DOOR OR WINDOW TRIMMER
- 13 2 x TRIMMER
- 14 DOUBLE 2 x PLATE OR WINDOW LEDGE
- 15 4 x BLOCKING
- 16 4 x 4 POST (MIN)
- 17 SEE FRAMING PLAN FOR BEAM SIZE
- 18 PLYWOOD FLOOR SHEATHING - SEE GENERAL CONSTRUCTION NOTES FOR SPECIFICATIONS
- 19 PLYWOOD FLOORING EDGE NAILING (STAGGER WITH ITEM #21 WHEN APPLICABLE)
- 20 EDGE NAILING PER SHEARWALL SCHEDULE
- 21 SILL PLATE NAILING PER SHEARWALL SCHEDULE
- 22 SIMPSON A325 CLIP PER SHEARWALL SCHEDULE OR AT 36" OC MIN.
- 23 SIMPSON LTP4 CLIPS SPACED PER ITEM #22 (A325 CLIPS)
- 24 SIMPSON STRAP SEE FRAMING PLAN - MIN. ALL HOLES TO WITHIN 3" FROM END OF STUD.
- 25 MIN. ALL HOLES IN STRAP TO WITHIN 3" FROM END OF STUD.
- 26 SHEARWALL TYPE - LOCATION SHOWN ON STRUCTURAL FLOOR PLANS
- 27 CLEAR SPAN = 18", FOR CS16 STRAP LENGTH = 48"
- 28 CONCRETE FOOTING
- 29 EXISTING CONCRETE FOOTING
- 30 ANCHOR BOLTS SPACED PER SHEARWALL SCHEDULE. FOR EXISTING FOUNDATION USE 5/8" SIMPSON STRAP-BOLT WEDGE ANCHOR. ICC ESR-1771. SIZES = 1 1/2"
- 31 SIMPSON HOLDOWN SEE PLAN FOR TYPE
- 32 THREAD ROD (A36) AS NOTED ON FEM PLAN W/ SIMP. SET-UP EPOXY OR STAB ANCHOR SEE TABLE BELOW. (SET EPOXY: ICC ESR-2508)
- 33 18 INCH MINIMUM EMBEDMENT FOR 5/8" ROD
- 34 1 3/4 INCH MINIMUM EDGE DISTANCE
- 35 SIMPSON S518 ANCHOR FOR HD'S (SEE TABLE BELOW)
- 36 MIN. EMBEDMENT AS PER SIMP. SPECIFICATIONS
- 37 COUPLER
- 38 3"x3"x1/4" SQUARE WASHER AND CUT WASHER. THE PLATE WASHER SHALL EXTEND TO WITHIN 1" OF THE EDGE OF THE BOTTOM PLATE ON THE SIDE (S) WITH SHEATHING.
- 39 SIMPSON BEC CLIP PER SHEARWALL SCHEDULE OR AT 36" OC MIN.


NO.	REVISIONS

TRANSFER DETAILS
STANDARD SHEARWALL
AND MISC DETAILS


Title:

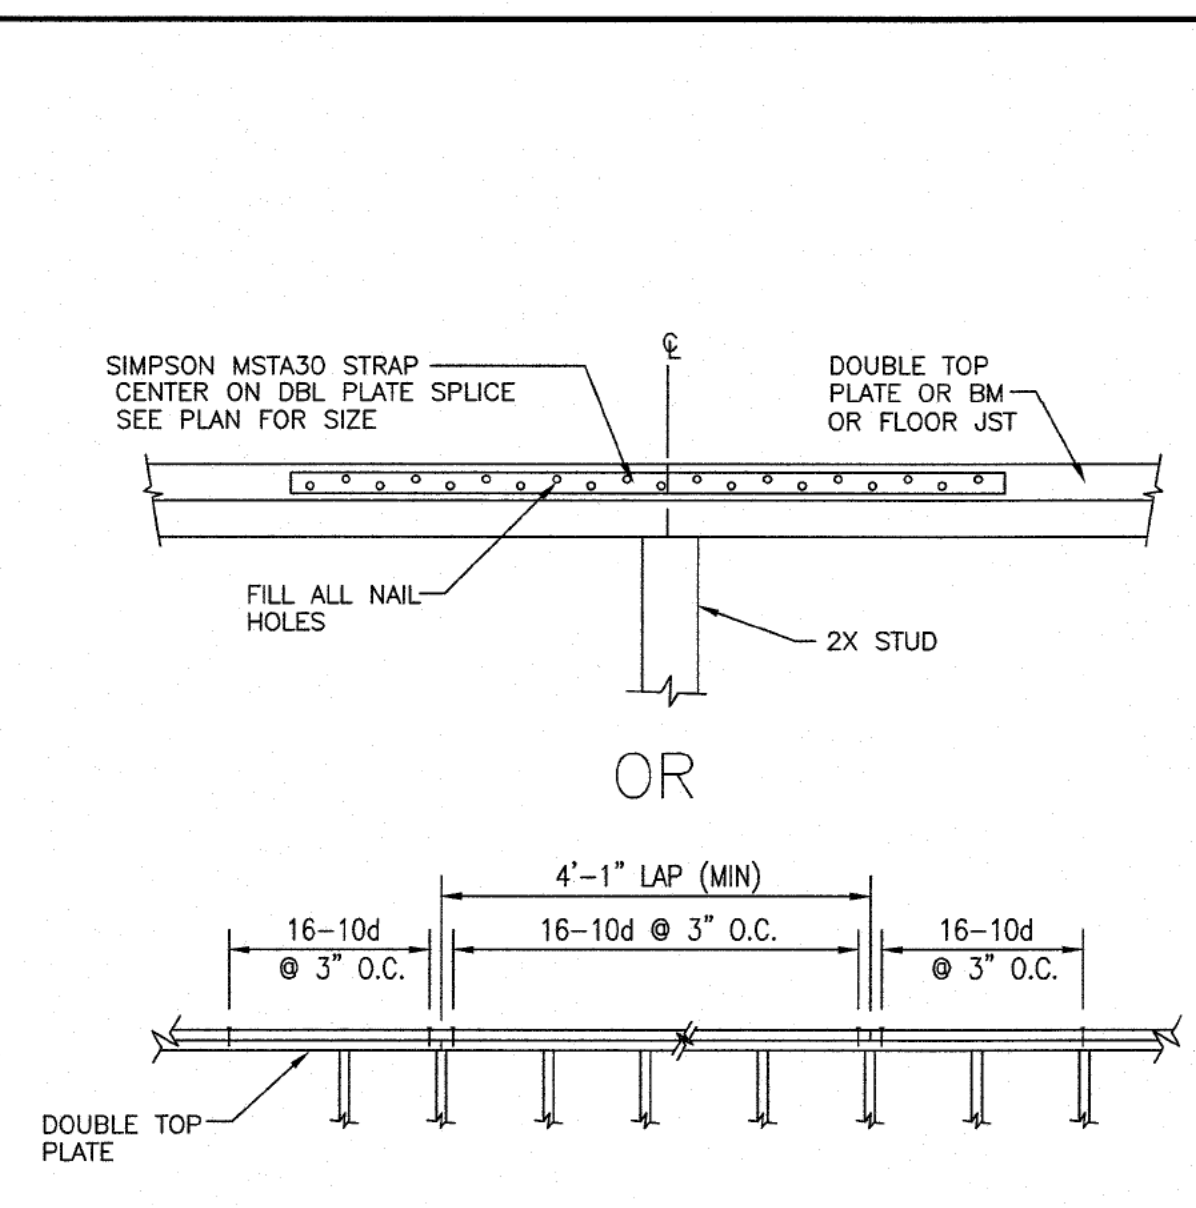


SPlice DETAIL OPTION ①
SCALE: N.T.S.

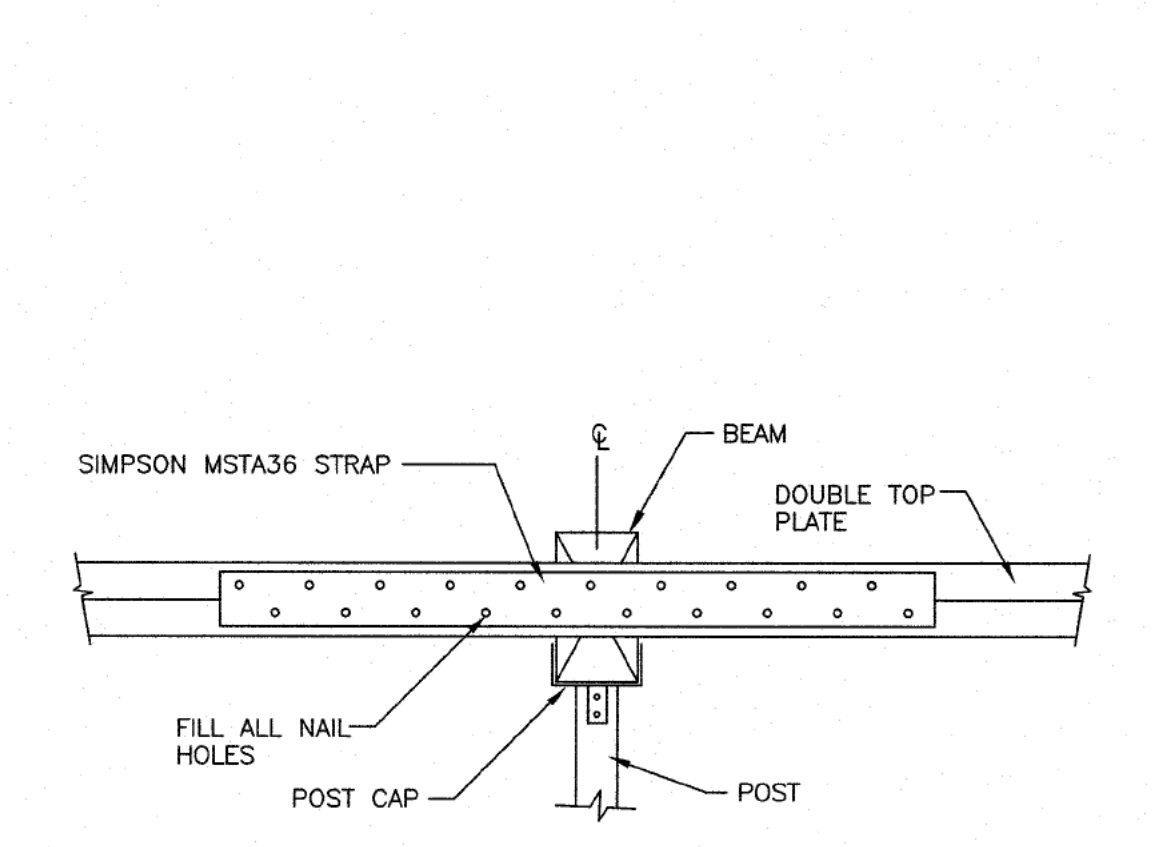


TYPICAL BEAM @ TOP PLATE ②
SCALE: N.T.S.

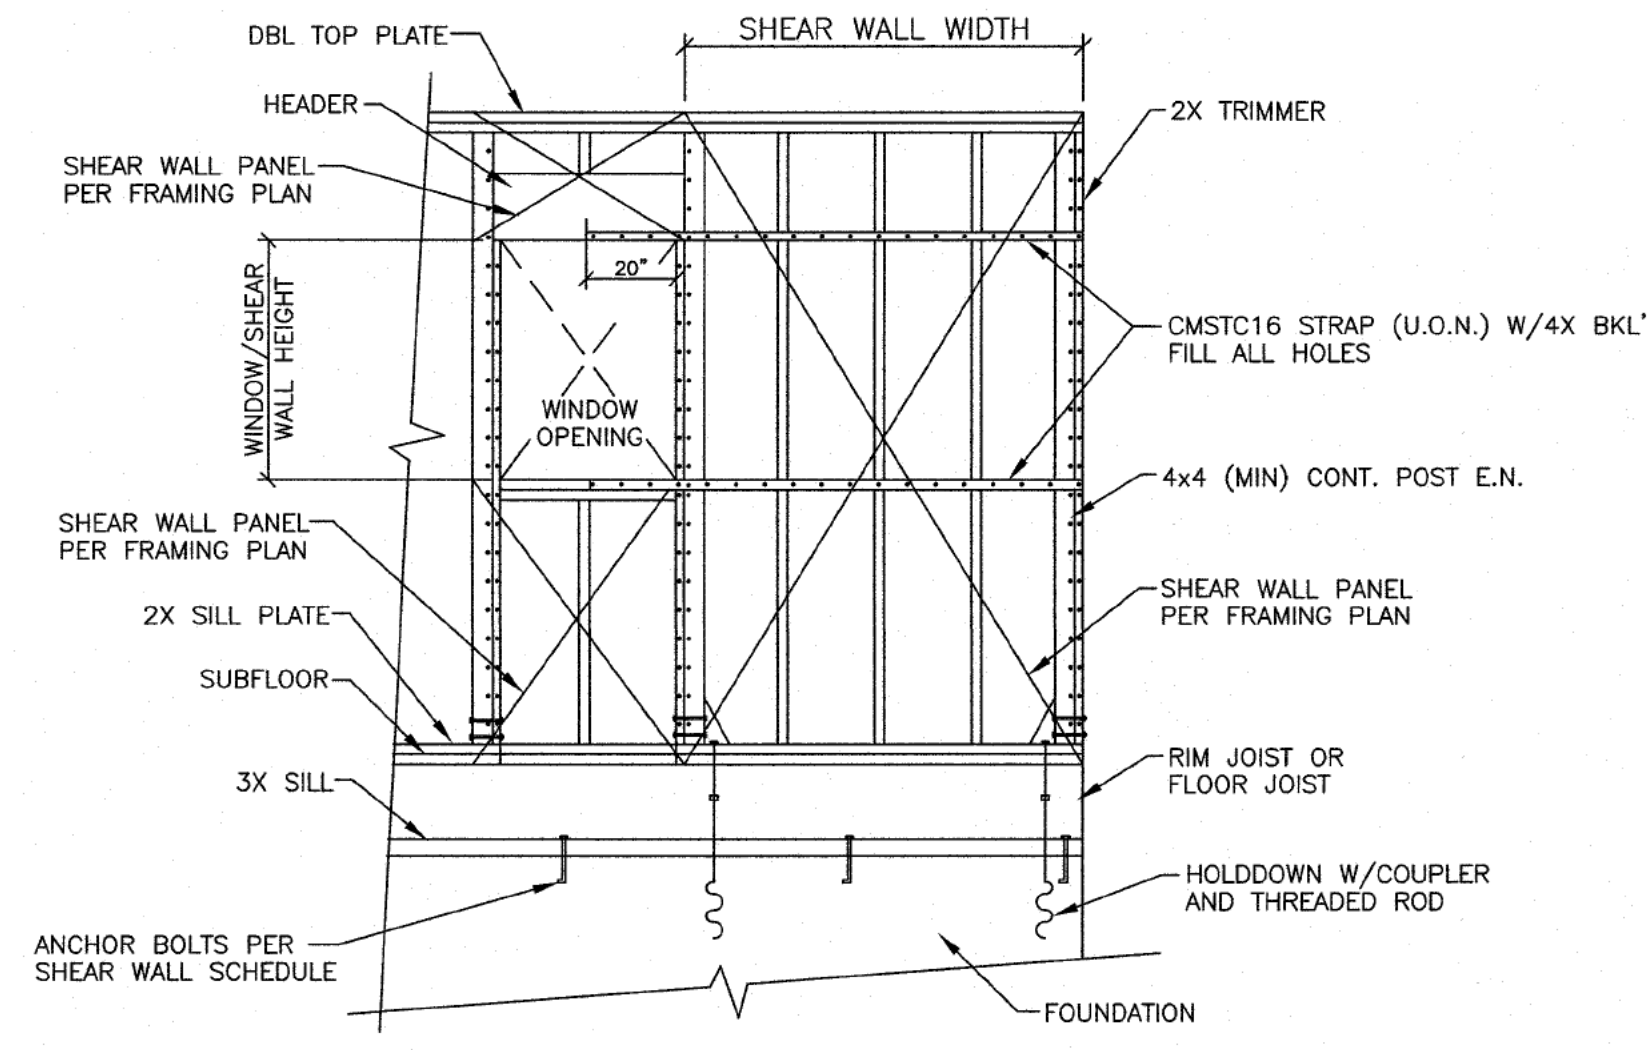


SHEAR WALL AND STRAP @ WINDOWS OPENING ③
SCALE: N.T.S.

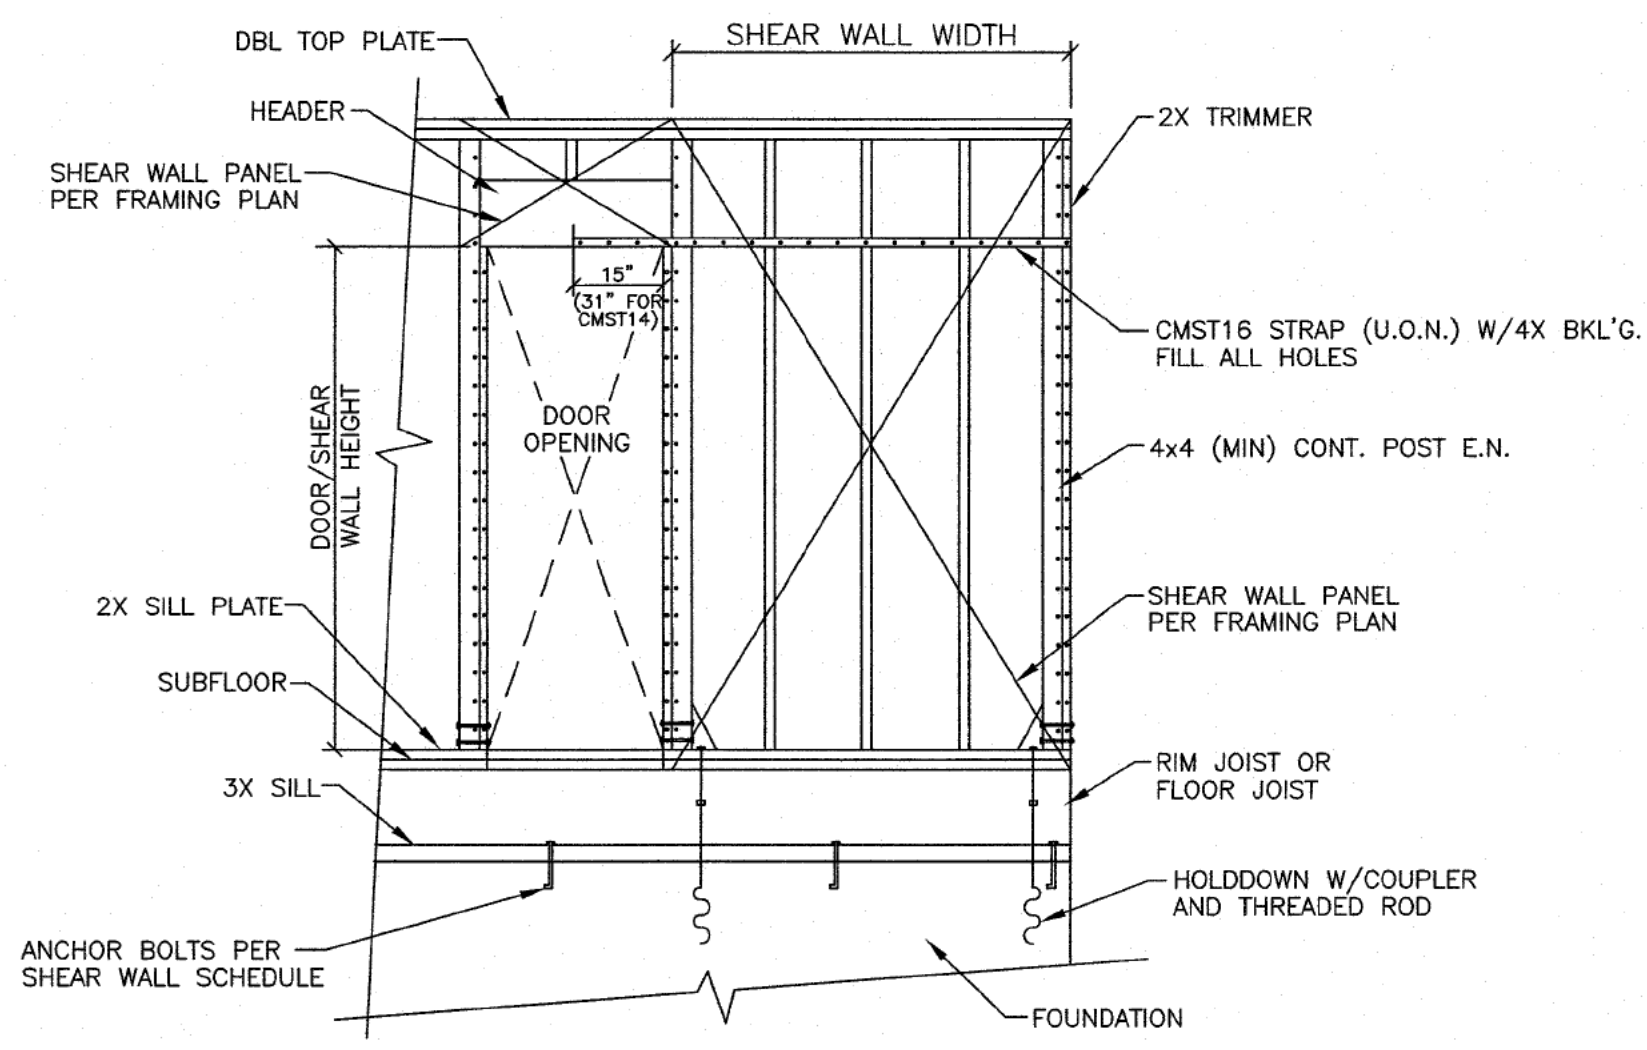


SHEAR WALL AND STRAP @ DOOR OPENING ④
SCALE: N.T.S.

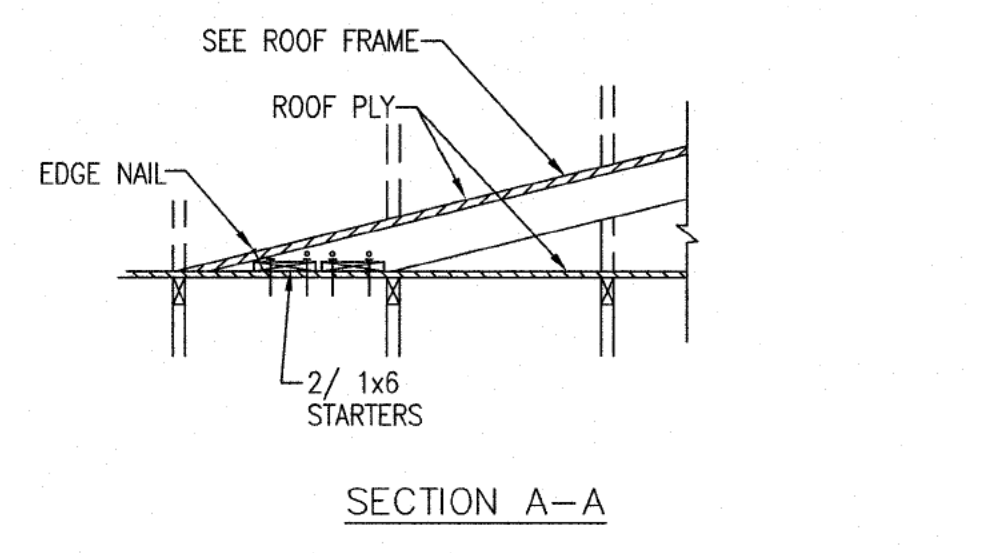


"CALIFORNIA" ROOF TIE-IN ⑤
SCALE: N.T.S.

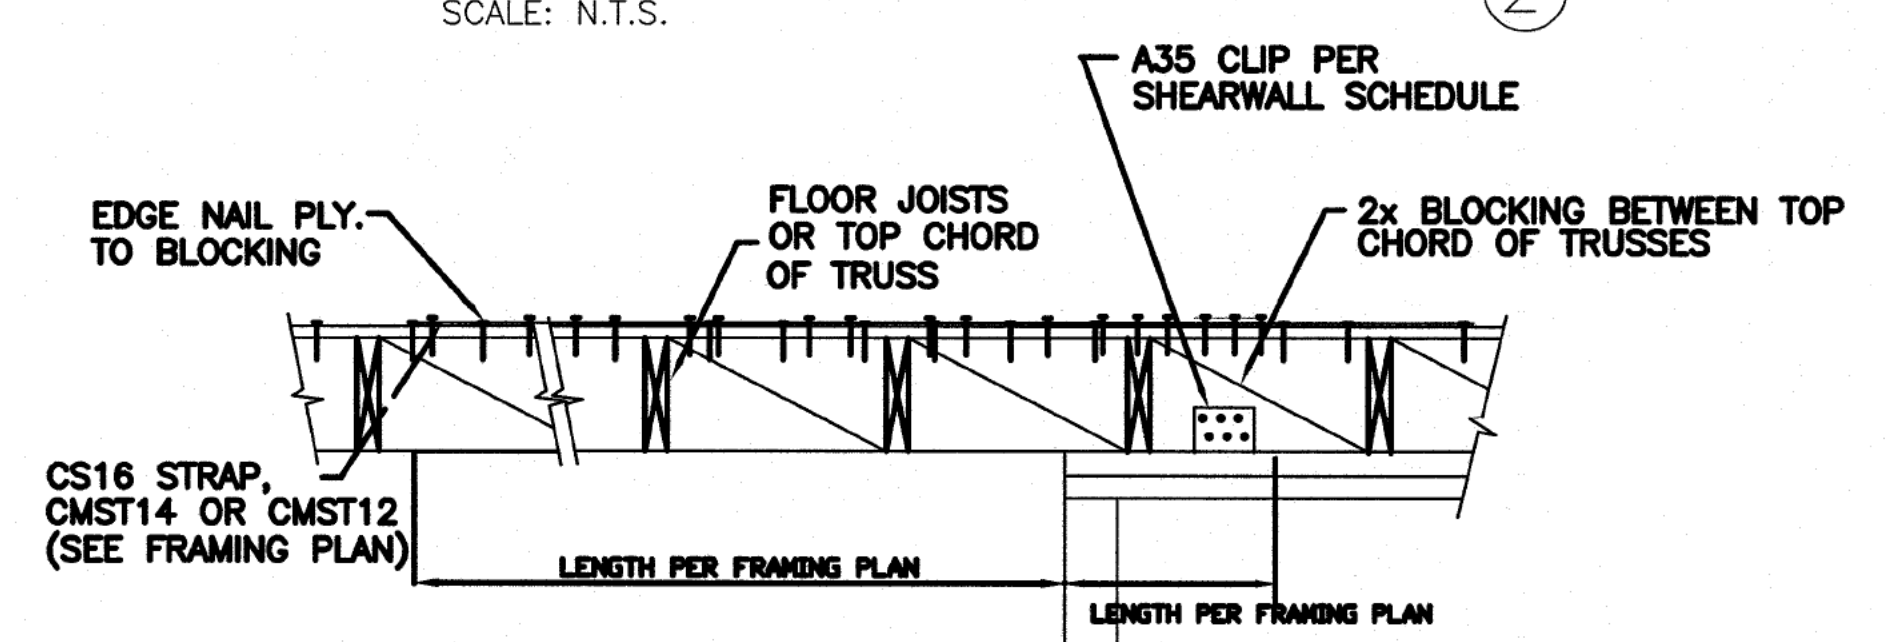


DRAG STRUT DETAIL (SHEARWALL PERPENDICULAR TO RAFTERS OR FLOOR JOISTS) ⑥
SCALE: N.T.S.

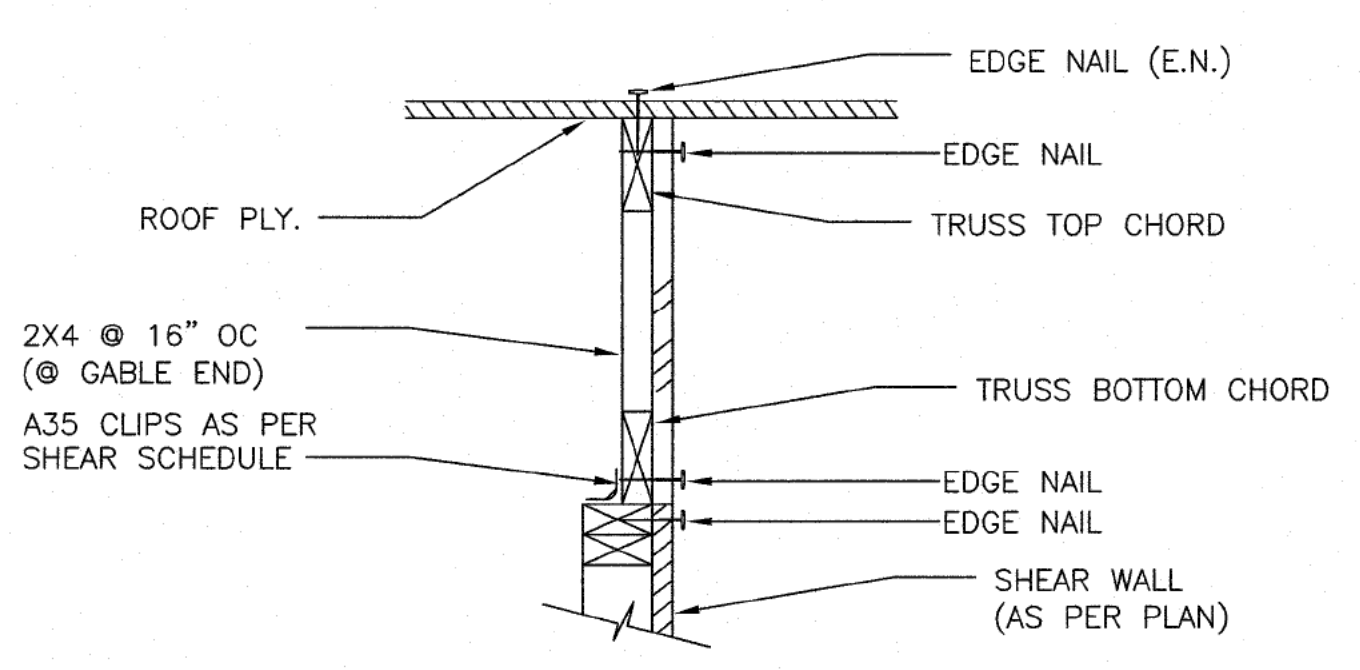


SHEAR TRANSFER ROOF TO WALL ⑦
SCALE: N.T.S.

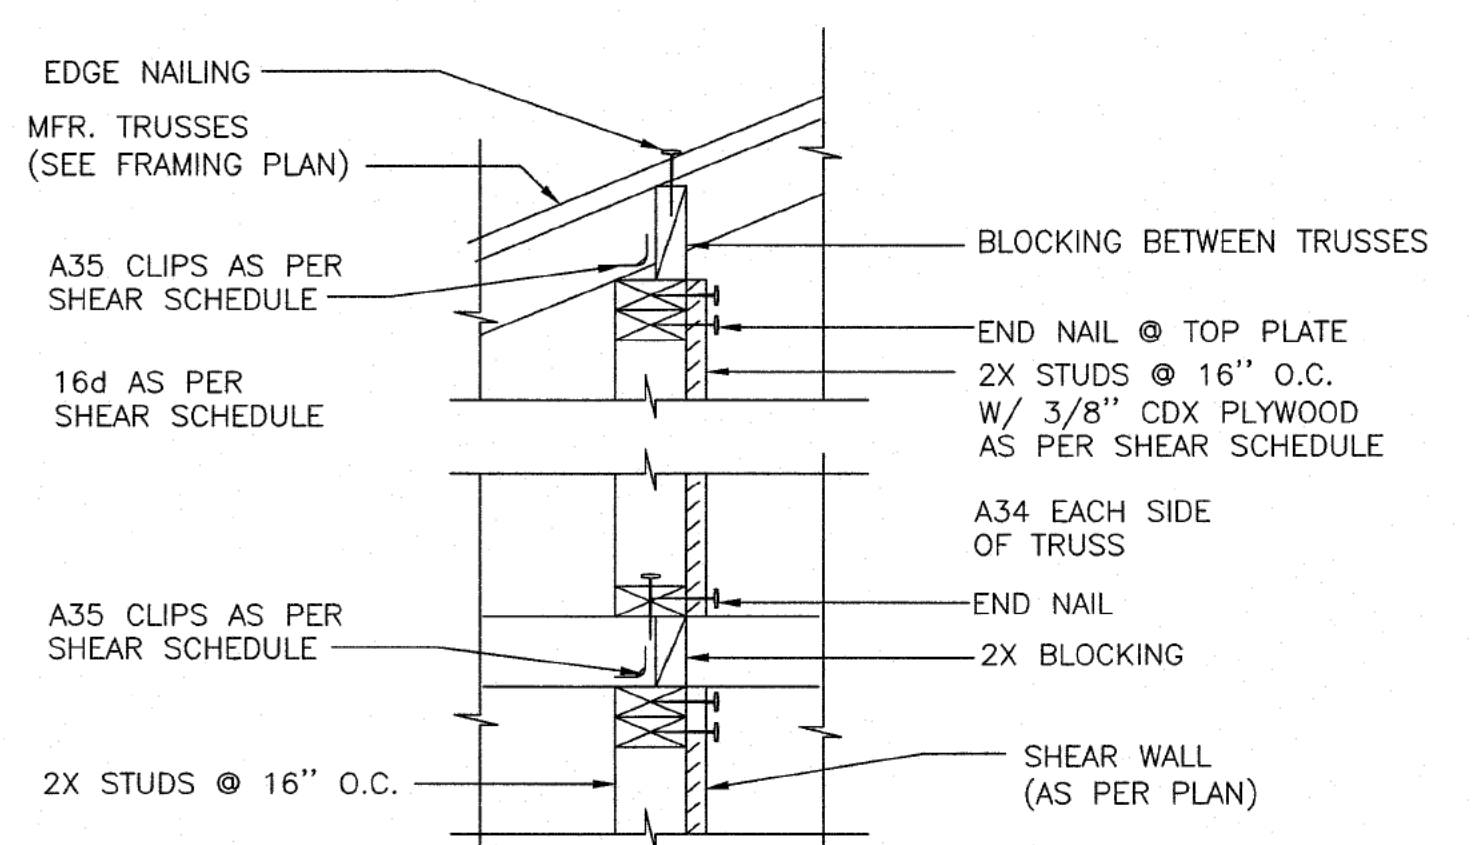


SHEARWALL PERPENDICULAR TO TRUSS ⑧
SCALE: N.T.S.

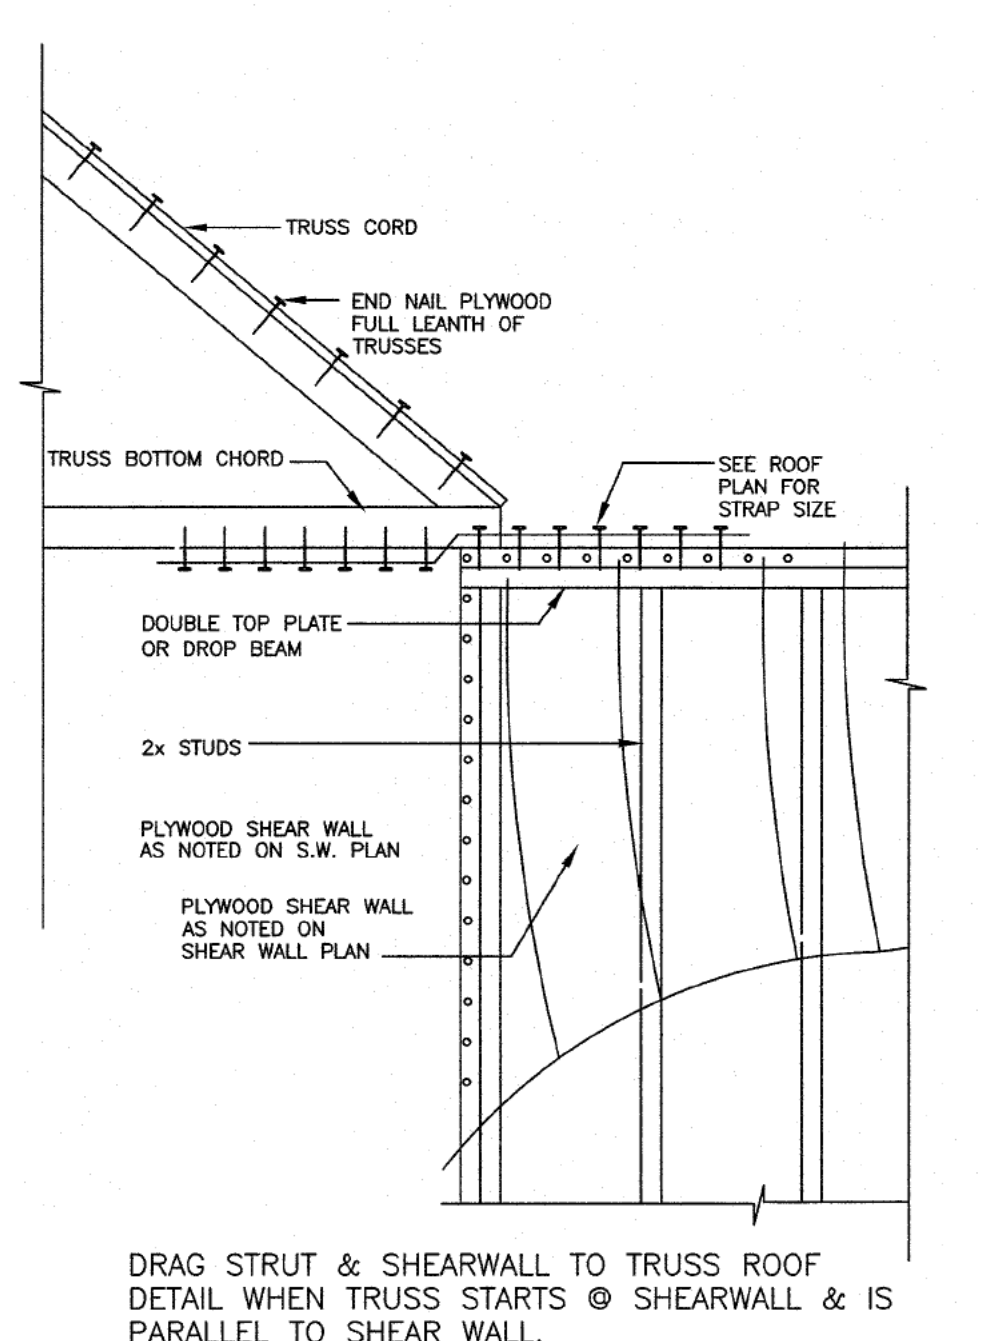


DRAG STRUT AND SHEARWALL TO TRUSS ROOF DETAIL ⑨
SCALE: N.T.S.

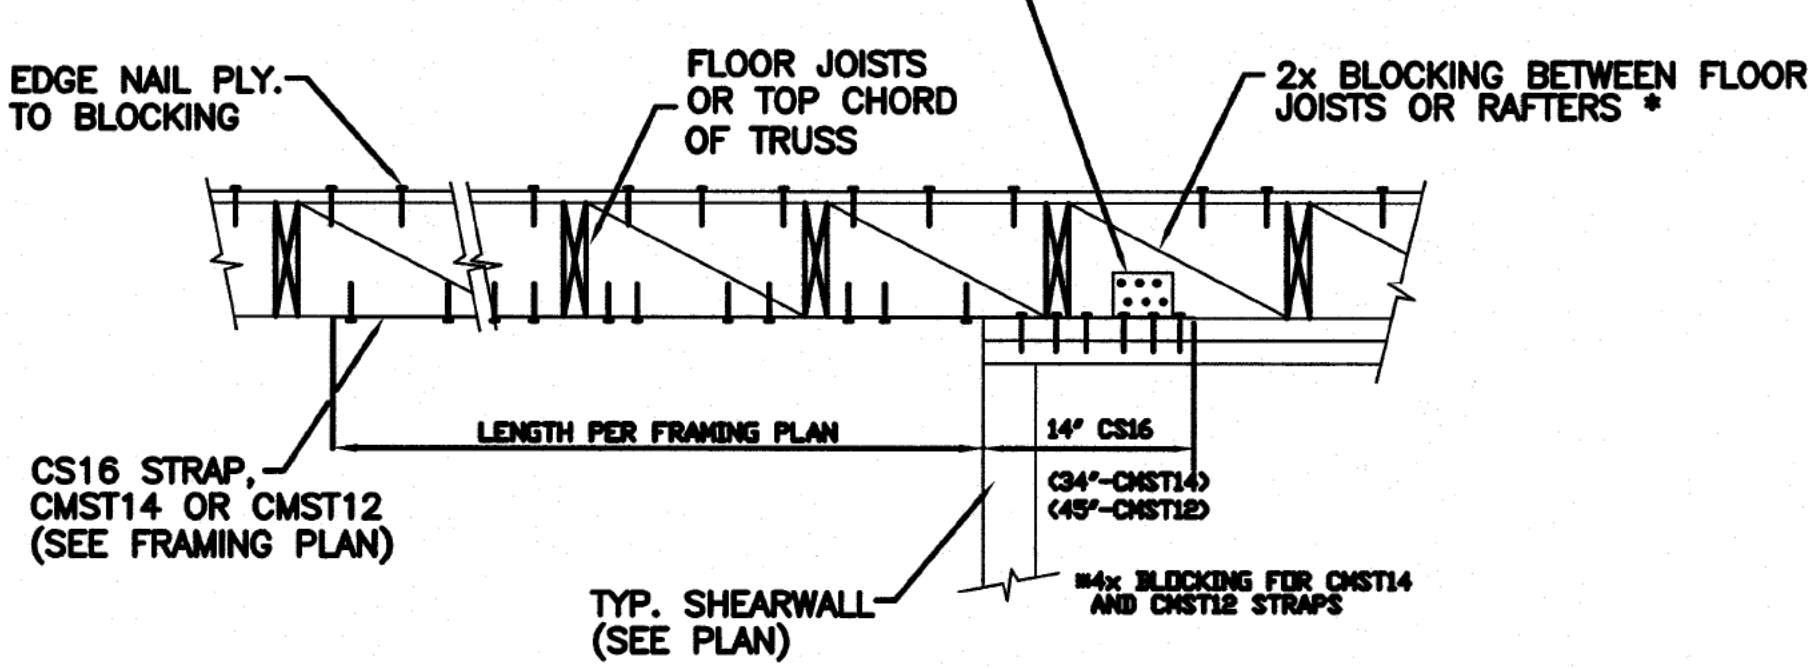

WALL FRAMING DETAIL ⑩
SCALE: N.T.S.

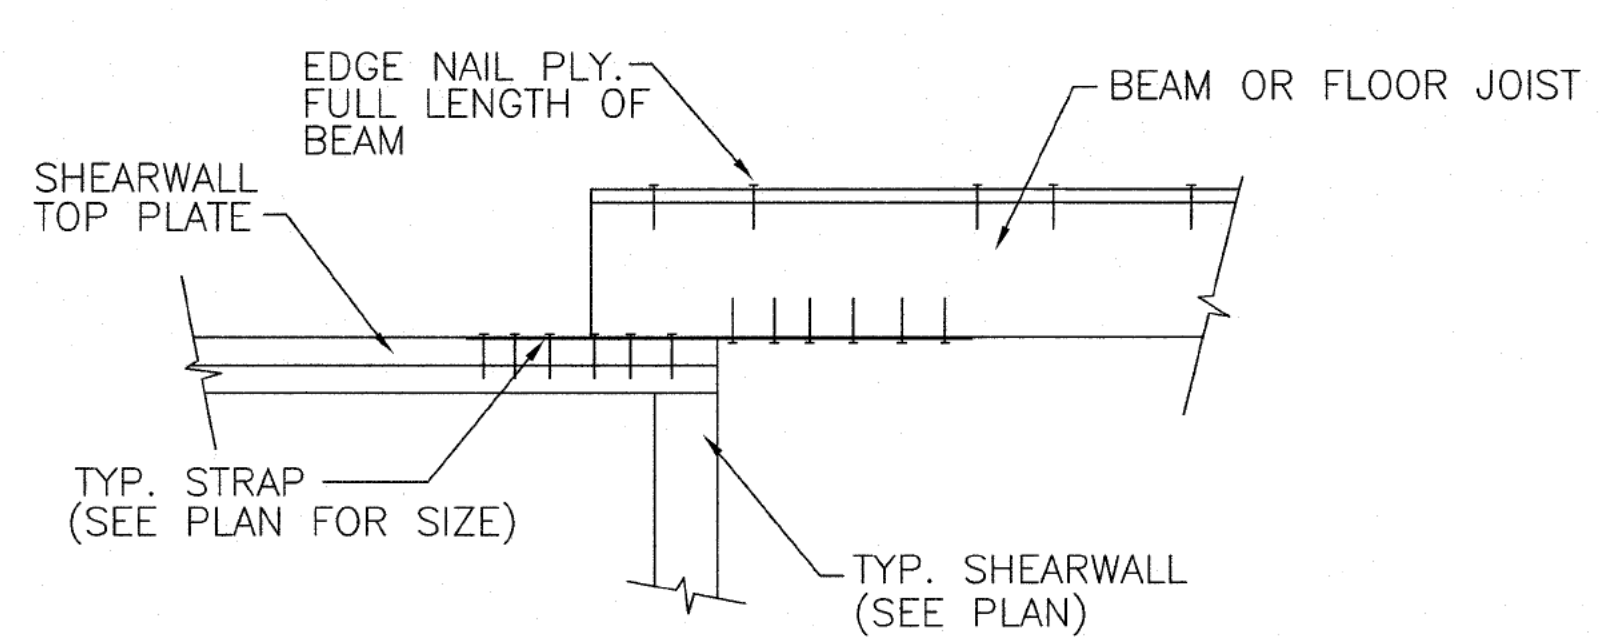

DRAG STRUT DETAIL (SHEARWALL PARALLEL TO BEAM) ⑪

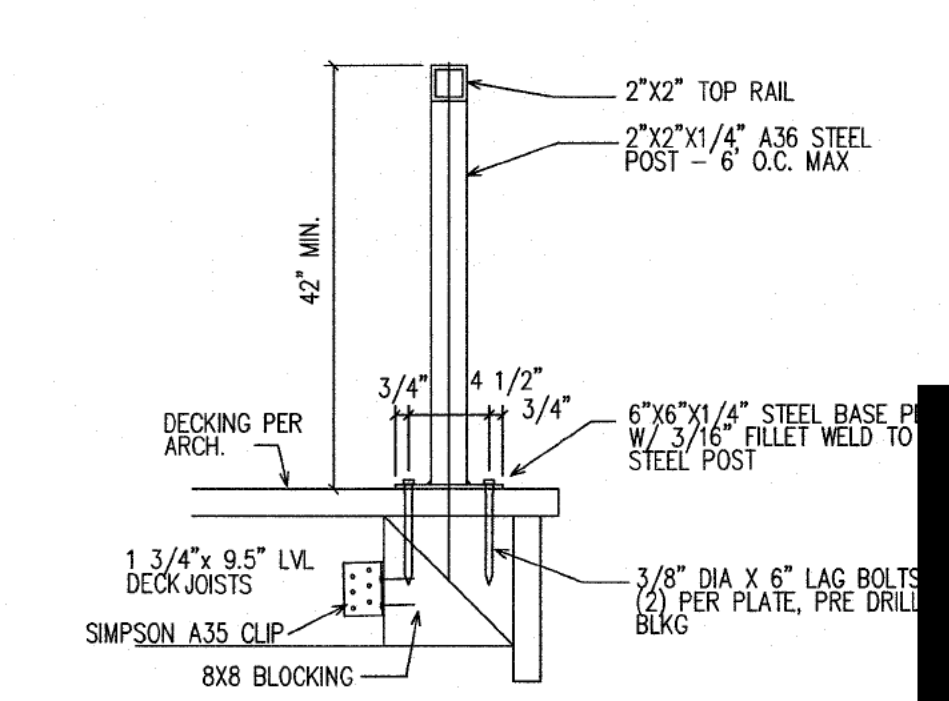






METAL RAILING POST ⑫
SCALE: NO

NO.	REVISIONS

FRAMING DETAILS

Title:

Date: 4/15/16
Scale: AS NOTED
Drawn:
Job: 16-031
CAD File: 16-031-SD2
Sheet: SD2

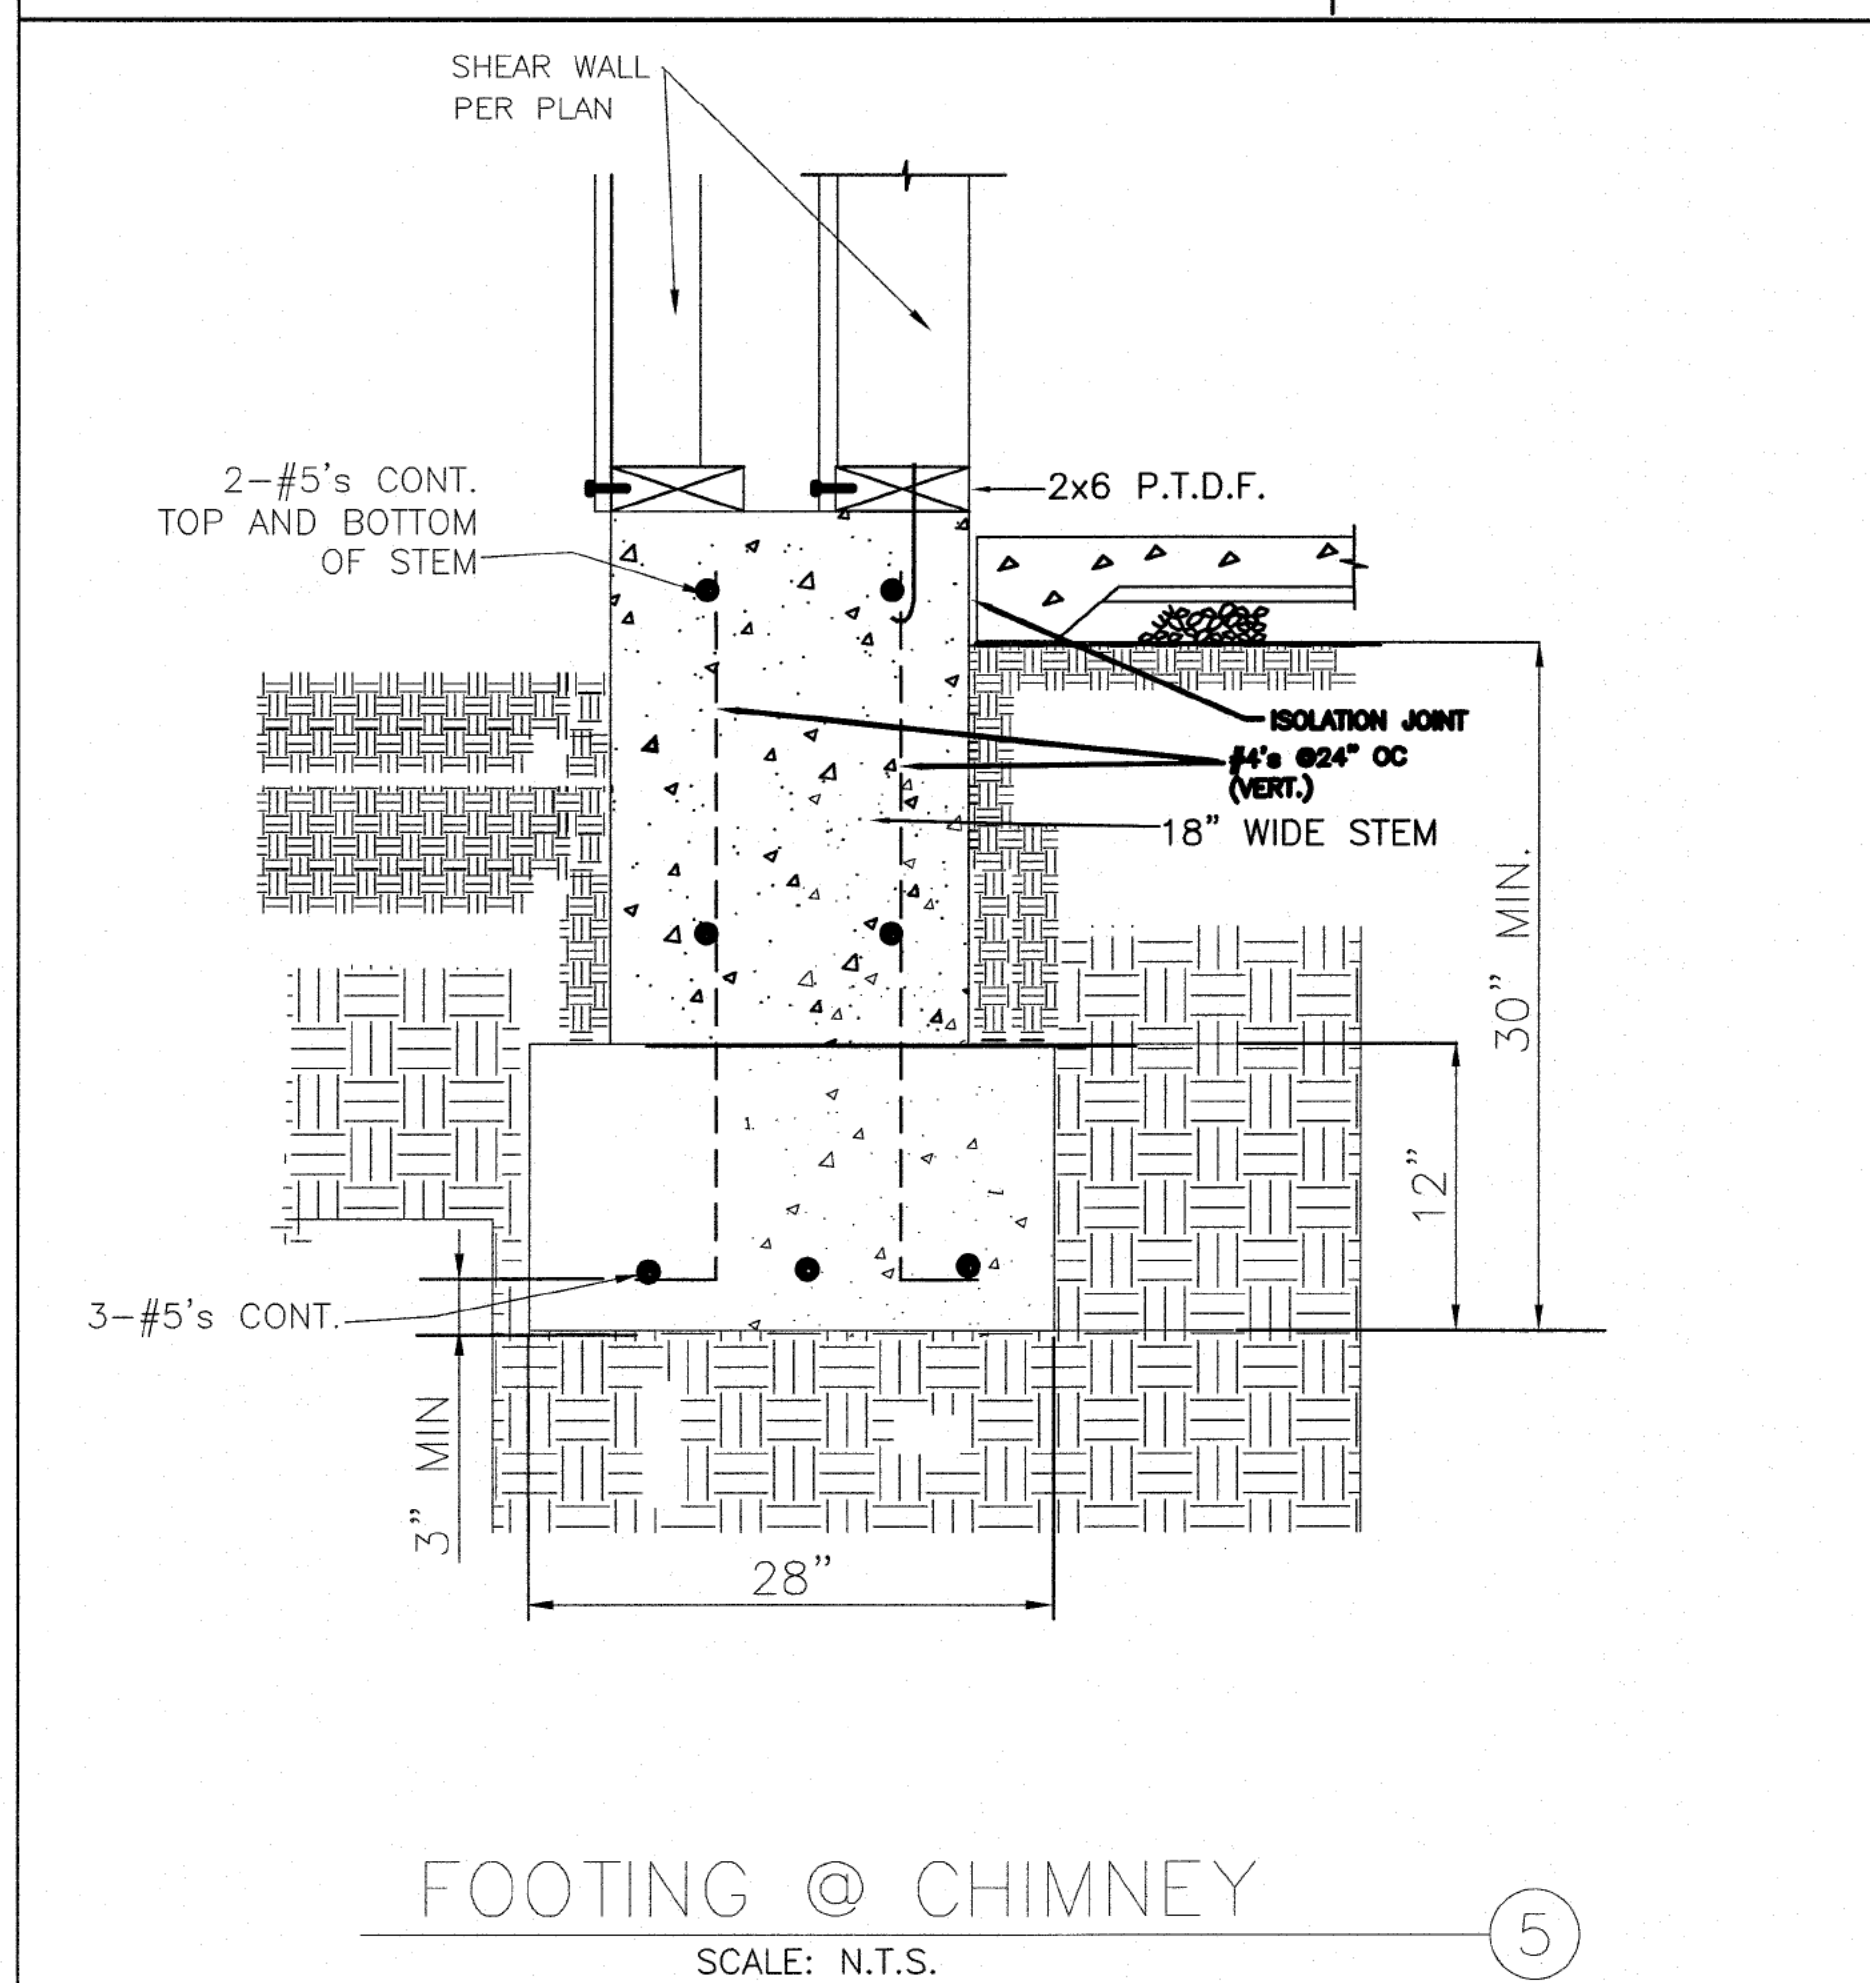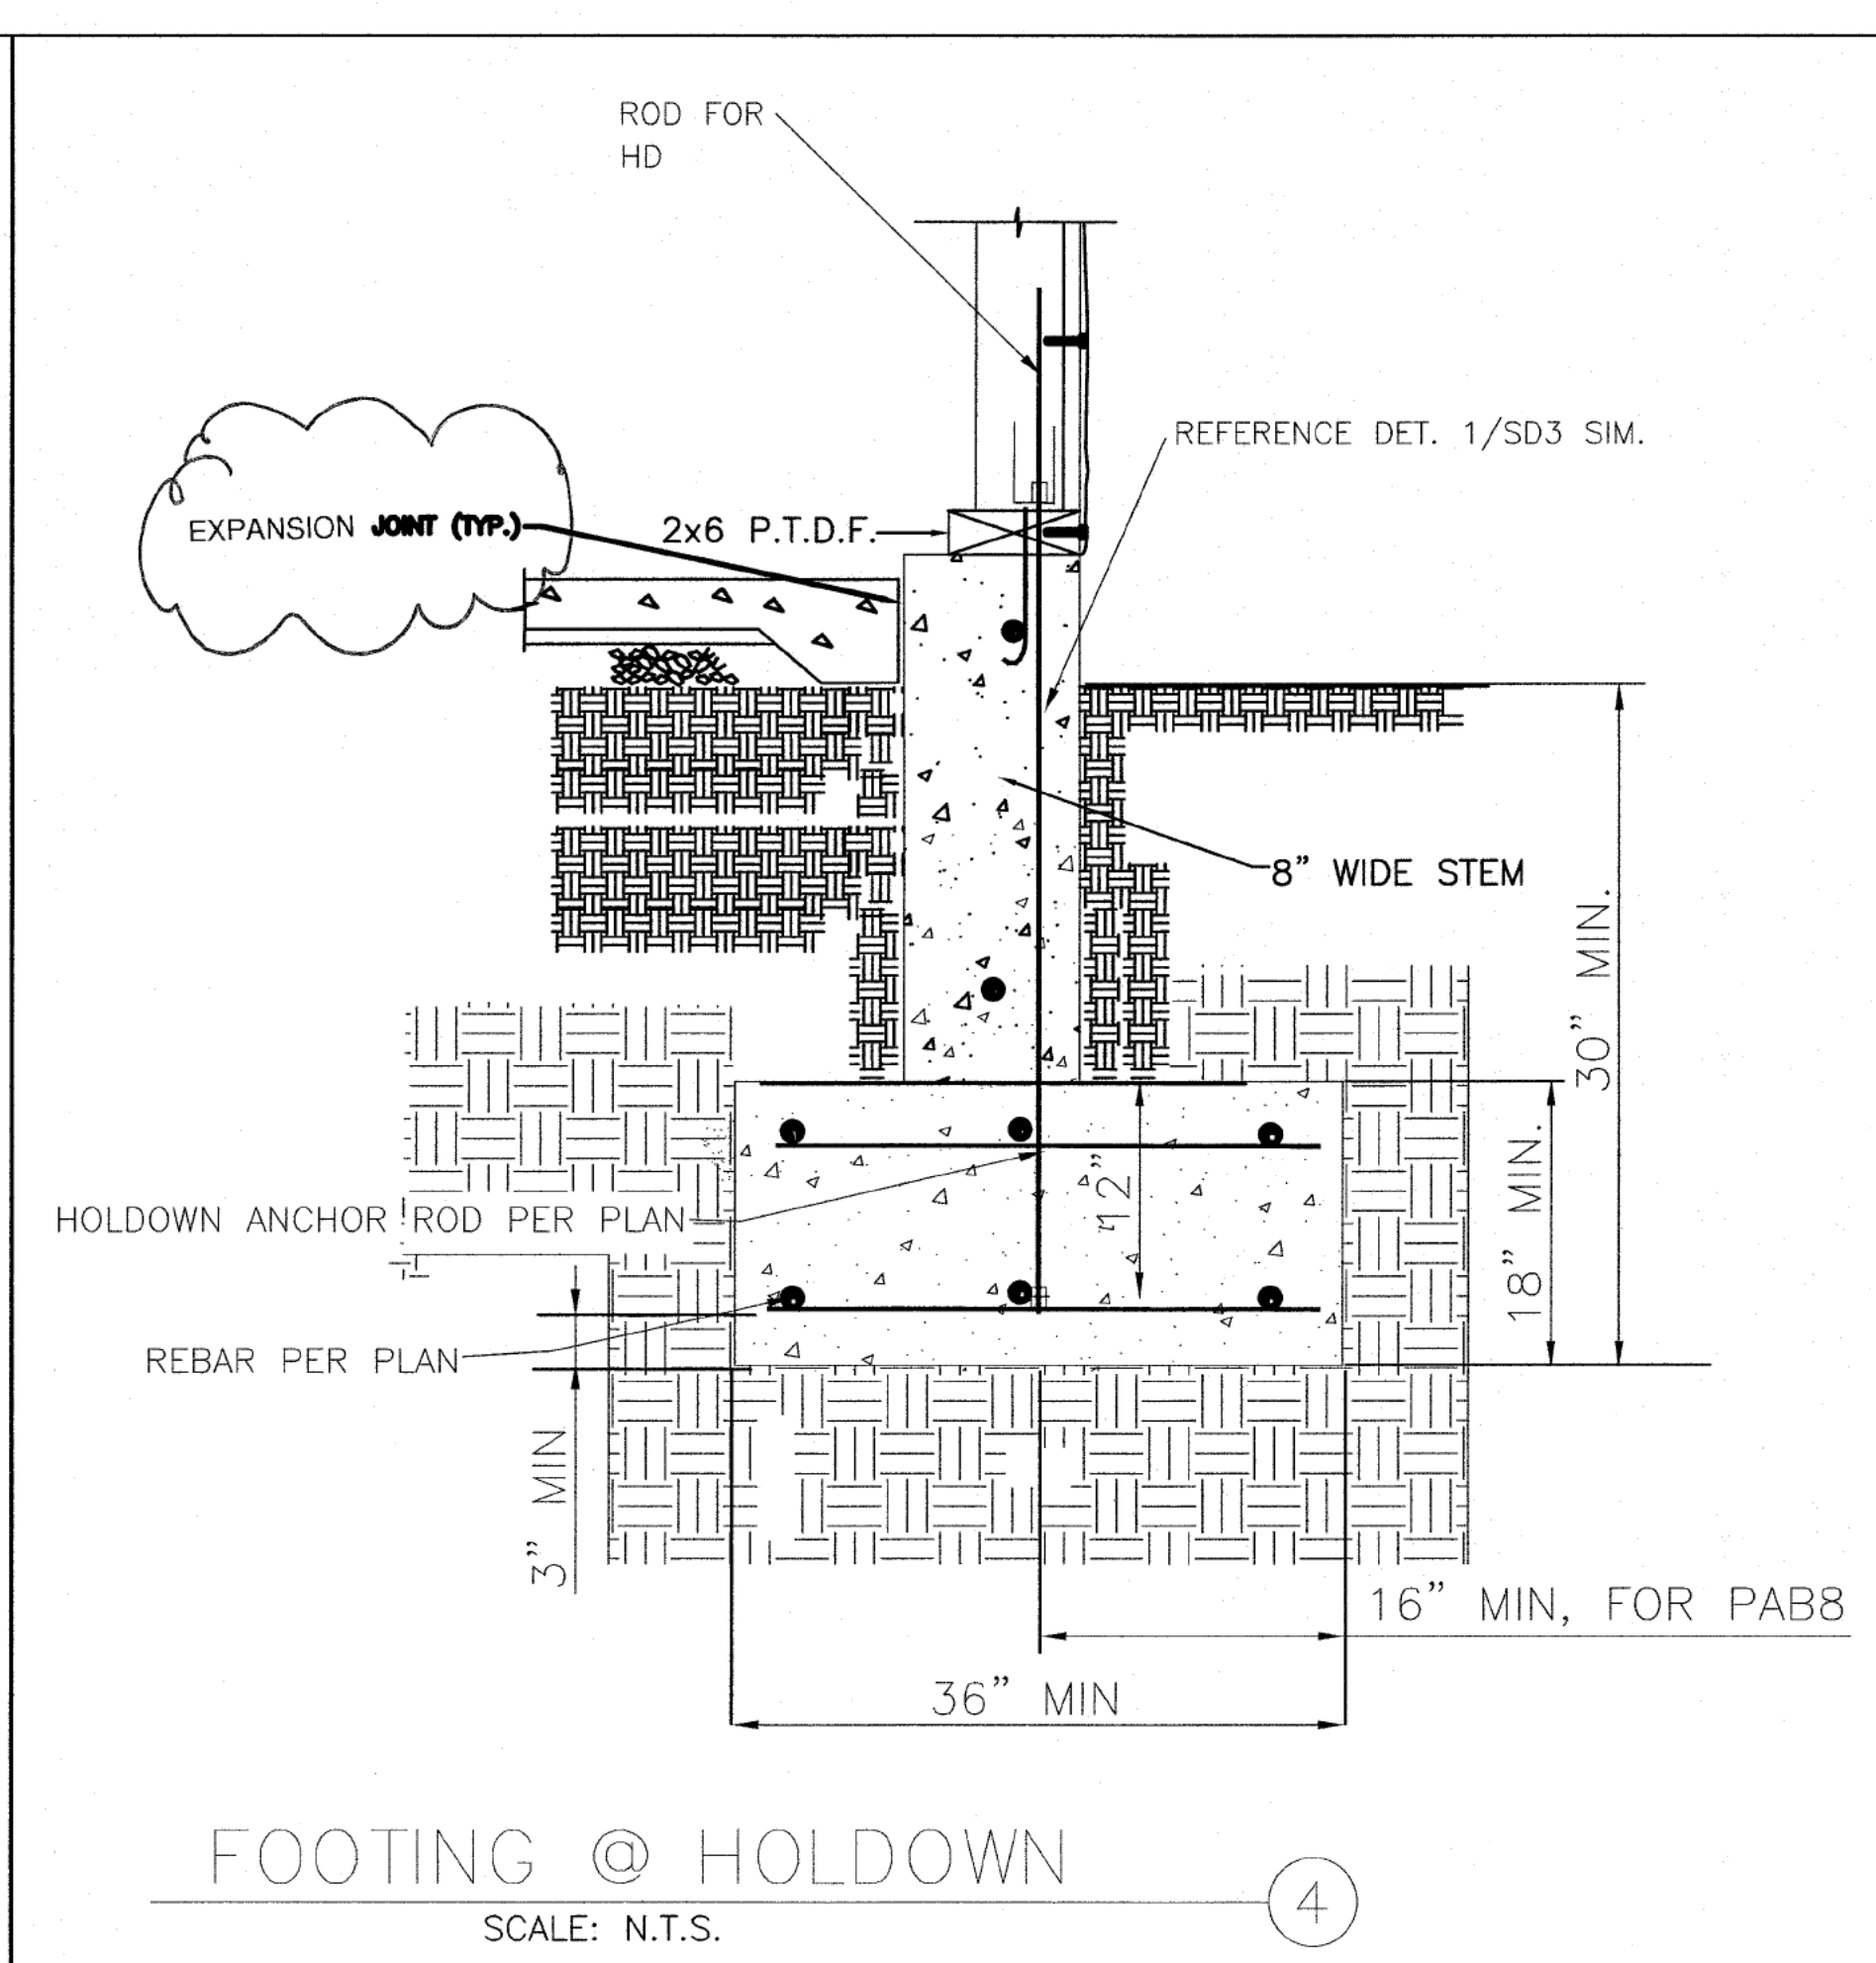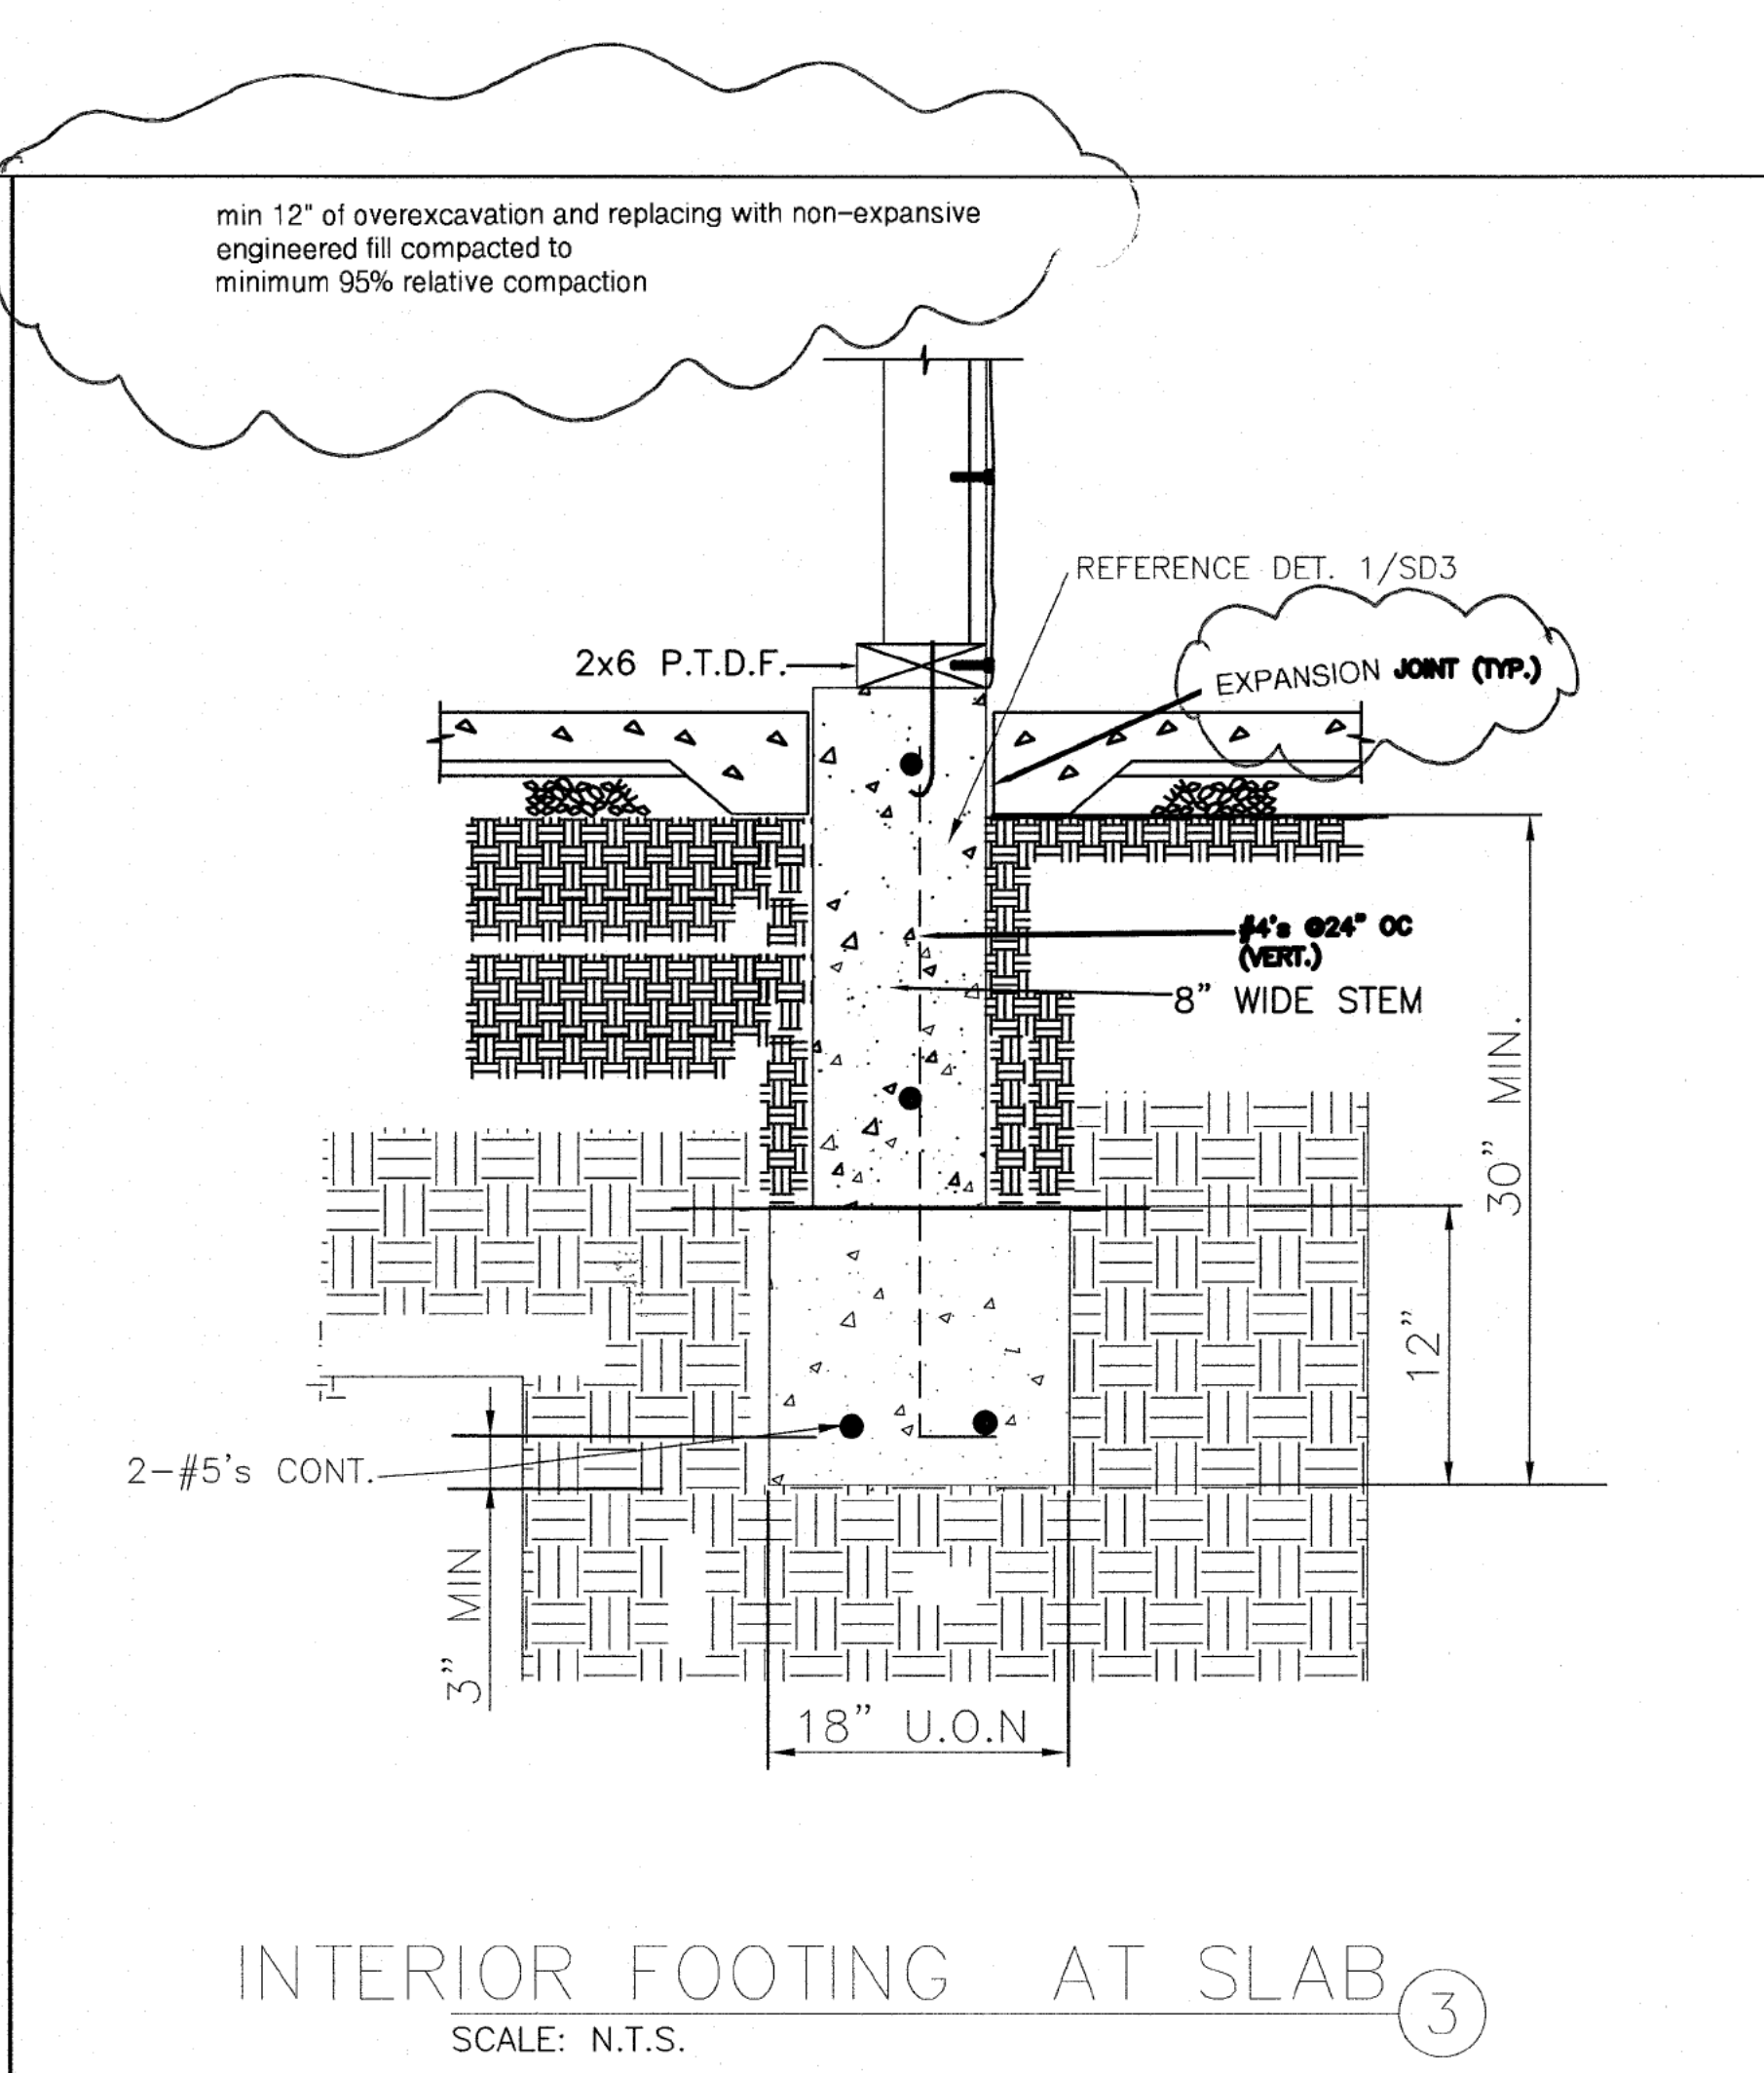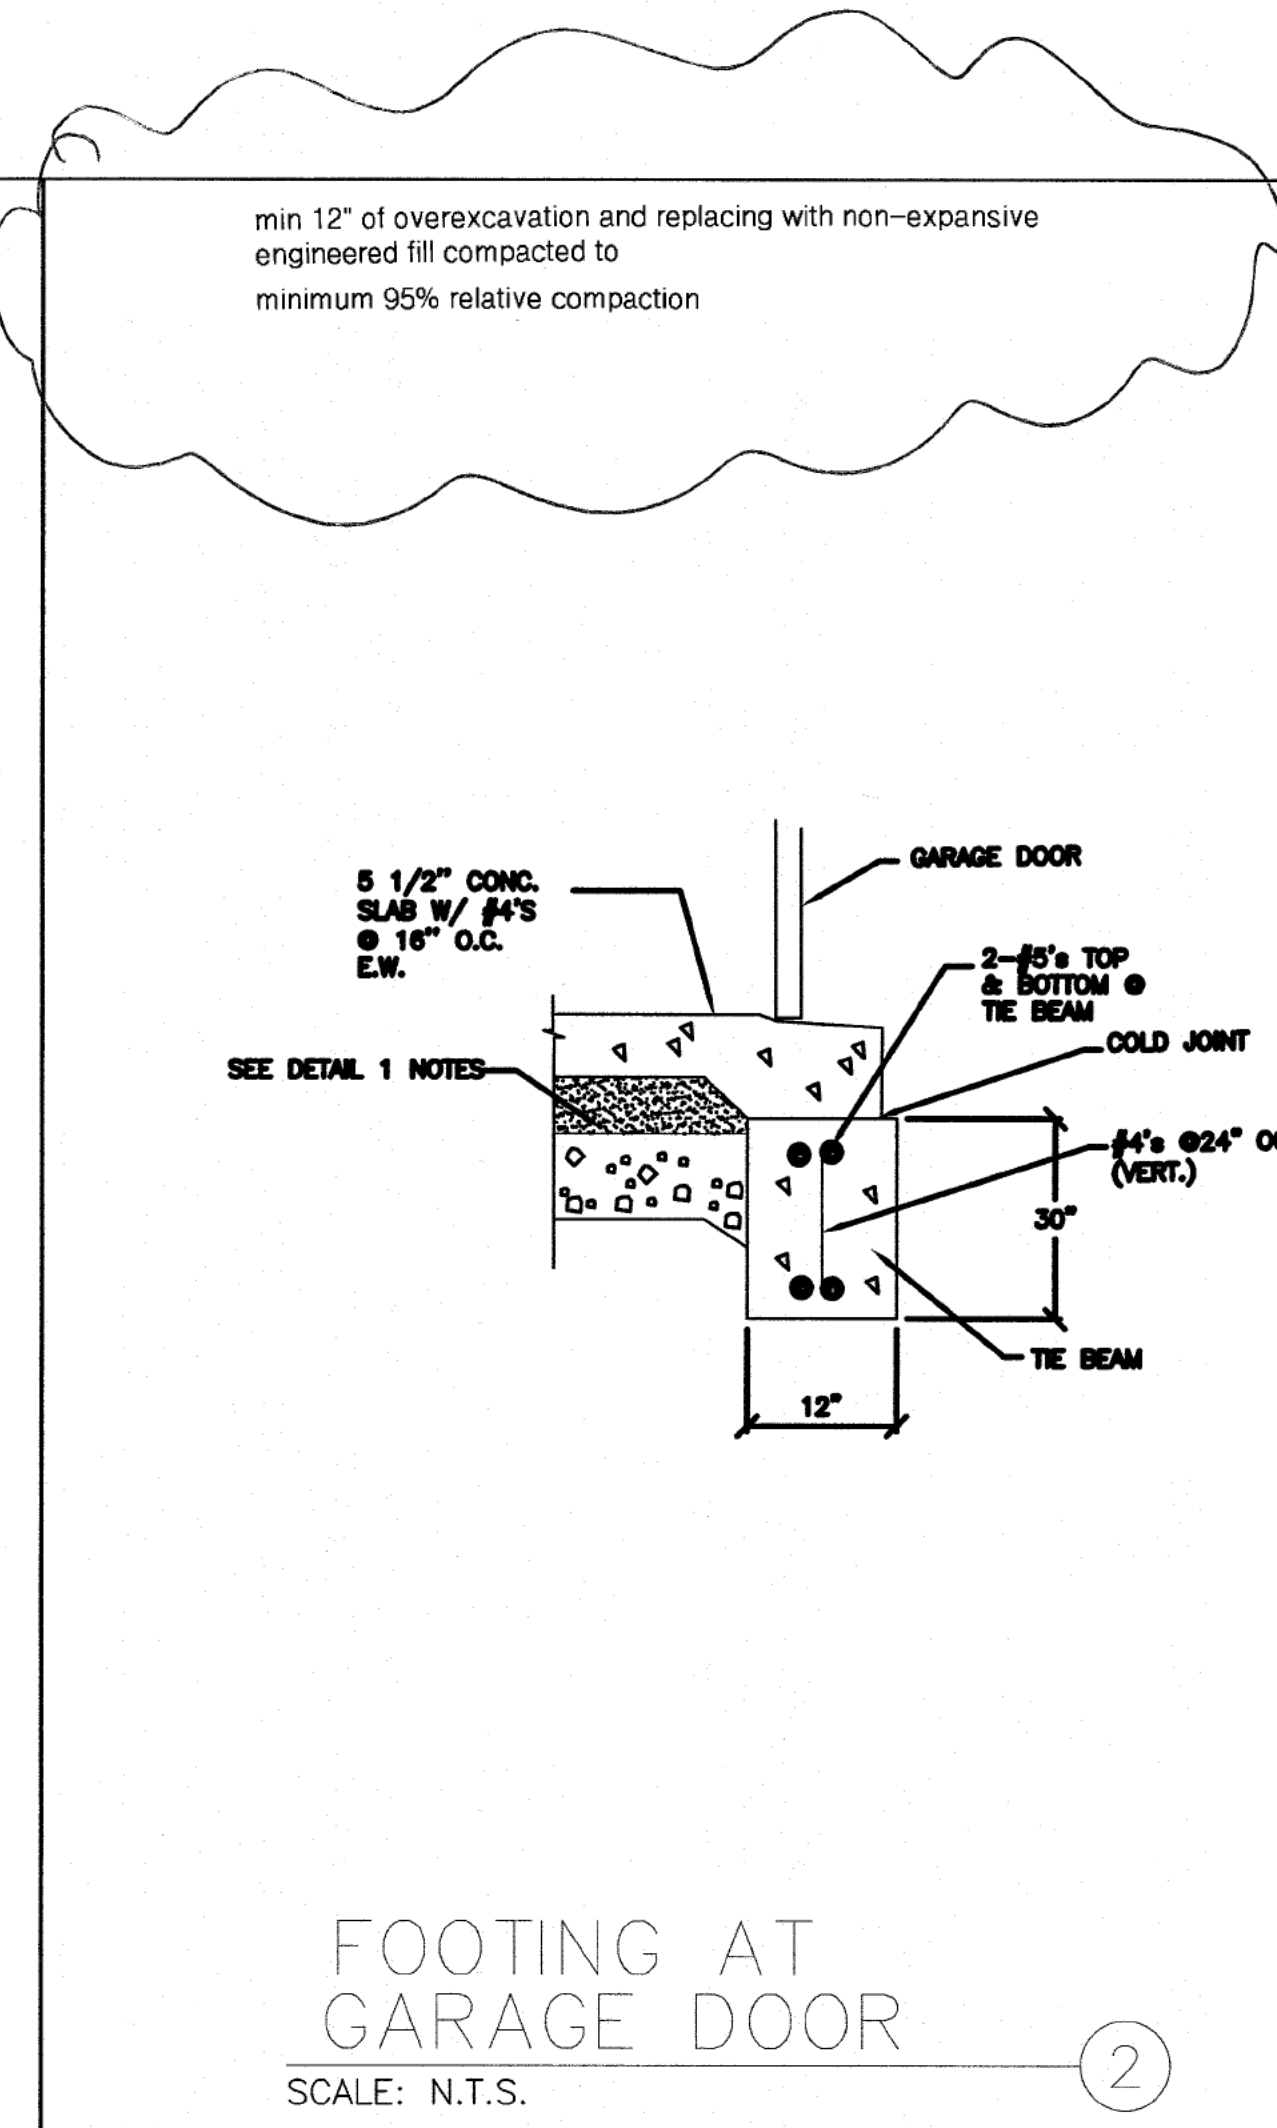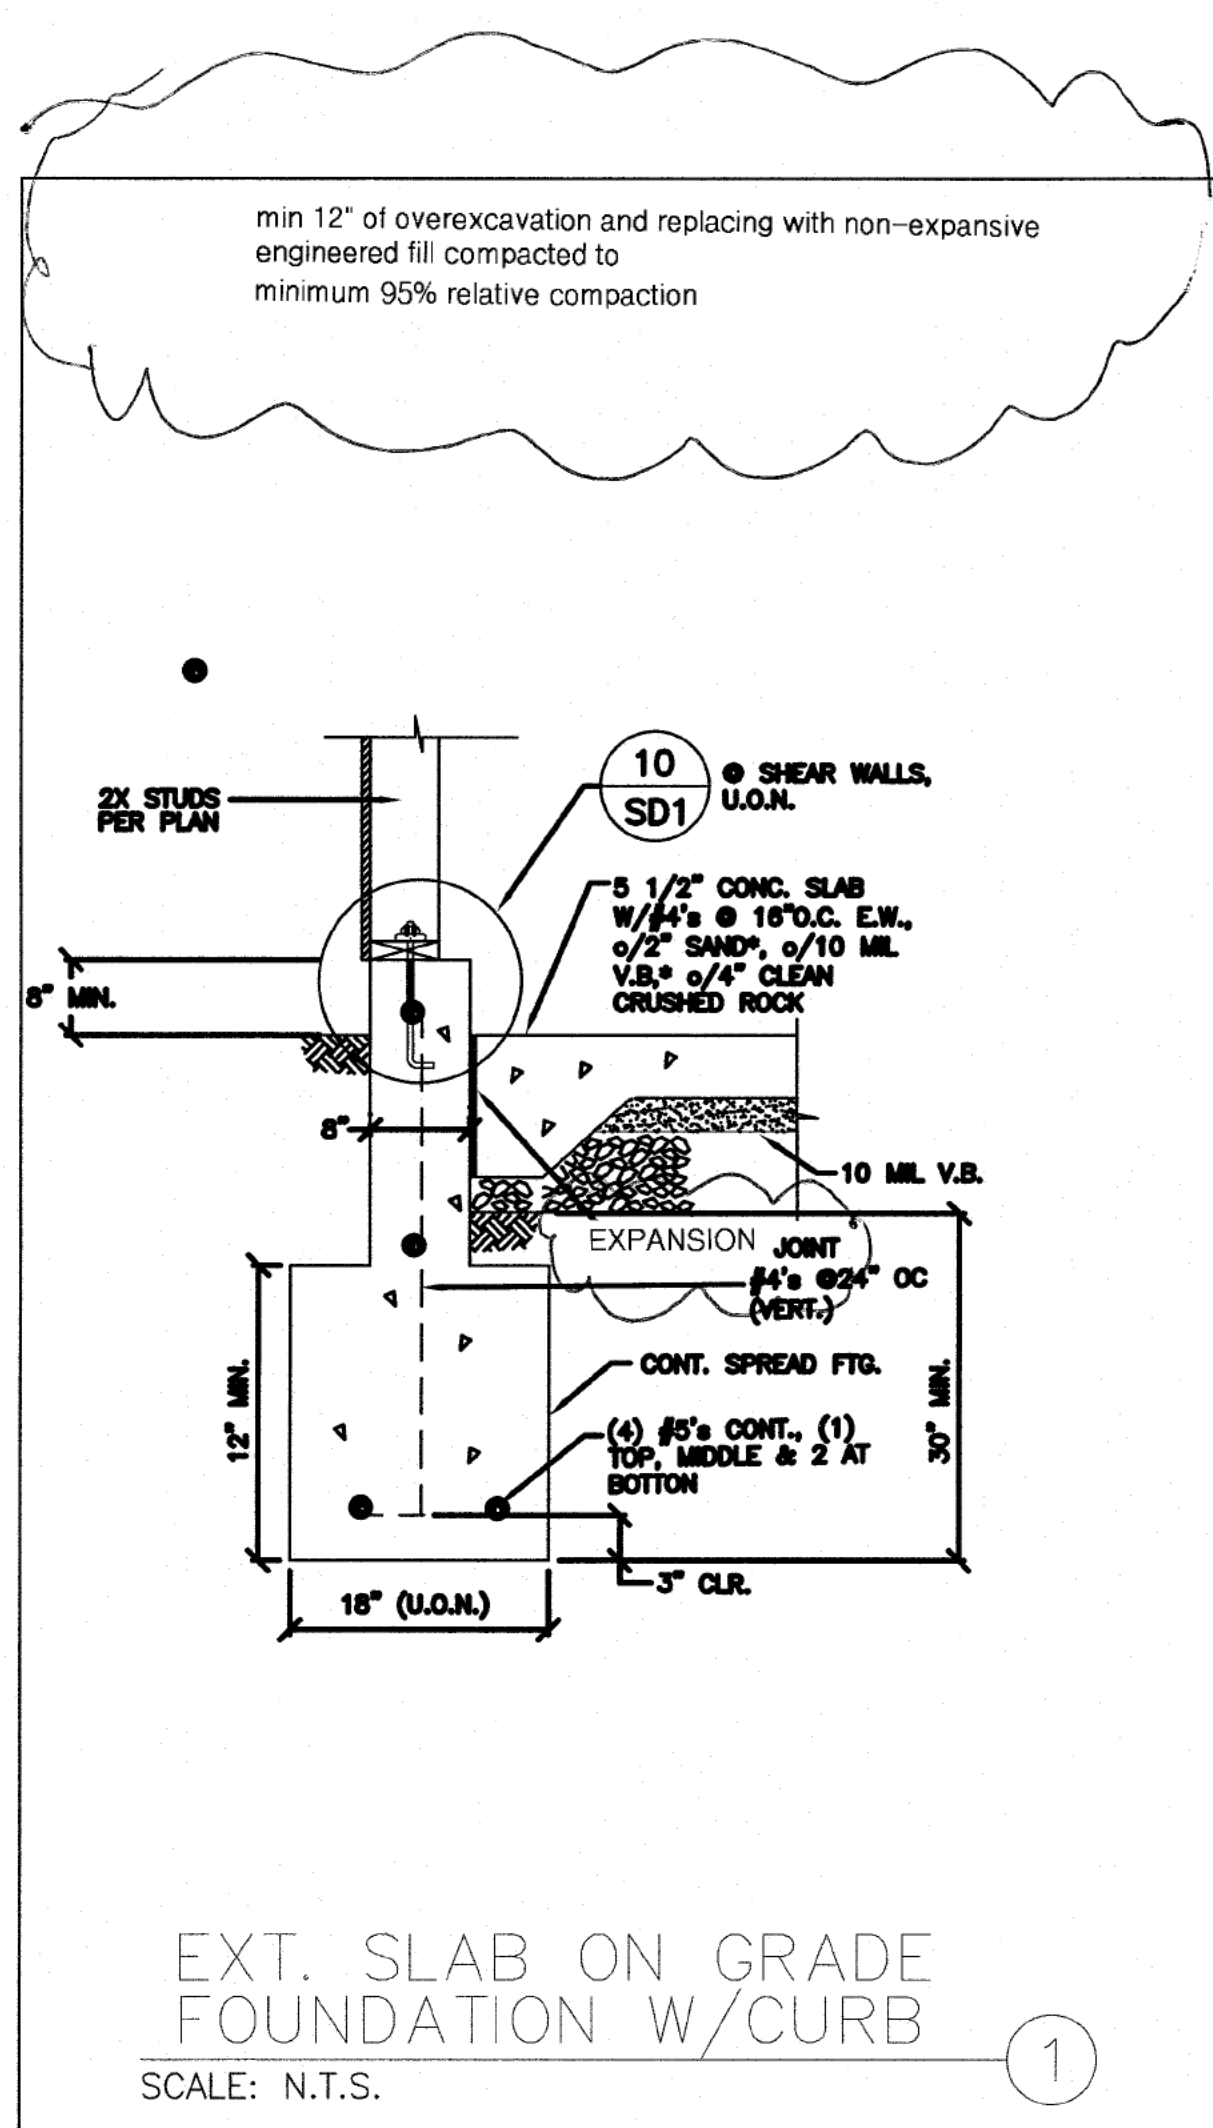

REVISIONS

FDN. DETAILS

ADDITION

Date: 4/15/16
Scale: AS NOTED
Drawn:
Job: 16-031
CAD File: 16-031-SD3
Sheet: SD3

IMPROVEMENT PLANS FOR

PARCEL MAP


CITY OF

ABBREVIATIONS

AB	AGGREGATE BASE
AC	ASPHALT CONCRETE
AD	AREA DRAIN
BC	BEGINNING OF CURVE
BVC	BEGIN VERTICAL CURVE
BO	BLOW OFF
BSW	BACK OF SIDEWALK
BW	BOTTOM OF WALL
CL	CENTER LINE
CMP	CORRUGATED METAL PIPE
CP	CENTER POINT
CS	CURB STATION
DWY	DRIVEWAY
DIP	DUCTILE IRON PIPE
EC	END OF CURVE
EVC	END VERTICAL CURVE
EVA	EMERGENCY VEHICLE ACCESS
EVAE	EMERGENCY VEHICLE ACCESS EASEMENT
EX	EXISTING
FC	FACE OF CURB
FG	FINISHED GRADE
FI	FIELD INLET
FL	FLOW LINE
GB	GRADE BREAK
GR	GRATE
HP	HIGH POINT
INV	INVERT ELEVATION
LP	LOW POINT
MH	MANHOLE
PAUE	PRIVATE ACCESS & UTILITY EASEMENT
PL	PROPERTY LINE
PSE	PUBLIC SERVICE EASEMENT
PUE	PRIVATE UTILITY EASEMENT
PVC	POLYVINYL CHLORIDE PIPE
PVI	POINT OF VERTICAL INTERSECTION
RCP	REINFORCED CONCRETE PIPE
RW	RIGHT OF WAY
SDE	STORM DRAIN EASEMENT
STA	STATION
SWI	STORM WATER INLET
SWK	SIDEWALK
TC	TOP OF CURB
TRC	TOP OF ROLLED CURB
TW	TOP OF WALL
WM	WATER METER
VC	VERTICAL CURVE
U.O.N.	UNLESS OTHERWISE NOTED

LEGEND

PROPOSED	DESCRIPTION	EXISTING
- - - - -	TRACT BOUNDARY	
- - - - -	LOT LINE	
- - - - -	RIGHT OF WAY	
- - - - -	CENTER LINE	
- - - - -	MATCH LINE	
- - - - -	SAW CUT LINE	
- - - - -	EASEMENT LINE	
- - - - -	STORM DRAIN	
- - - - -	SANITARY SEWER	
- - - - -	WATER	
- - - - -	CURB & GUTTER	
■	STORM WATER INLET	
■	FIELD INLET	
▶	DIRECTION OF FLOW	
●	MANHOLE	
●	FIRE HYDRANT	
●	BLOW OFF	
○	SANITARY SEWER CLEAN OUT	
✱	STREET LIGHT	
○	EXIST. TREE (TO REMAIN)	○ 20" OAK
~ 1.30 ~	CONTOUR ELEVATIONS	~ 525.2 ~
x 525.2	SPOT ELEVATION	
X	REMOVE EXISTING TREE	

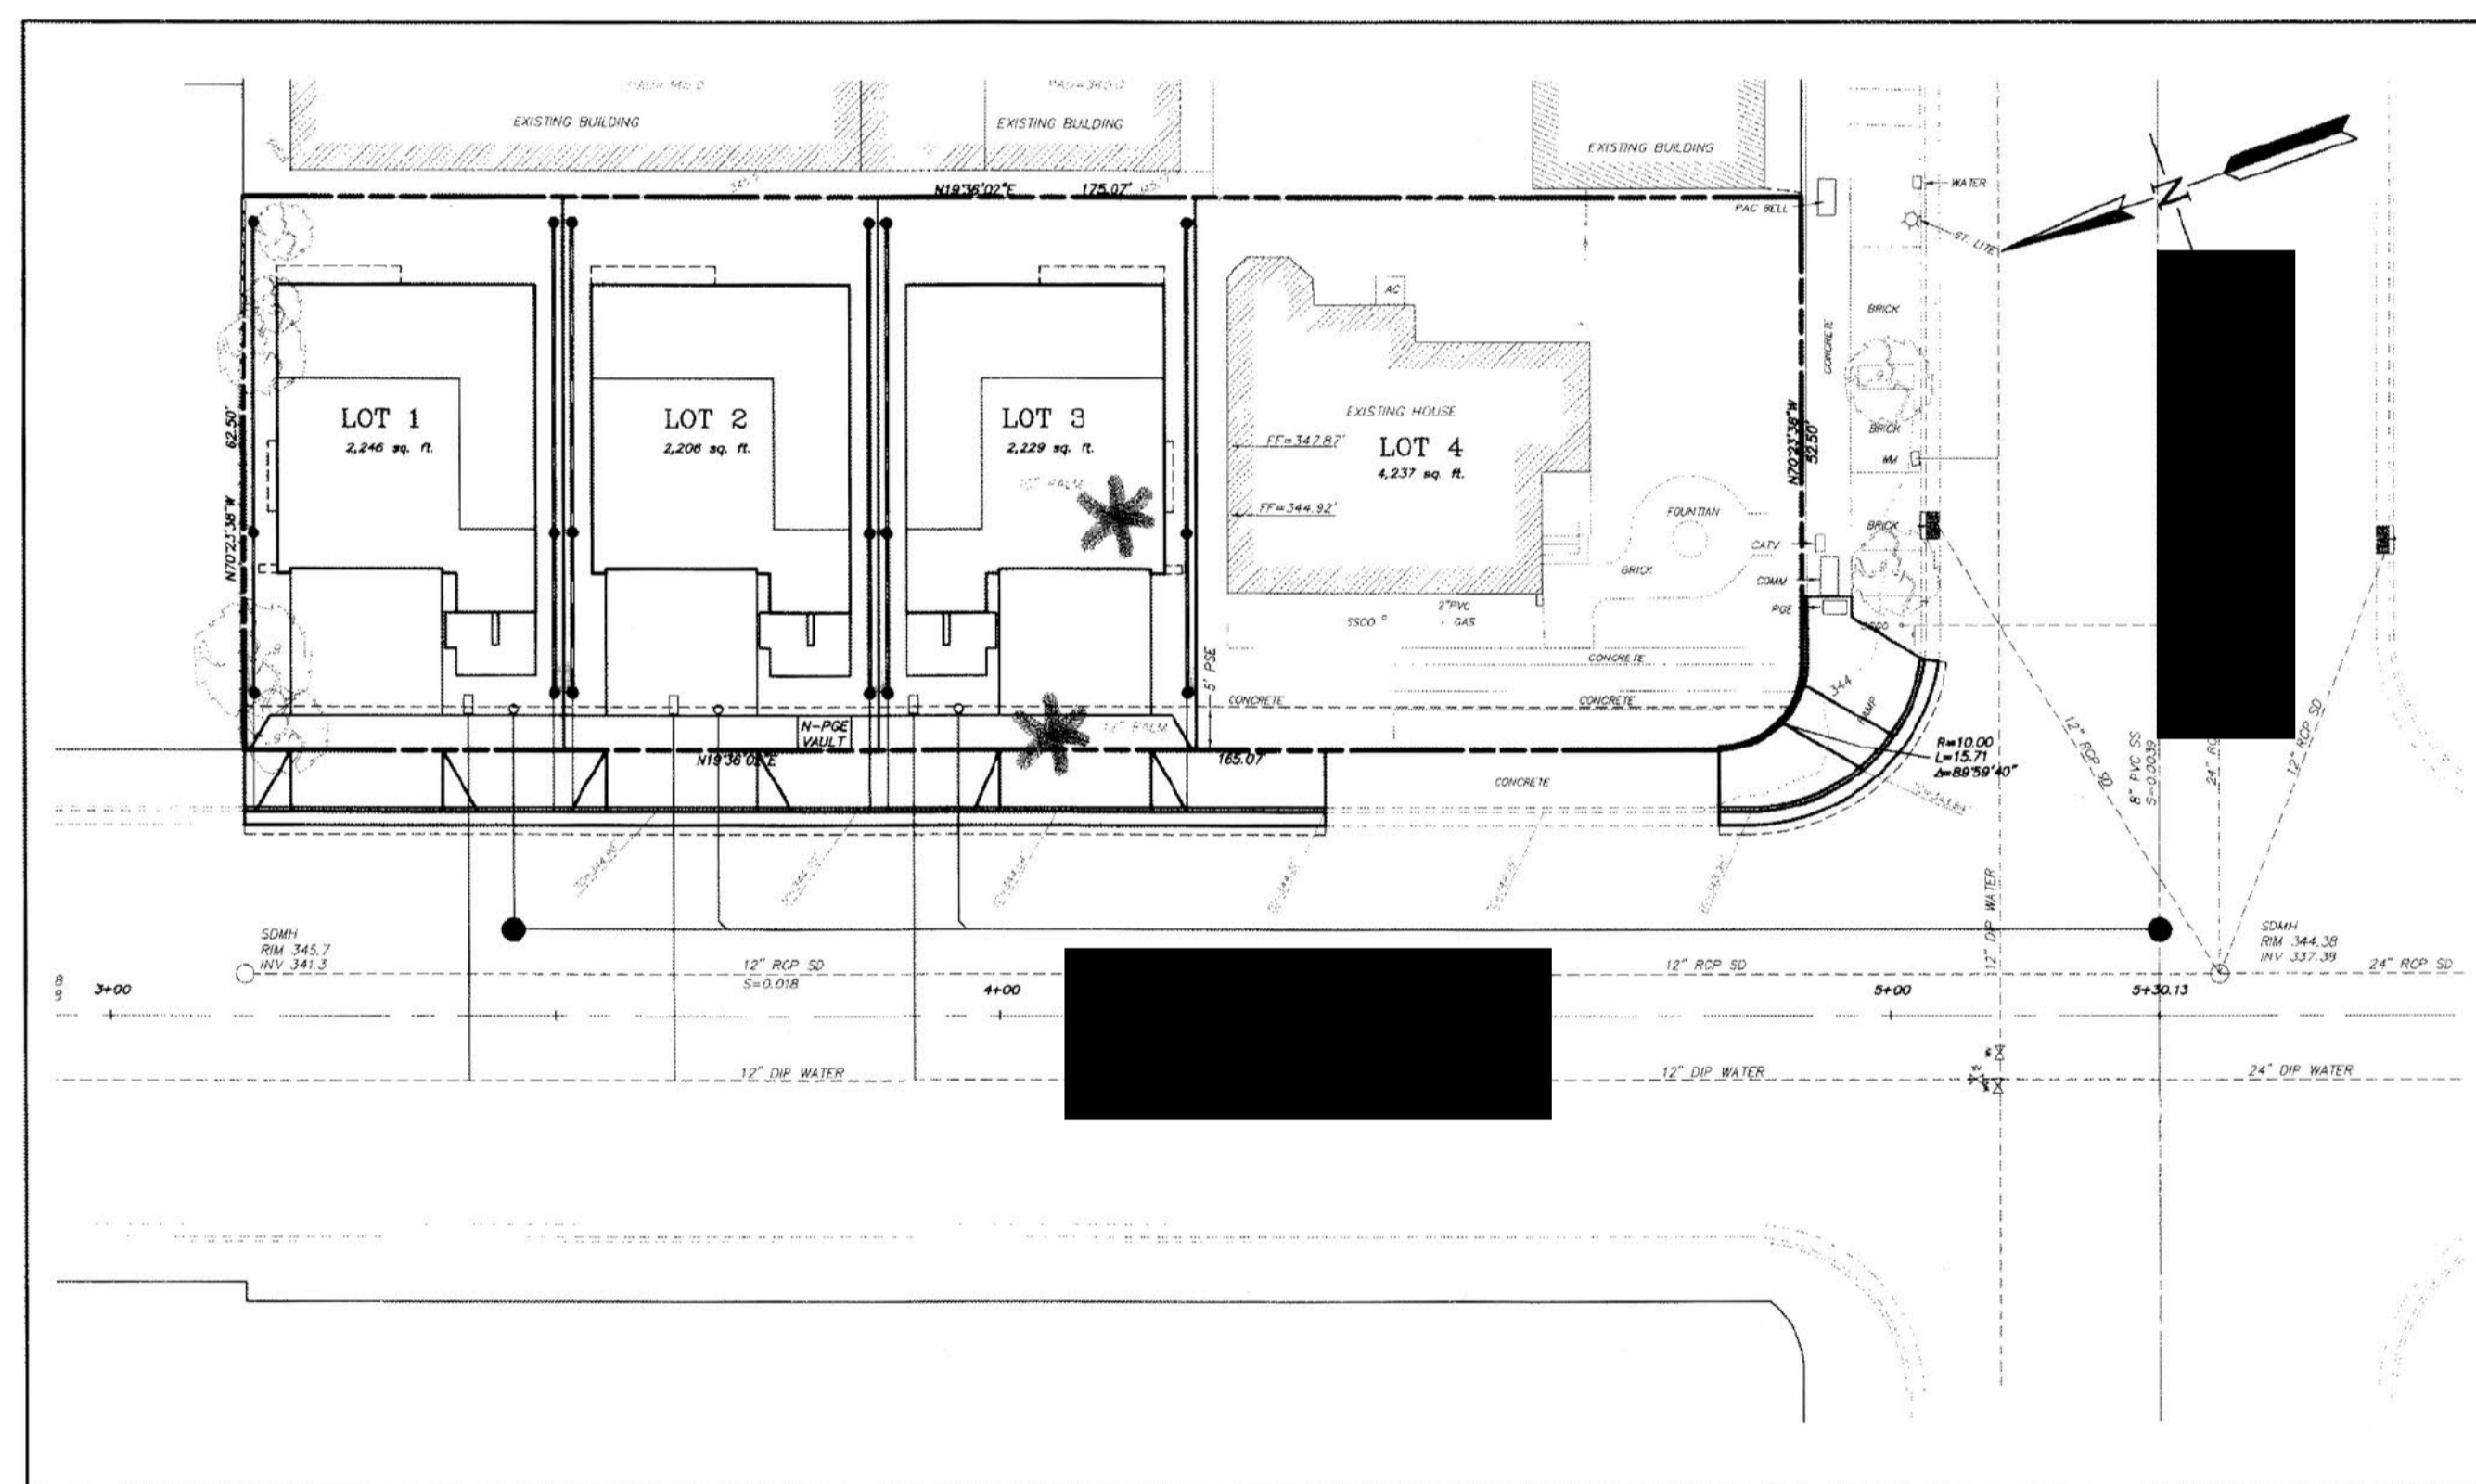

KEY MAP SCALE: 1" = 20'

VICINITY MAP NOT TO SCALE

SHEET INDEX

- 1 COVER SHEET
- 2 NOTES
- 3 DEMOLITION PLAN
- 4 PETERS AVENUE IMPROVEMENTS
- 5 GRADING PLAN
- 6 EROSION CONTROL PLAN
- 7 POLLUTION PREVENTION PLAN

HAUL ROUTE

- 1. ACCESS TO THE DEVELOPMENT BY CONSTRUCTION EQUIPMENT, MATERIAL DELIVERIES AND OTHER HEAVY LOADS SHALL BE LIMITED BY ALL CONTRACTORS TO THE FOLLOWING ROUTE: FROM HWY 580, HOPIYARD RD, DIVISION ST., ST. MARY'S ST. TO HWY 680, SUNOL BLVD., BERNAL AVE., PLEASANTON AVE., ST. MARY'S ST.
- 2. FOR ACCESS TO THE DEVELOPMENT FOR DUST CONTROL AND RECLAIMED WATER USE THE FOLLOWING ROUTE: STONERIDGE DR. AT JOHNSON DR., HOPIYARD RD, DIVISION ST., ST. MARY'S ST.

ENGINEER CERTIFICATE

PLANS PREPARED UNDER THE SUPERVISION OF:

[Redacted signature area]

BY: DATE:

GENERAL APPROVAL NOTE:

APPROVAL OF THESE PLANS IS FOR WORK WITHIN THE PUBLIC RIGHT-OF-WAY AND PUBLIC UTILITY FACILITIES WITHIN PUBLIC SERVICE EASEMENTS UNLESS OTHERWISE NOTED AS FOLLOWS:

APPROVAL OF THESE PLANS DOES NOT RELEASE THE DEVELOPER OF THE RESPONSIBILITY FOR CORRECTION OF MISTAKES, ERRORS, OR OMISSIONS CONTAINED THEREIN. IF DURING THE COURSE OF CONSTRUCTION OF THE IMPROVEMENTS, PUBLIC INTEREST REQUIRES A MODIFICATION OF OR A DEPARTURE FROM THE SPECIFICATIONS AND DETAILS OF THE CITY OF PLEASANTON OR THESE PLANS, THE CITY ENGINEER SHALL HAVE THE AUTHORITY TO REQUIRE SUCH MODIFICATION OR DEPARTURE AND TO SPECIFY SUCH MODIFICATION OR DEPARTURE AND TO SPECIFY THE MANNER IN WHICH SAME IS TO BE MADE.

NO.	BY	DATE	REVISIONS




DRAWN BY:	RD
DESIGNED BY:	RD
CHECKED BY:	DA
SCALE:	NO. SCALE

COVER SHEET

PROJECT NAME


DIST. NO.:	16085
DISK NO.:	SDSK
FILE NO.:	16085CT
DATE:	8-21-17

SHEET NO.: C1 OF 7 SHEETS

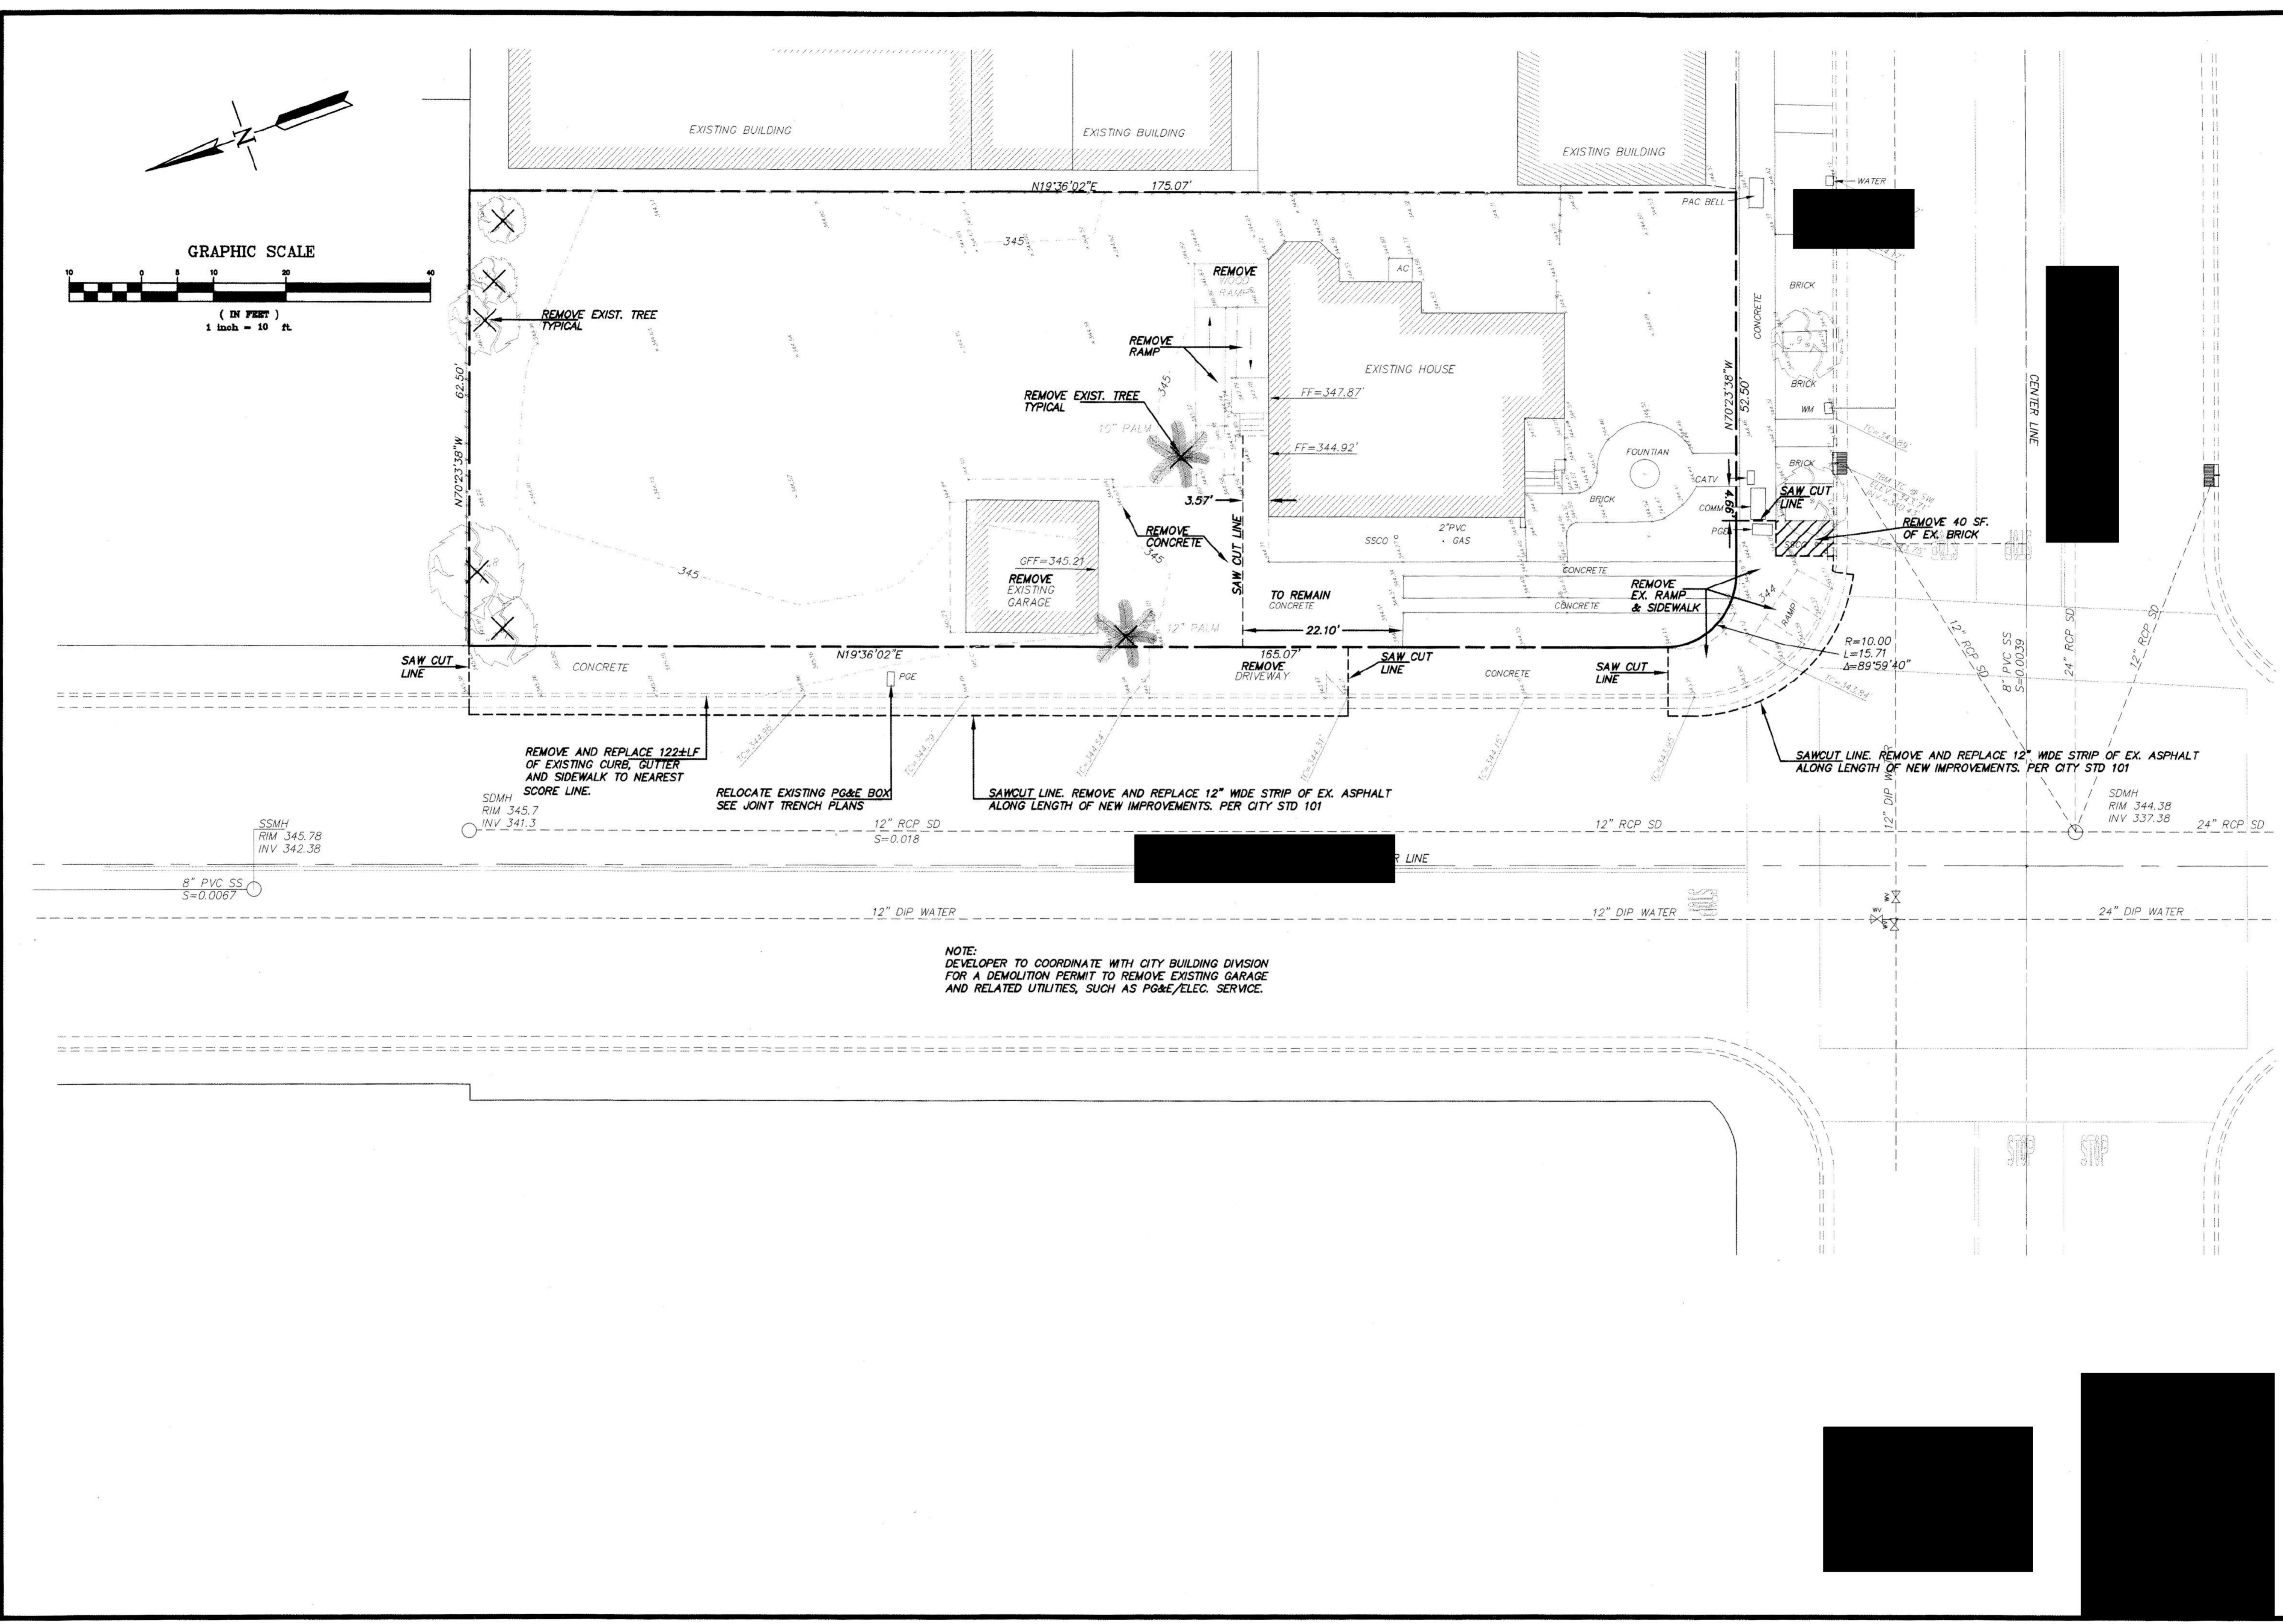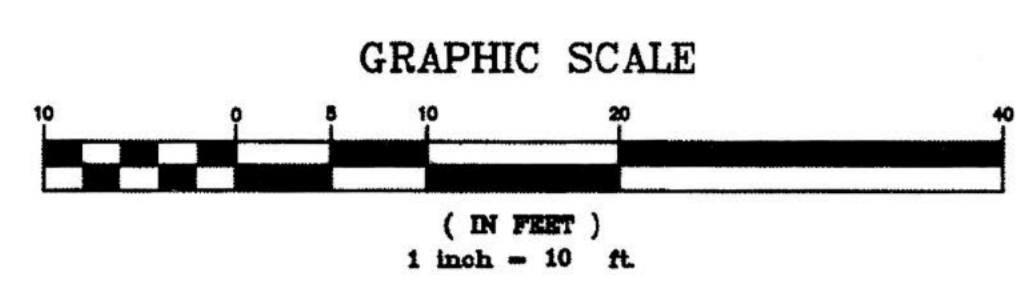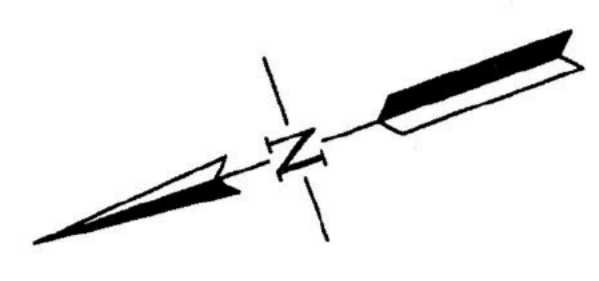

NOTE:
DEVELOPER TO COORDINATE WITH CITY BUILDING DIVISION
FOR A DEMOLITION PERMIT TO REMOVE EXISTING GARAGE
AND RELATED UTILITIES, SUCH AS PG&E/ELEC. SERVICE.


NO.	BY	DATE	REVISIONS

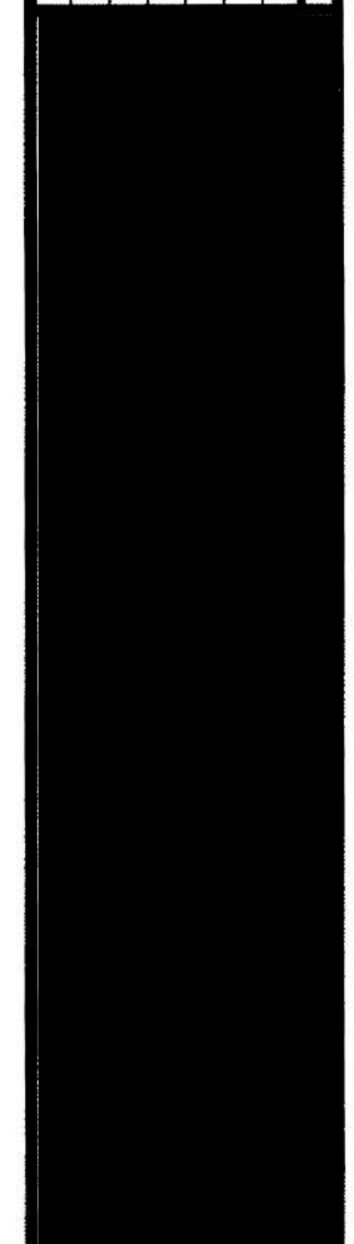

DESIGNED BY: RD	SCALE: 1"=10'
CHECKED BY: DA	
DRAWN BY: RD	

PROJECT NAME
DEMOLITION PLAN
ALAMEDA COUNTY, CALIFORNIA




JOB NO.: 16085
DSK NO.: SSK
FILE NO.: 16085
DATE: B-21-17
SHEET NO.: C3
OF 7 SHEETS

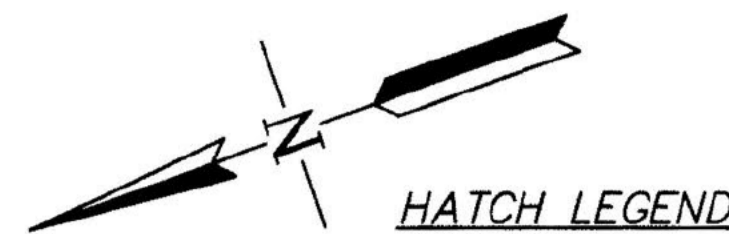

HATCH LEGEND

- NEW CONCRETE CURB, GUTTER & SIDEWALK
- NEW 12" WIDE ASPHALT STRIP
- LIMIT OF ASPHALT SLURRY SEAL

- ABBREVIATIONS**
- CO CLEAN OUT
 - EX EXISTING
 - MH MANHOLE
 - SD STORM DRAIN
 - SS SANITARY SEWER
 - STD STANDARD DETAILS
 - W WATER
 - WS WATER SERVICE

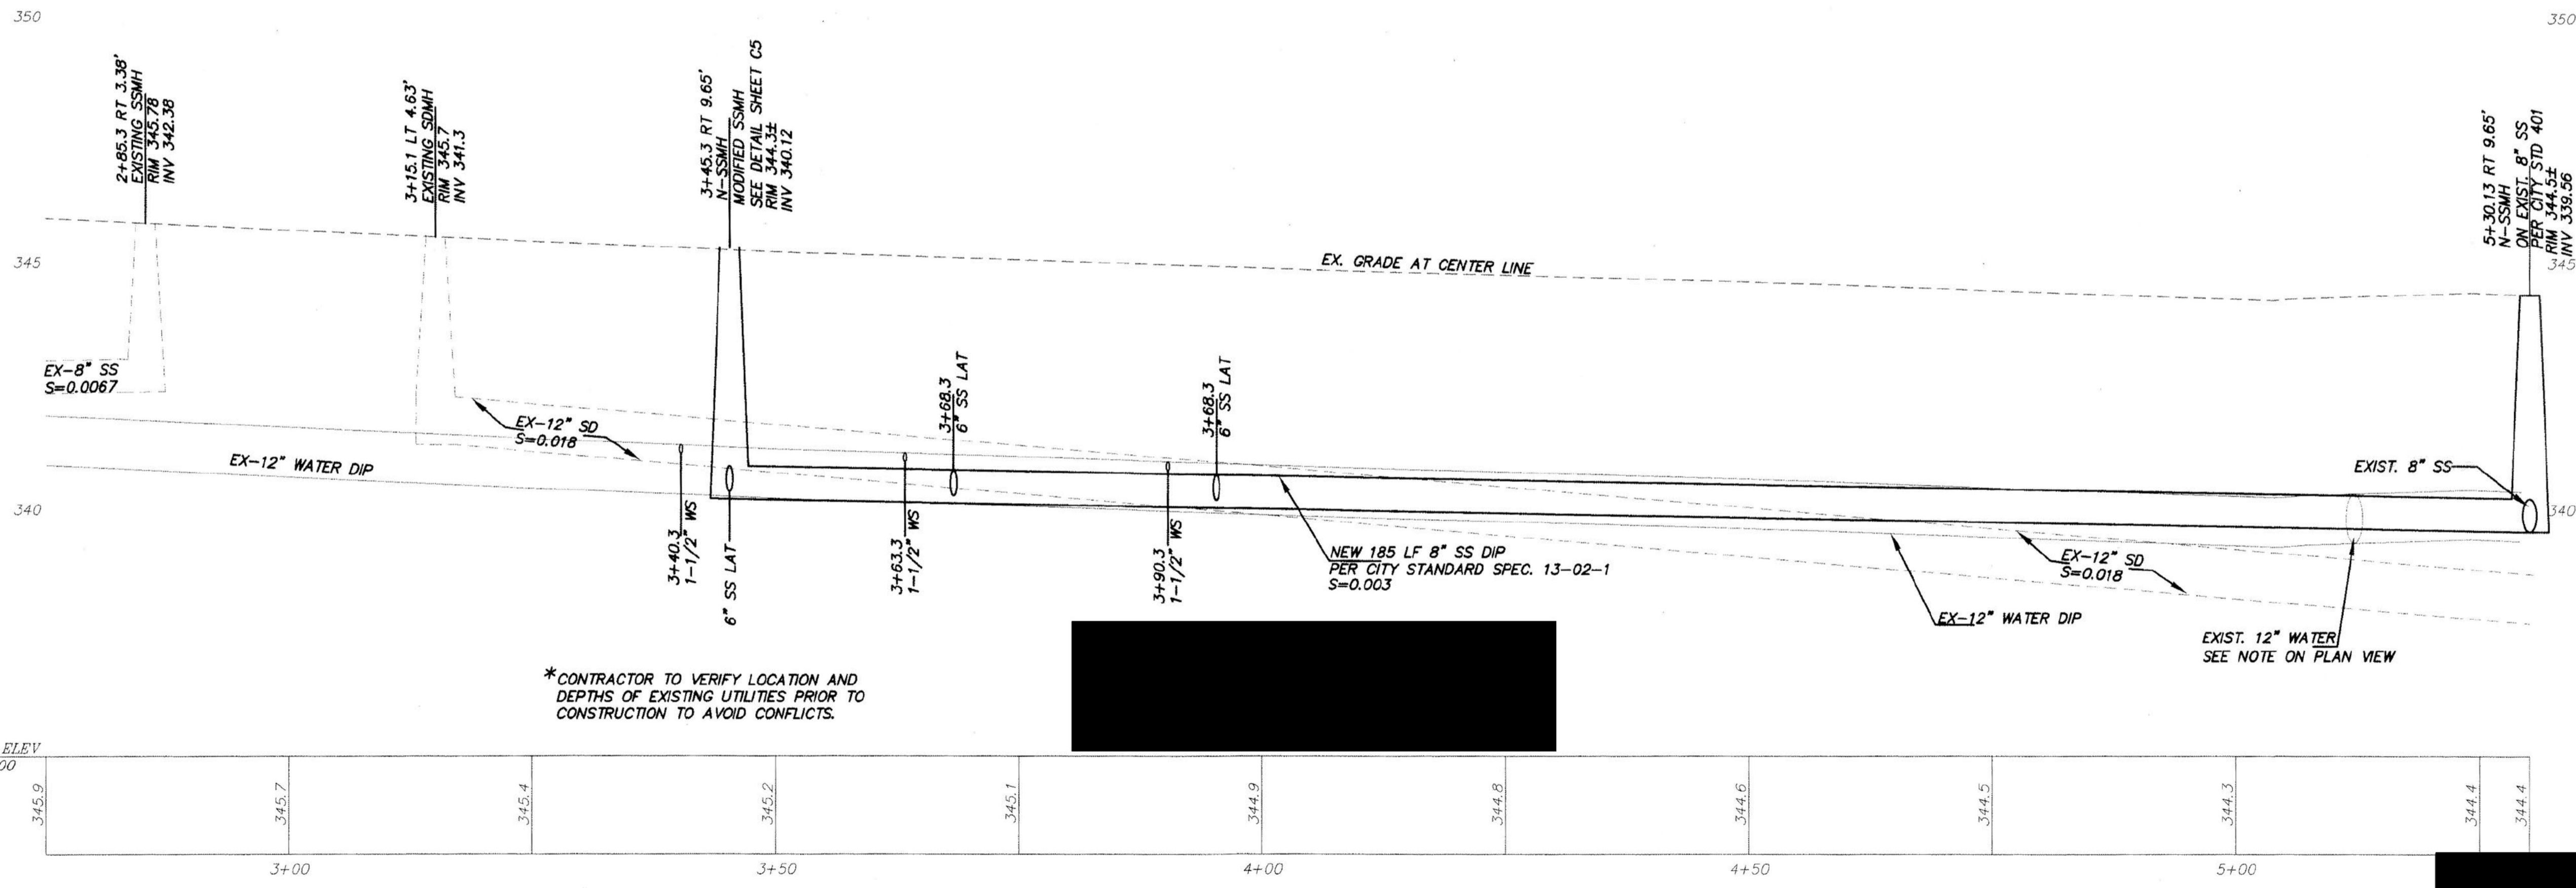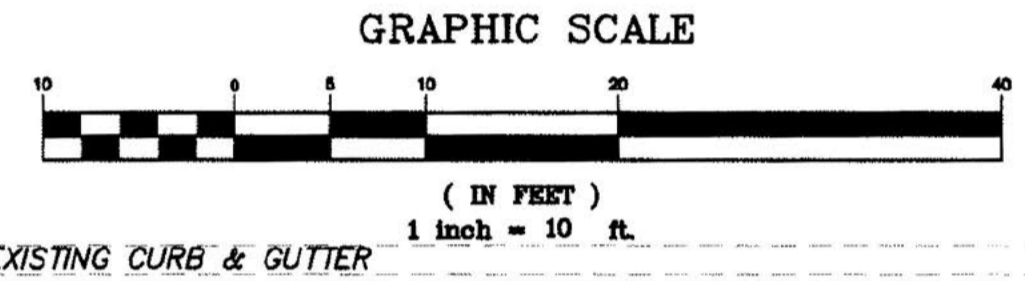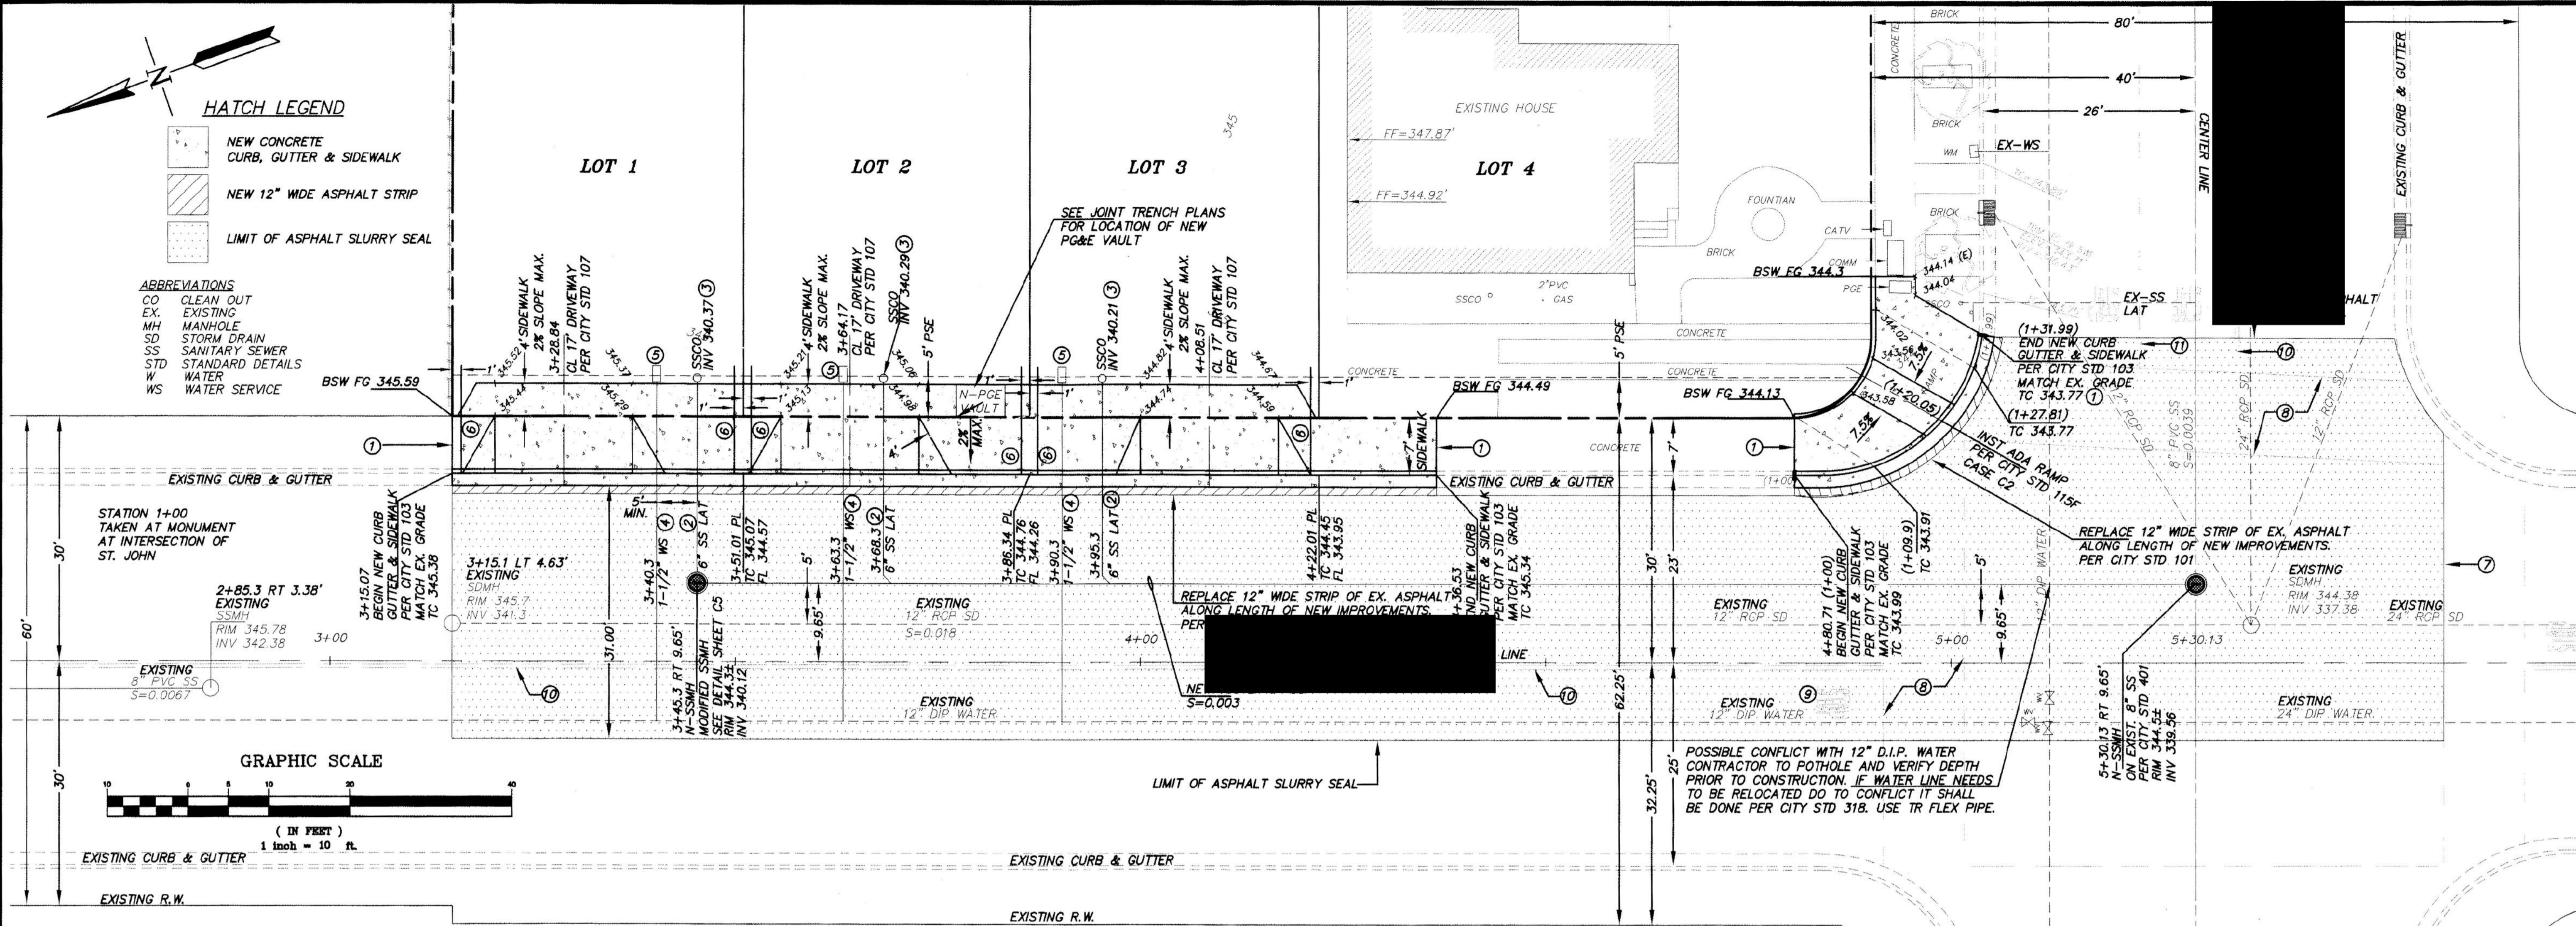

* CONTRACTOR TO VERIFY LOCATION AND DEPTHS OF EXISTING UTILITIES PRIOR TO CONSTRUCTION TO AVOID CONFLICTS.

NOTES

- ① DOWEL NEW CURB, GUTTER & SIDEWALK INTO EXISTING CURB, GUTTER & SIDEWALK ON BOTH SIDES. PER CITY STD 101
- ② INST SANITARY SEWER LATERALS PER CITY STD 408, LATERALS TO BE 6" IN DIA. AT S=0.01 MIN.
- ③ ALL SANITARY SEWER LATERALS SHALL HAVE 2-WAY CLEAN-OUTS PER CITY STD 409. SANITARY SEWER CLEAN-OUTS LOCATED IN DRIVEWAYS SHALL HAVE TRAFFIC RATED COVERS
- ④ INST 1-1/2" WATER SERVICES PER CITY STD 301 & 303
- ⑤ INST 5/8" WATER METER PER CITY STD 301. WATER METERS LOCATED IN DRIVEWAYS SHALL HAVE TRAFFIC RATED COVERS AND BOXES
- ⑥ INST THROUGH CURB DRAIN 3" DIA. SCHEDULE 40 PVC PER CITY STD 208
- ⑦ LIMIT OF SLURRY SEAL AT EDGE OF EXISTING CROSS WALK. EXISTING CROSS WALK TO REMAIN
- ⑧ RE-STRIPE EXISTING CROSS WALK PER CALTRANS STD
- ⑨ REPLACE EXISTING "STOP" MARKING PER CALTRANS STD
- ⑩ RE-STRIPE EXISTING DOUBLE YELLOW DIRECTION MARKING PER CALTRANS STD 21
- ⑪ RE-STRIPE EXISTING WHITE LANE LINE PER CALTRANS STD 21

NO.	REV.	DATE	REVISIONS	APPROVED

DRAWN BY:	RD	DESIGNED BY:	RD	CHECKED BY:	DA	SCALE:	1" = 10'
PROJECT NAME							




JOB NO.:	16085	DISK NO.:	SDSK	FILE NO.:	16085	DATE:	8-21-17
SHEET NO.:							

C4

OF 7 SHEETS

NO.	BY	DATE	REVISIONS

- ① INST AD GR 345.3 INV 344.7
- ② INST AD GR 346.15 INV 344.88
- ③ INST AD GR 346.15 INV 345.23
- ④ INST AD GR 345.3 INV 344.7
- ⑤ INST AD GR 346.0 INV 344.88
- ⑥ INST AD GR 346.0 INV 345.23
- ⑦ INST AD GR 345.0 INV 344.39
- ⑧ INST AD GR 346.0 INV 344.57
- ⑨ INST AD GR 346.0 INV 344.92
- ⑩ INST AD GR 345.0 INV 344.39
- ⑪ INST AD GR 345.6 INV 344.57
- ⑫ INST AD GR 345.6 INV 344.92
- ⑬ INST AD GR 344.88 INV 344.08
- ⑭ INST AD GR 345.6 INV 344.26
- ⑮ INST AD GR 345.6 INV 344.61
- ⑯ INST 18 LF 6" SD @ S=0.01
- ⑰ INST 35 LF 6" SD @ S=0.01
- ⑱ STAIRS TO ENTRY SEE ARCHITECT'S PLAN FOR MORE INFORMATION

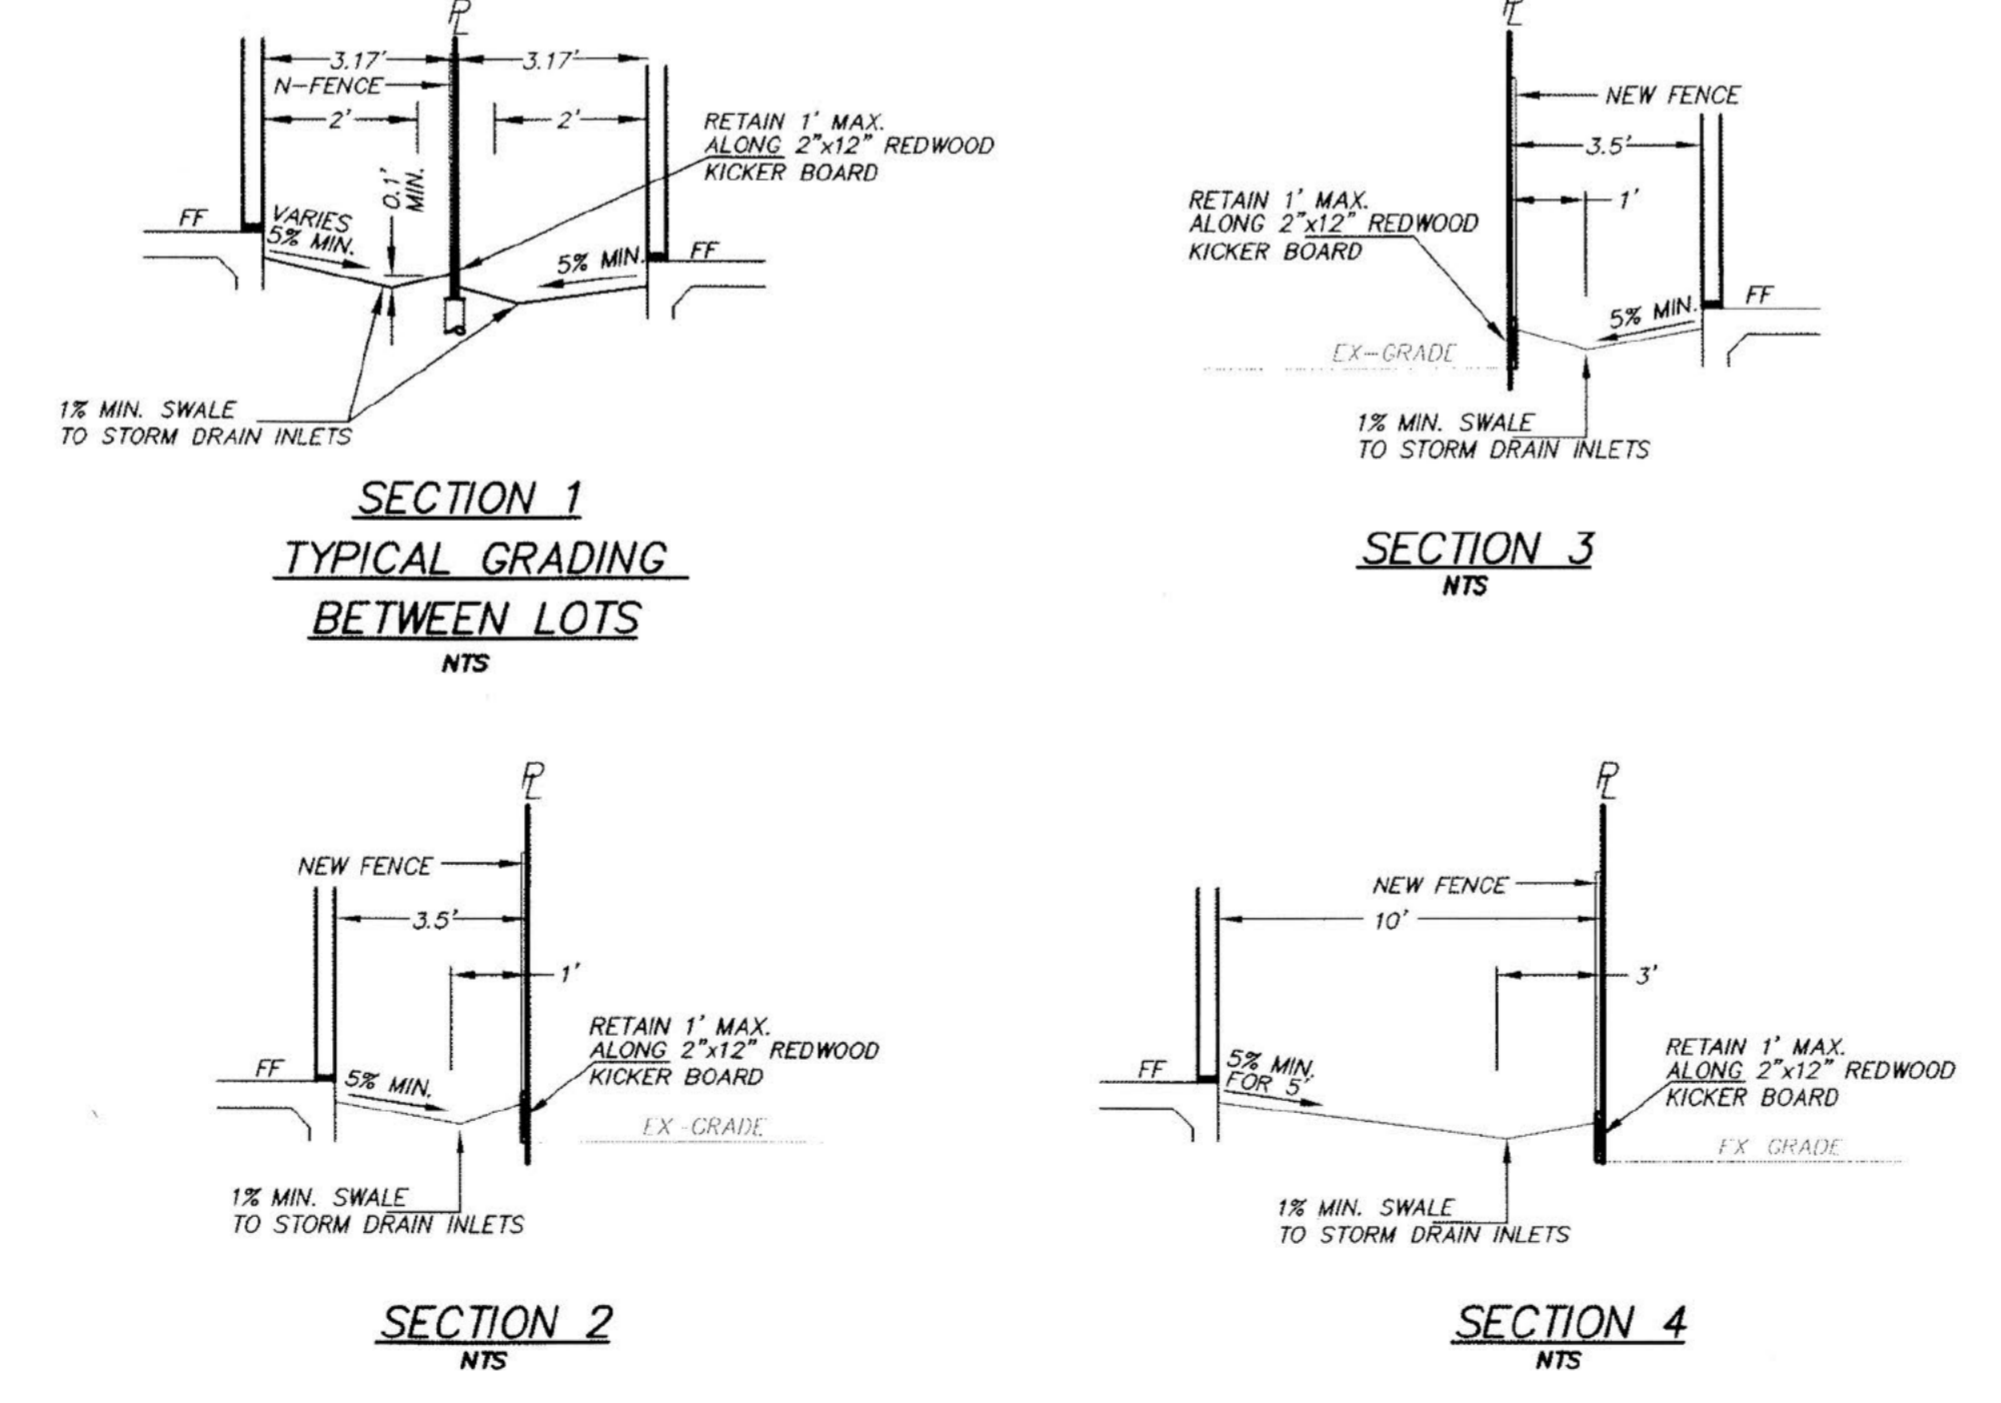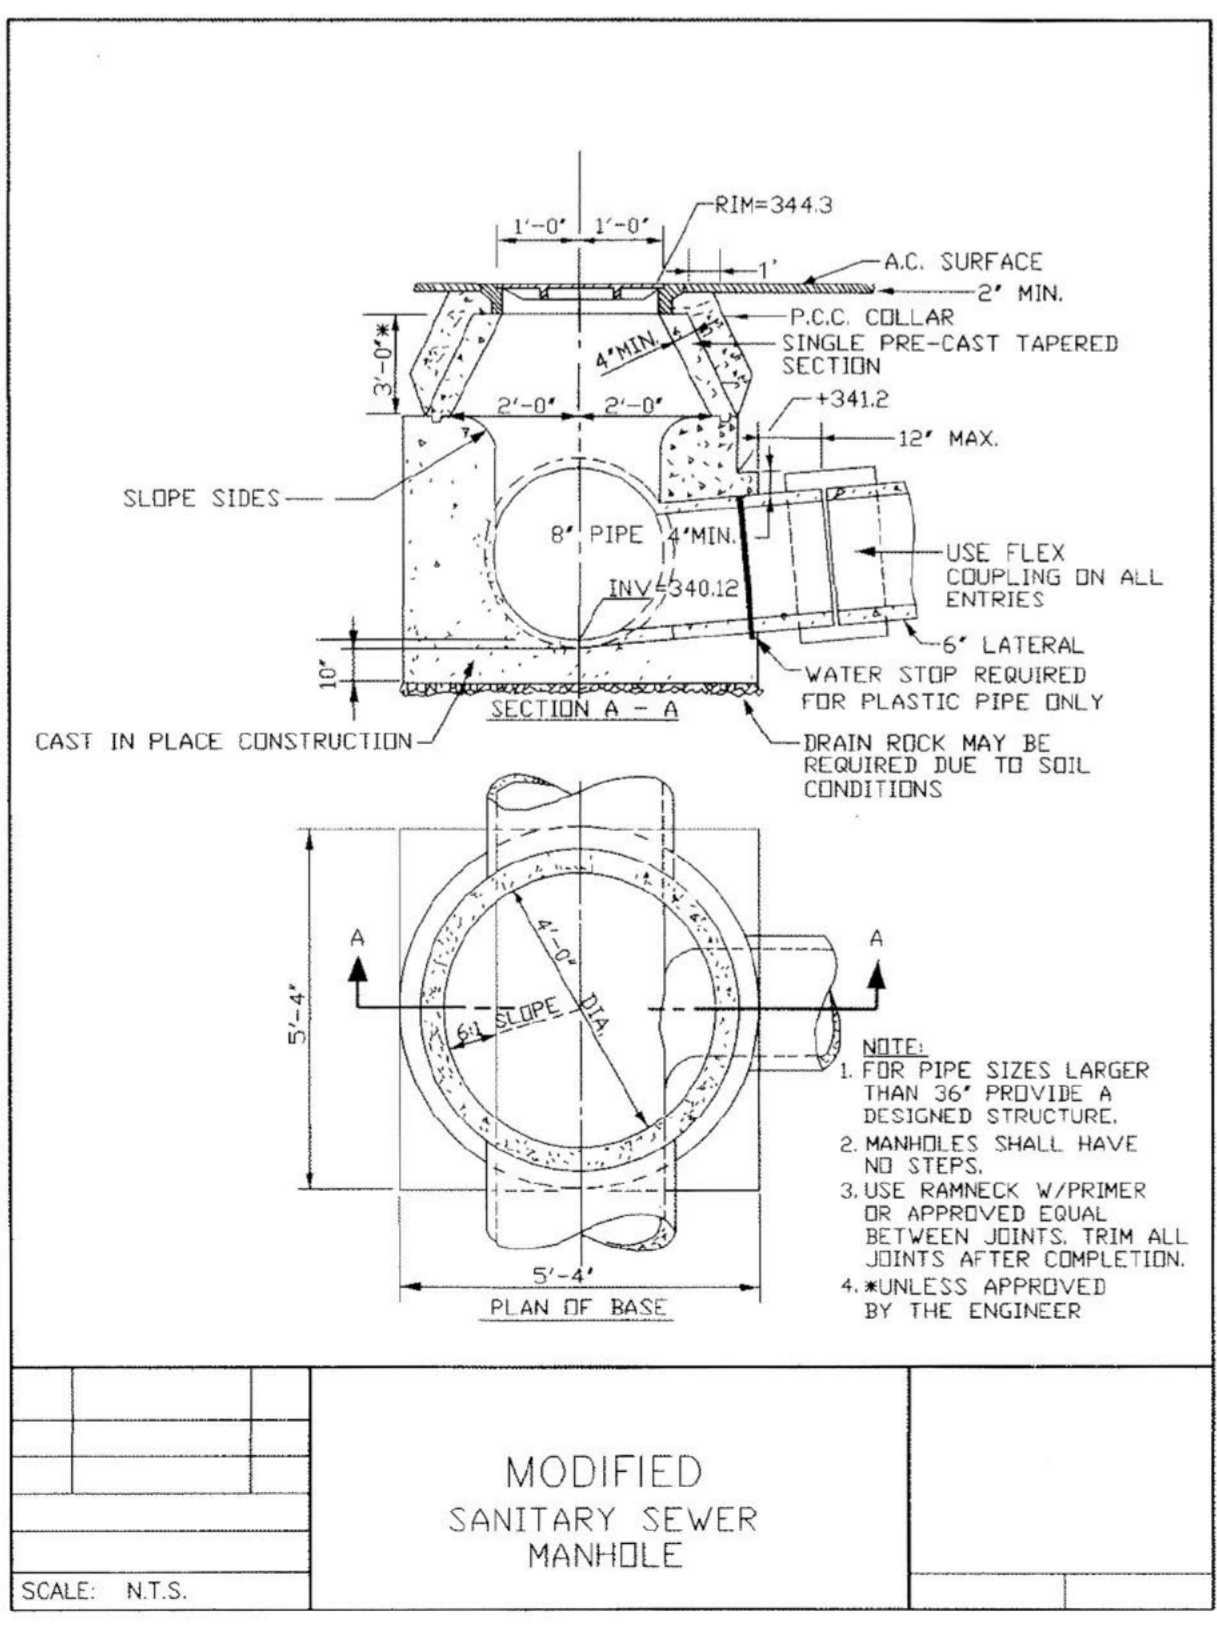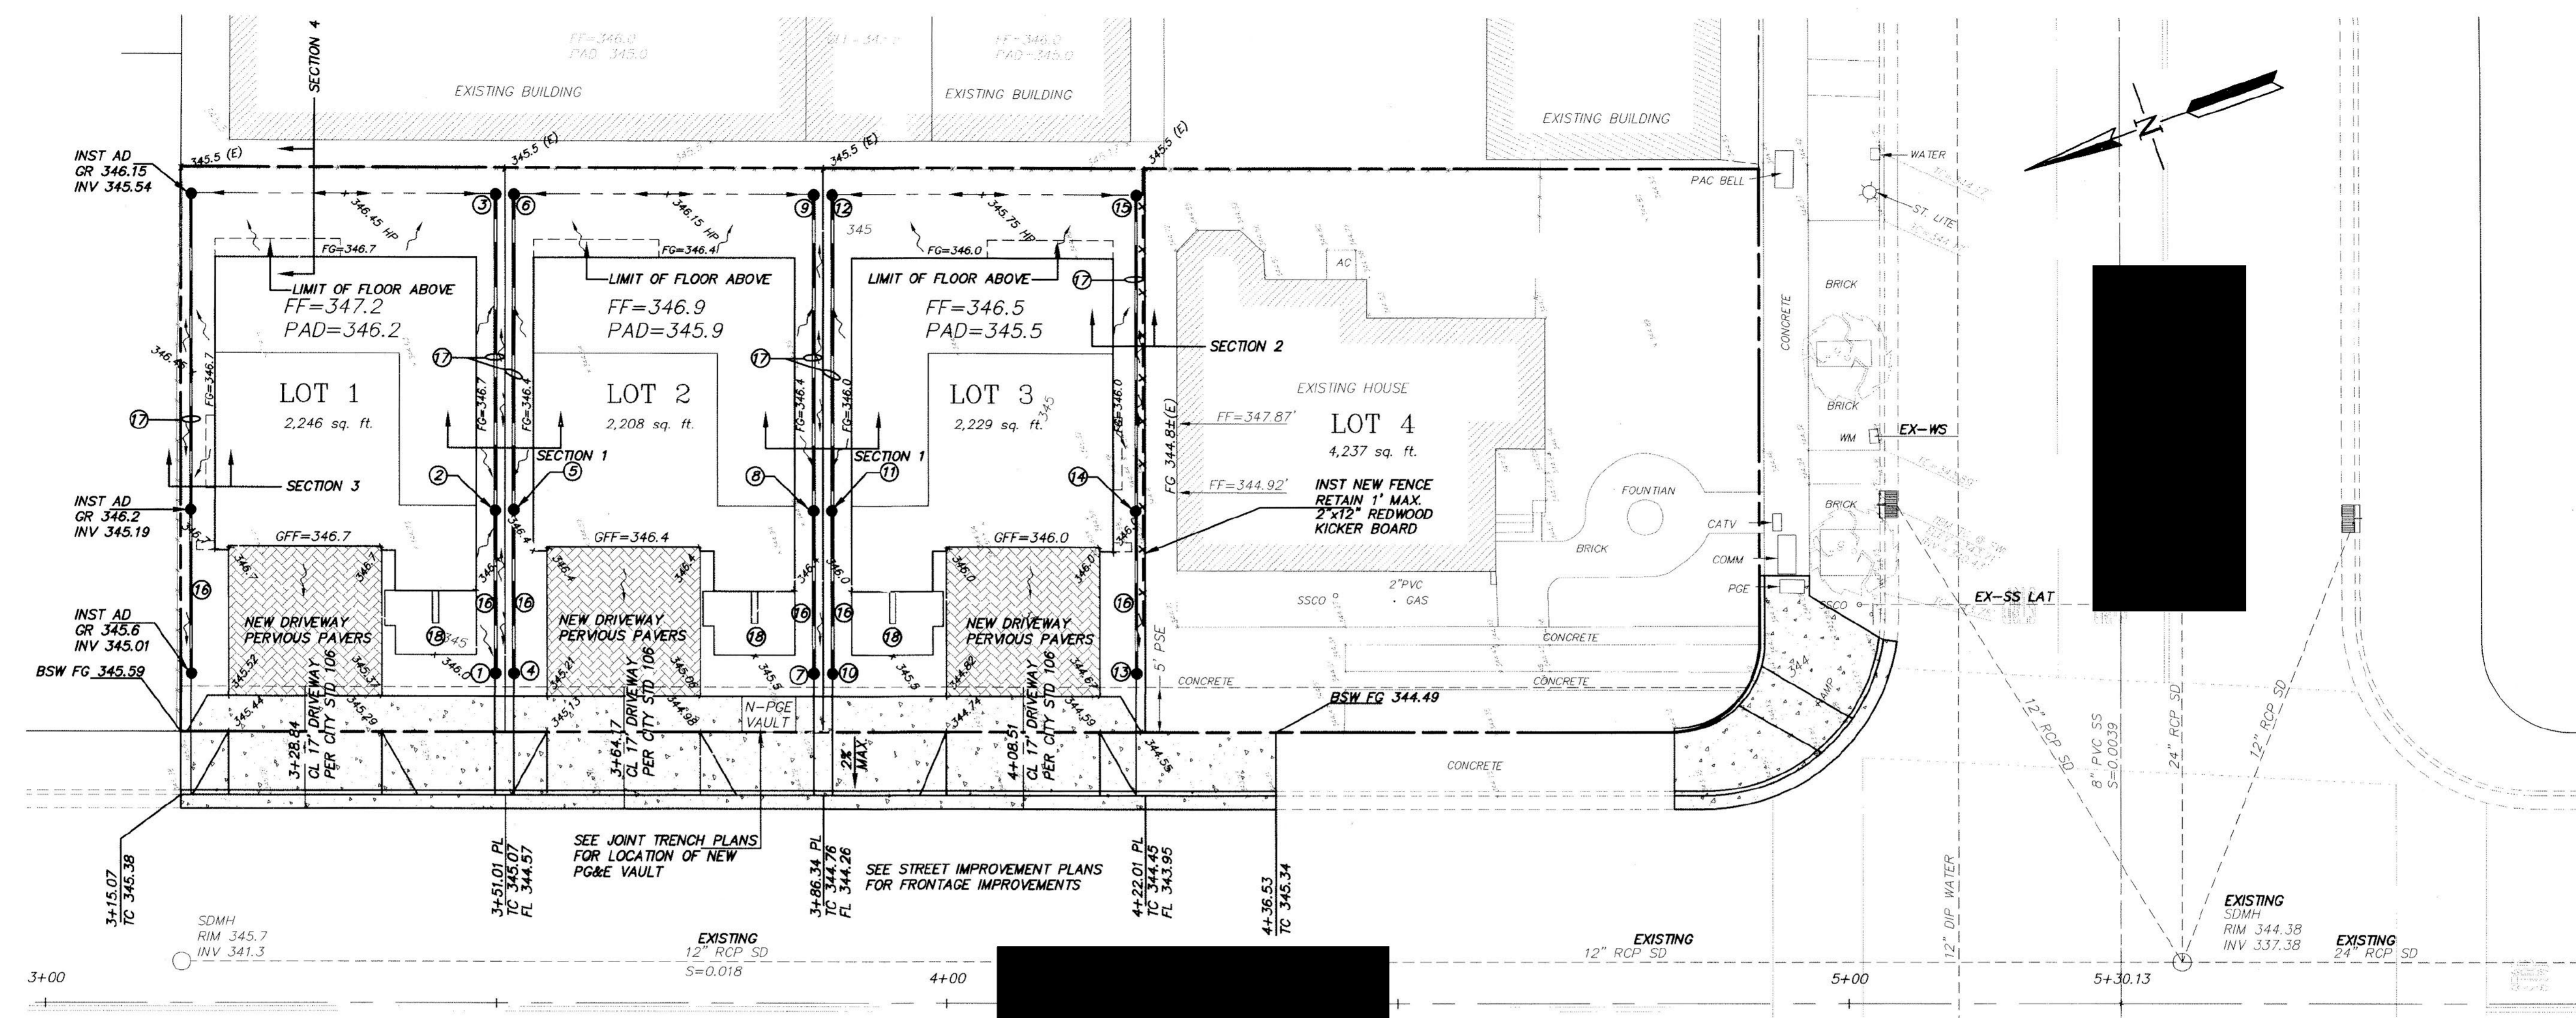

- NOTES**
- PAD TO FINISH FLOOR DISTANCE TO BE VERIFIED BEFORE CONSTRUCTION.
 - SEE LANDSCAPE PLAN FOR ADDITIONAL INFORMATION. THIS PLAN IS INTENDED FOR GRADING AND DRAINAGE.
 - ALL DOWNSPOUTS SHALL HAVE A MINIMUM 3" DIAMETER SOLID DRAIN LINES AND DISCHARGE TO SPLASH BLOCKS.
 - ALL SURFACE WATER SHALL DRAIN AWAY FROM THE STRUCTURE WITH A MINIMUM 5% SLOPE FOR MINIMUM DISTANCE OF 5 FEET FOR LANDSCAPING, AND 1% FOR CONCRETE.
- The following (a) and (b) shall be provided to the building inspector before and foundation inspection will be performed. Item (c) shall be provided before the shear and roof inspection. Item (d) shall be provided before a frame inspection will be performed.
- a. A Licensed Land Surveyor must verify building setbacks to property lines and also pad elevation(s). This verification must be in the form of a professional report, stamped and signed by the registered professional. This report must be submitted to the field inspector at the time of foundation inspection.
- b. When Fill is employed under the building a soils engineer must verify pad compaction. This verification must be in the form of a professional report, stamped and signed by the registered professional. This report must be submitted to the field inspector at the time of foundation inspection.
- c. A Licensed Land Surveyor must verify finish floor elevations. This verification must be in the form of a professional report, stamped and signed by the registered professional. This report must be submitted to the field inspector at the time of shear and roof inspection.
- d. A Licensed Land Surveyor must verify the highest elevation of the highest point of any roof ridge of roof projection. This verification must be in the form of a professional report, stamped and signed by the registered professional. This report must be submitted to the field inspector at the time of frame inspection.

- ABBREVIATIONS**
- AD AREA DRAIN (HANSON P6, P8 OR EQUAL)
 - CO CLEAN-OUT (4" SOLID SDR 35 PVC PIPE WITH CAP)
 - DI DRAIN INLET (HANSON P18 OR EQUAL)
 - BW BOTTOM OF RETAINING WALL
 - FF FINISHED FLOOR
 - FL FLOWLINE
 - FM FORCE MAIN (BY OTHERS)
 - FG FINISHED GRADE
 - FS FINISHED SURFACE
 - GR TOP OF GRATE
 - HP HIGHPOINT
 - INV INVERT
 - OFF GARAGE FINISHED FLOOR
 - SWI STORM WATER INLET
 - TG TO GRADE
 - TW TOP OF RETAINING WALL
 - SS SANITARY SEWER
 - WS WATER SERVICE
 - WM WATER METER
 - JT JOINT TRENCH
 - LS LANDSCAPING
 - DG DECOMPOSED GRANITE

- LEGEND**
- EX CONTOUR
 - PROPERTY LINE
 - STORM DRAIN
 - DRAINAGE ARROW INDICATES DIRECTION OF DRAINAGE

- HATCH LEGEND**
- NEW CONCRETE CURB, GUTTER & SIDEWALK
 - NEW PERVIOUS PAVER DRIVEWAY

PROJECT NAME	GRADING PLAN
DRAWN BY	RD
DESIGNED BY	RD
CHECKED BY	DA
SCALE	1"=10'
DATE	8-21-17
SHEET NO.	C5 OF 7 SHEETS

